



Point Table			
Point #	Northing	Easting	Description
169	24999.95	19265.46	SET CNR
170	24932.75	19364.88	SET CNR
171	24900.02	19420.00	SET CNR
172	24877.90	19405.05	SET CNR
173	24913.74	19352.03	SET CNR
174	24799.63	19327.30	SET CNR
175	24791.87	19306.26	SET CNR
176	24745.22	19347.37	SET CNR
177	24737.46	19326.34	SET CNR
178	24690.89	19282.79	SET CNR
179	24707.26	19227.15	SET CNR
180	24633.09	19205.33	SET CNR
181	24616.71	19260.97	SET CNR
182	24541.64	19230.94	SET CNR
183	24568.17	19179.36	SET CNR
184	24695.75	19394.18	SET CNR
185	24748.77	19430.02	SET CNR
186	24707.27	19491.42	SET CNR
187	24654.25	19455.58	SET CNR
188	24555.86	19507.49	SET CNR
189	24555.52	19571.49	SET CNR
190	24372.28	19570.52	SET CNR
191	24314.28	19570.21	SET CNR
192	24042.75	19568.77	SET CNR
193	24043.09	19504.77	SET CNR
194	23955.28	19494.97	SET CNR
195	23941.49	19557.47	SET CNR
196	23770.11	19519.67	SET CNR
197	23783.89	19457.17	SET CNR
198	23682.63	19445.86	SET CNR
199	23682.29	19509.86	SET CNR
200	23631.82	19445.59	SET CNR
201	23567.80	19448.25	SET CNR
202	23567.49	19506.25	SET CNR
203	23631.48	19509.59	SET CNR
204	23630.70	19656.59	SET CNR
205	23629.90	19806.59	SET CNR

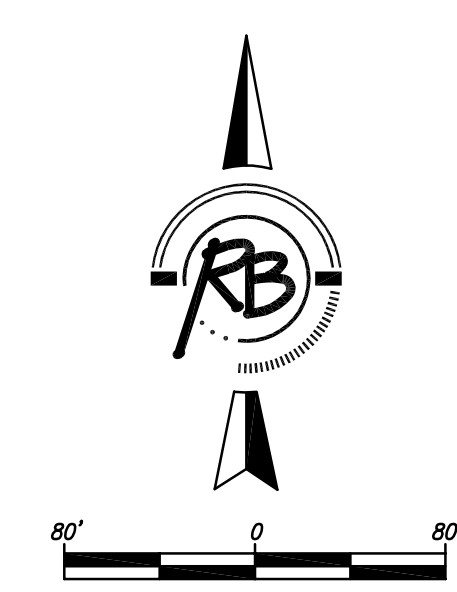

WILLOWCREEK EAST 2ND ADDITION
 ADDITION KEY MAP
 WICHITA, KANSAS

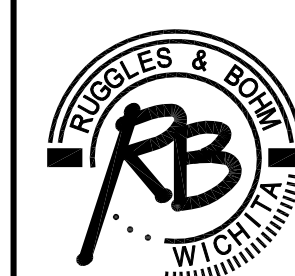

Ruggles & Bohm, P.A.
 Engineering, Surveying, Land Planning
 924 North Main (316) 264-8008
 Wichita, Kansas 67203 (316) 264-4621 fax
 www.rbkansas.com E-mail: info@rbkansas.com

DRAWING FILE: Engineering Base { } PROJECT NUMBER: 472-84764 DATE: 3/12/09

DESIGN	AML	SHEET 21 OF 35
DRAWN	RLS	
REVIEW		
UTILITY		