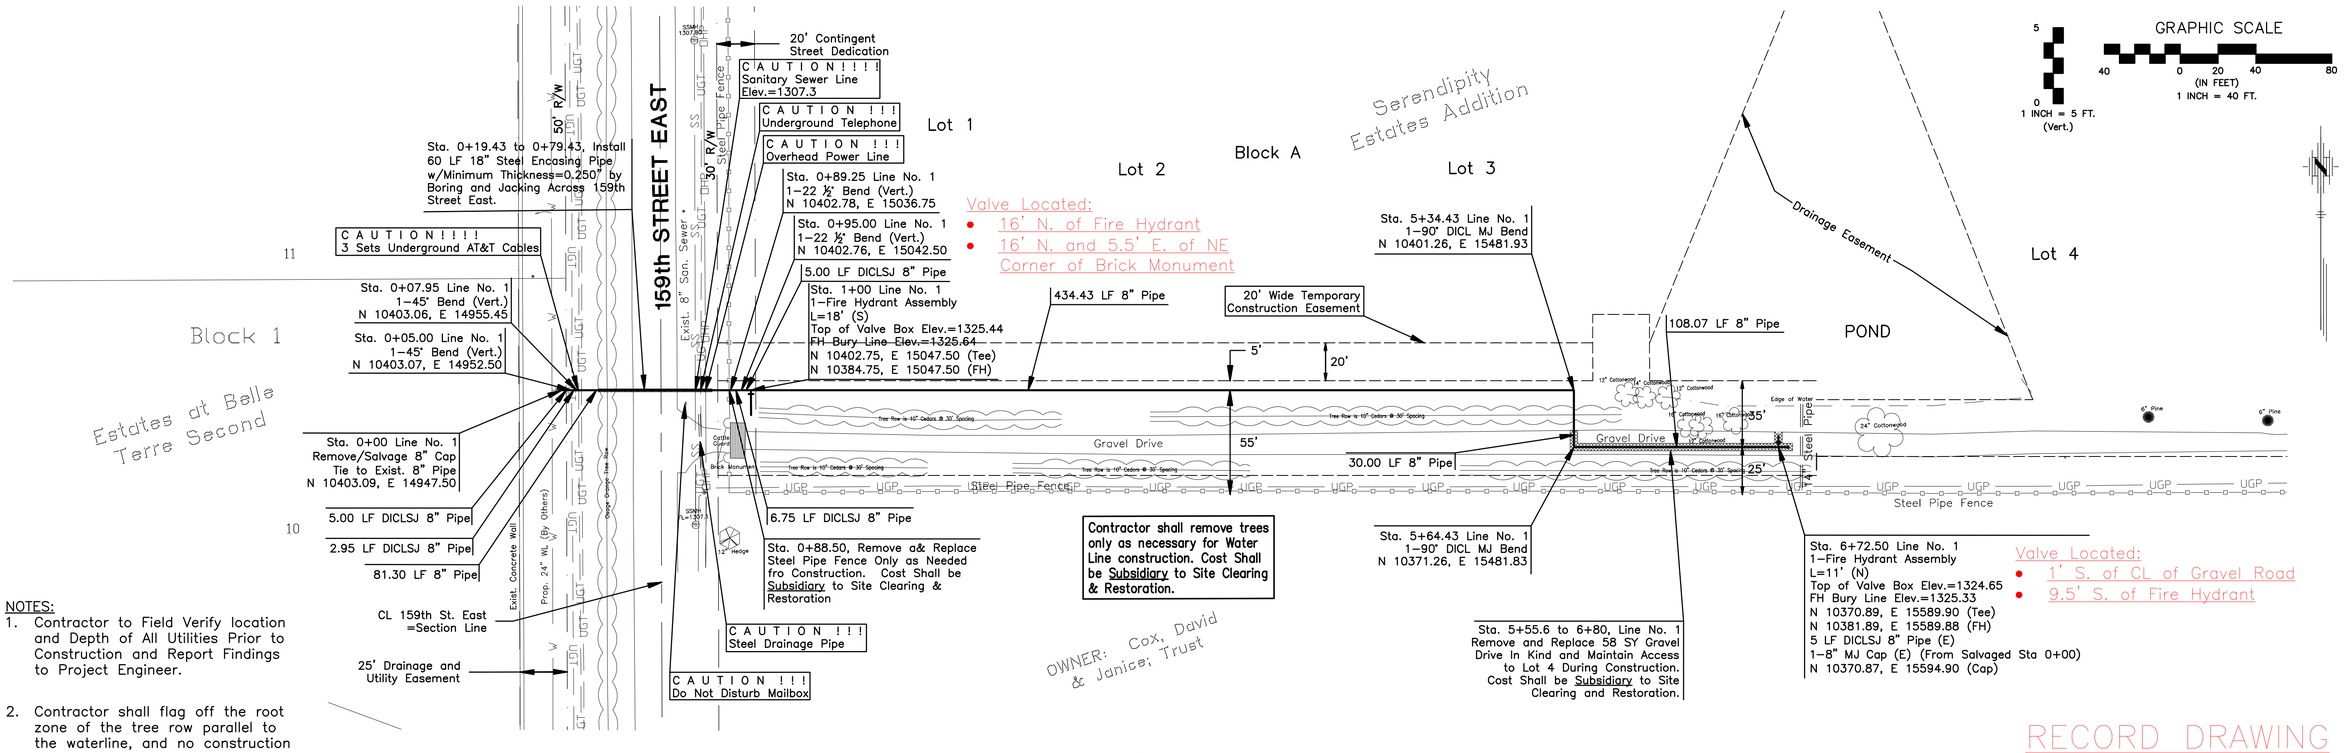

NOTES:

1. Contractor to Field Verify location and Depth of All Utilities Prior to Construction and Report Findings to Project Engineer.
2. Contractor shall flag off the root zone of the tree row parallel to the waterline, and no construction equipment is allowed on the root zone.

RECORD DRAWING
5-8-09

LINE NO. 1

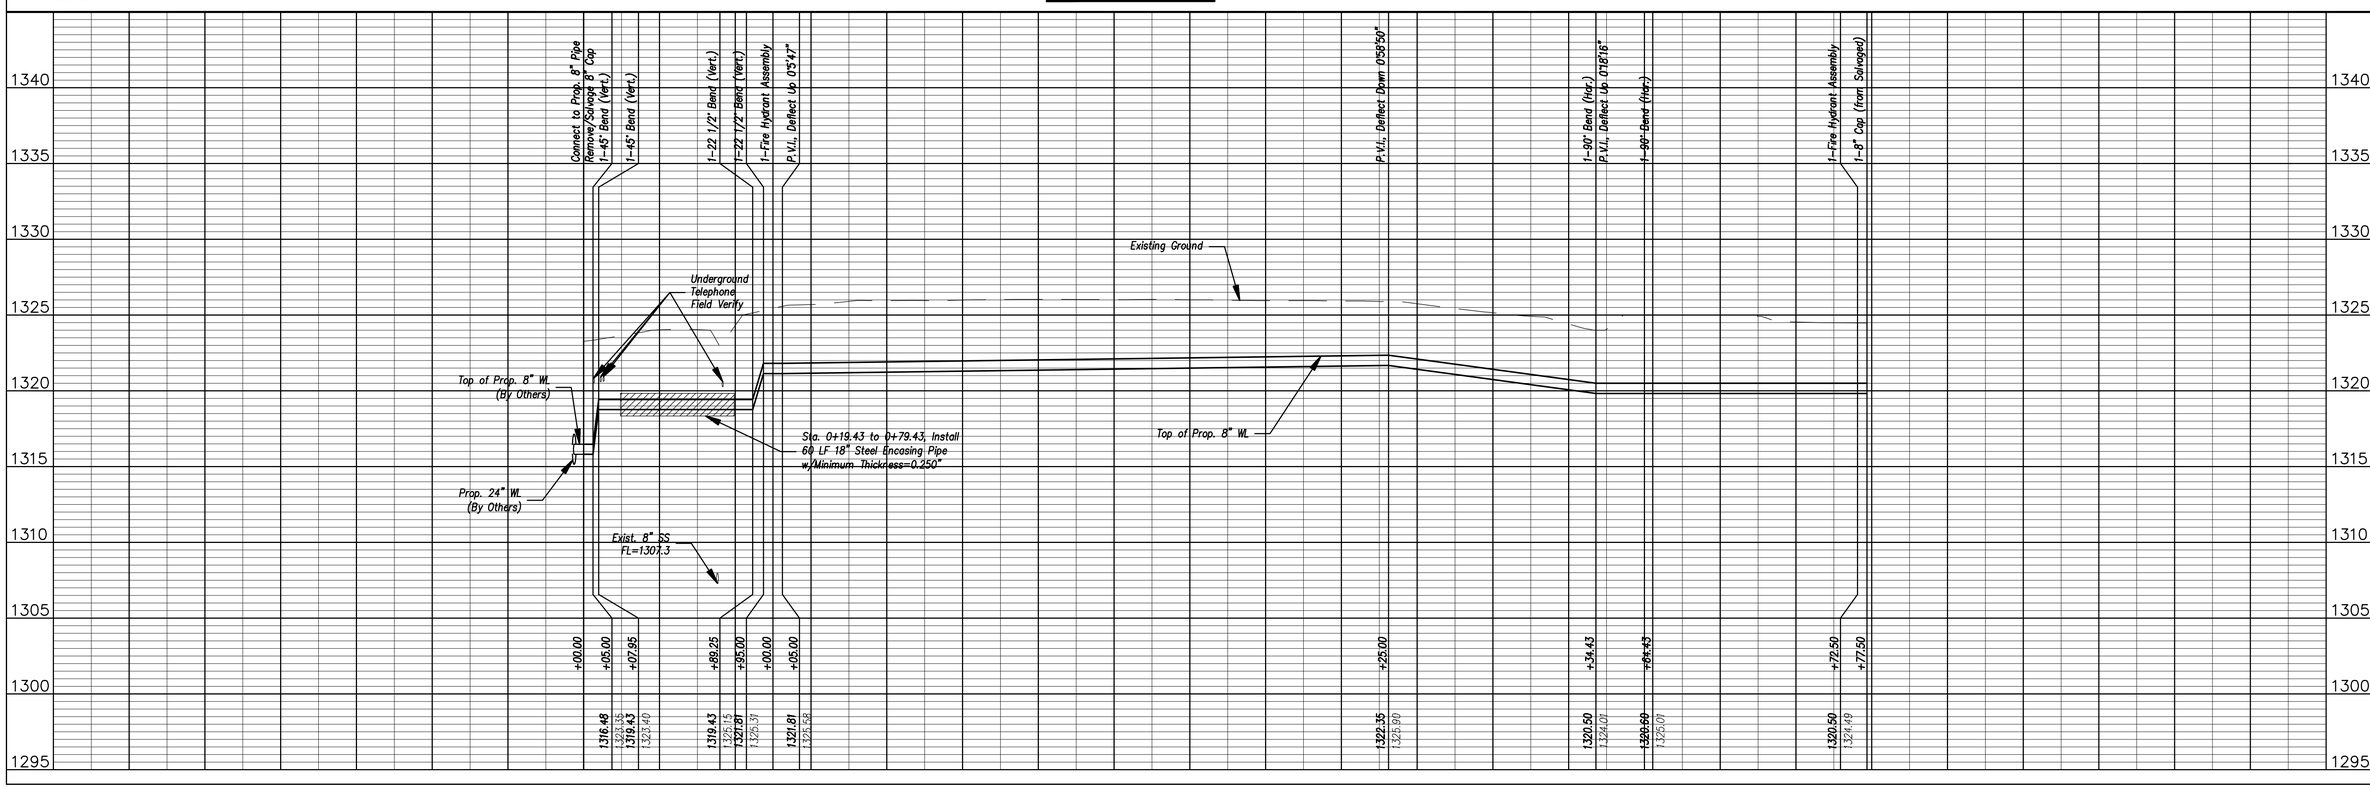

No.	Date	By	Approved	Revision

SERENDIPITY ESTATES ADDITION WATERLINE
WATERLINE NO. 1
CITY OF ANDOVER, KANSAS
JAMES M. THOMPSON, P.E. – CITY ENGINEER
C.O.W. Proj. No. 1358-PPW Index Code 607853

POE & ASSOCIATES, INC.
CONSULTING ENGINEERS
5940 E. Central, Suite 200 ■ Wichita, KS 67208-4242
Phone 316/685-4114 ■ FAX 316/685-4444

FINAL

Designed By: J. Dickman & J. Ubert
Drawn By: M. Tucker
Poe Job No.: 1906A
Date: November 2007