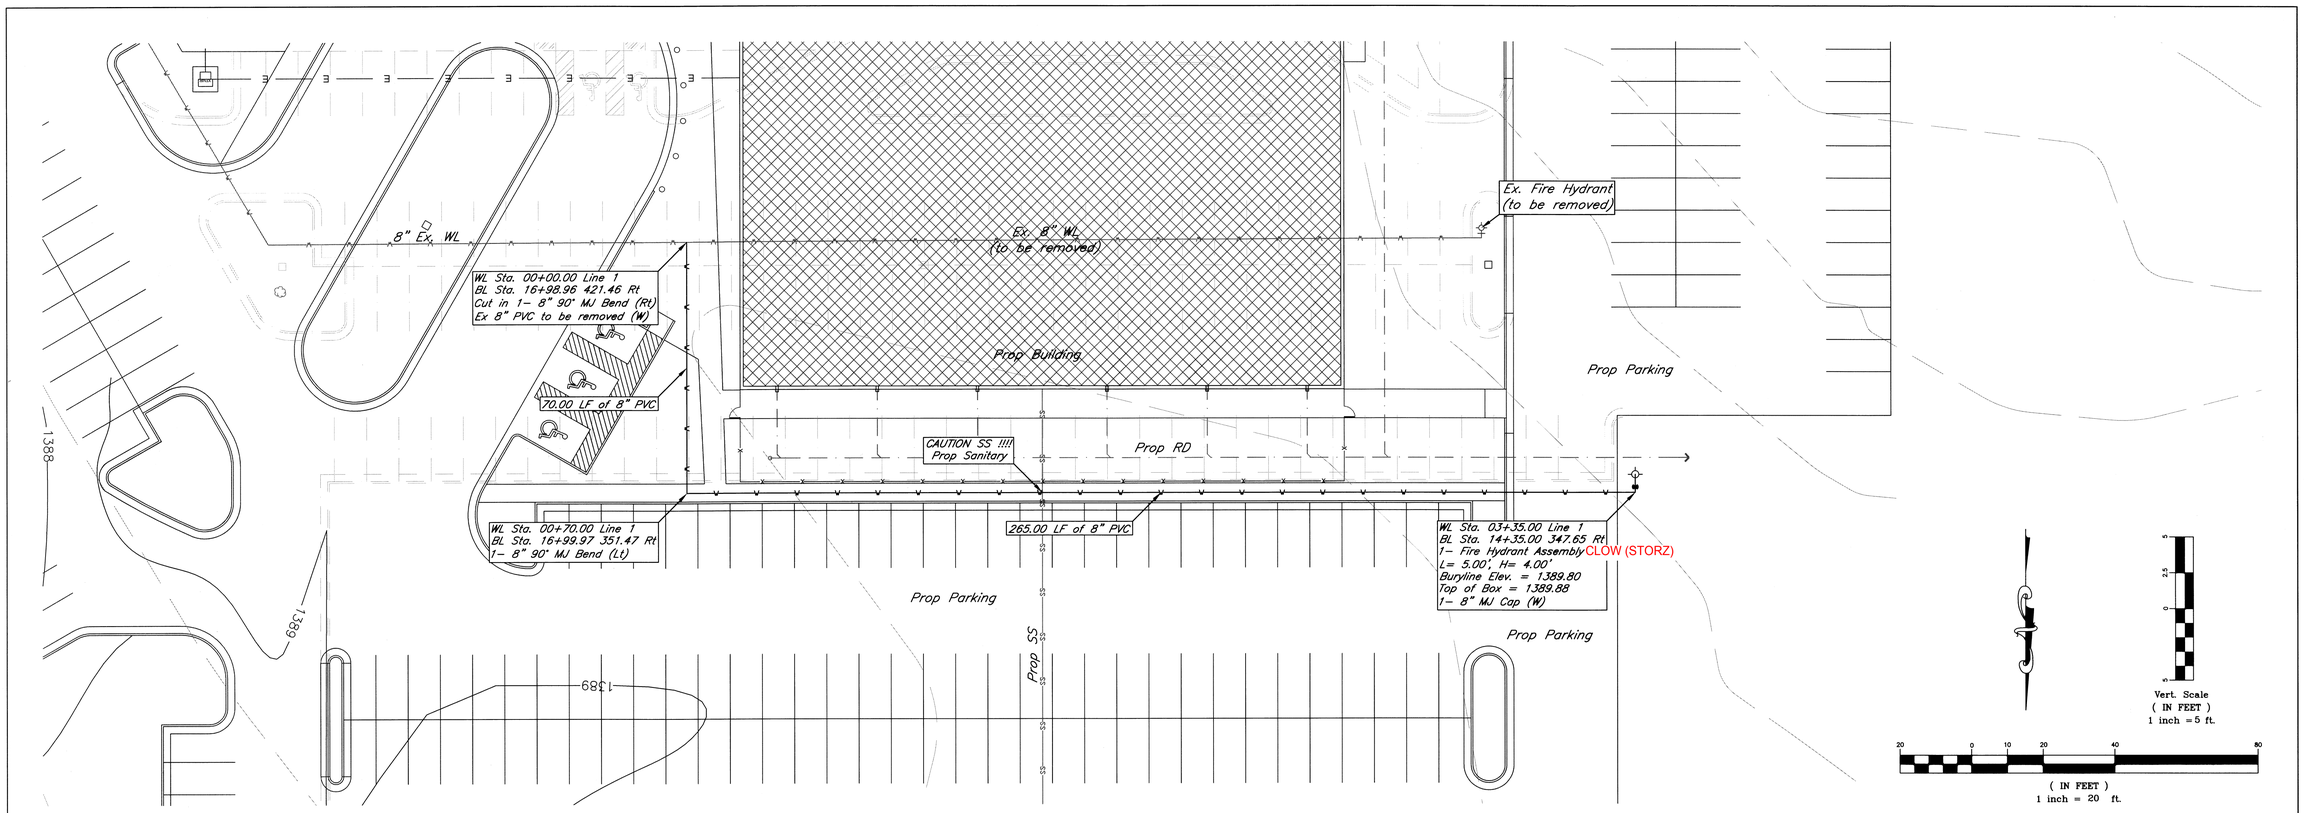

Newspring Church

Line 1

Wichita, Kansas

kemiller engineering

516 S. Market,
Wichita, KS 67202
316/264-0242

PROJECT NUMBER			
KEM NO. 09039	FILE	DATE 04/23/09	SHEET 2
DESIGN KM	DRAWN NS	REVISED 05/12/09	OF 3