

STATE	PROJECT NO.	YEAR	SHEET NO.	SHEETS
KANSAS	87 N-0349-01	2009	21	133

MKEC
ENGINEERING
CONSULTANTS, INC.
411 N. WEBB ROAD
WICHITA, KS. 67206
316-684-9600


**17th STREET
FROM GROVE TO HILLSIDE**

**Storm Line 1
Sta. 26+50
to
Sta. 32+00**
PROJECT NUMBER
87 N-0349-01


DESIGN BY: JRA
DRAWN BY: JSB
CHECKED BY: JRA

ISSUED: June 3, 2009
REVISED:

SHEET NO.
21 of 133

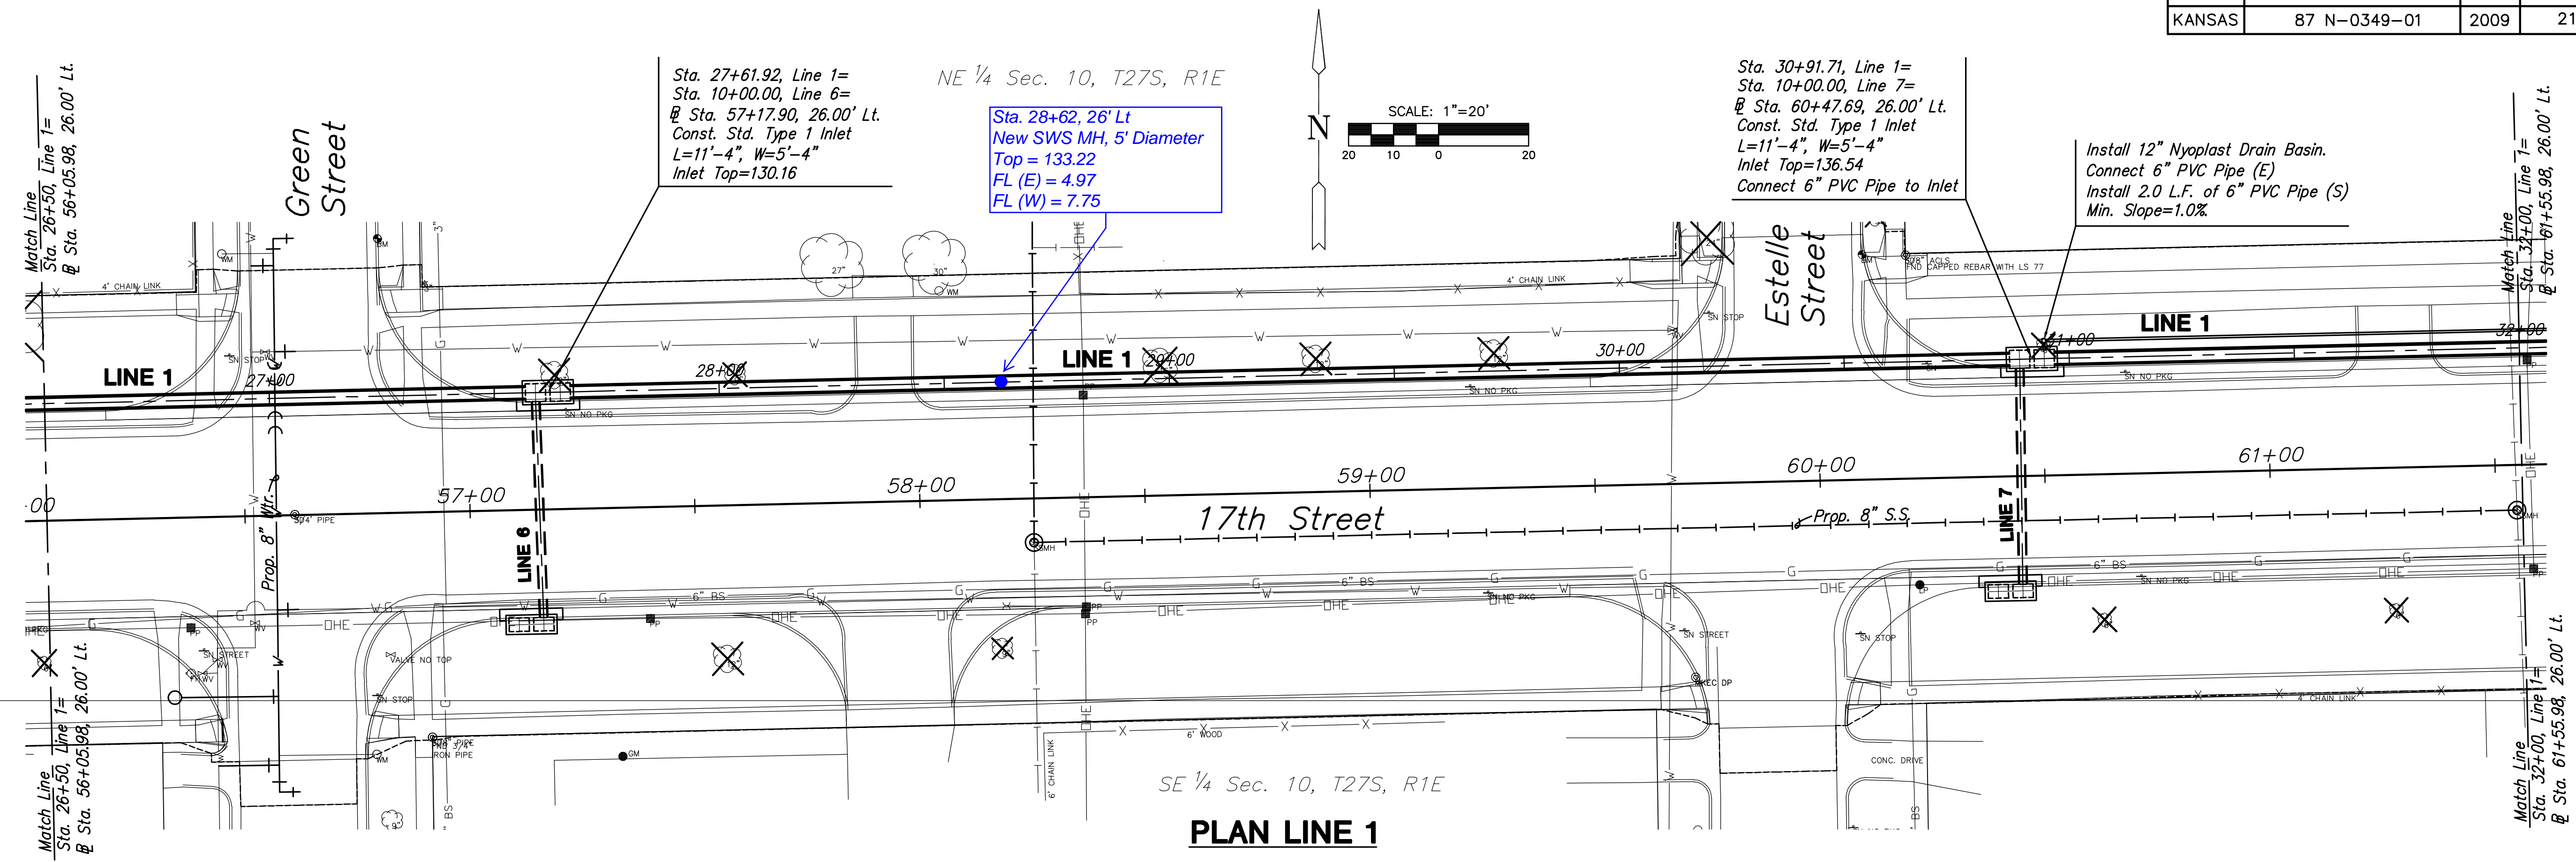

PLAN LINE 1

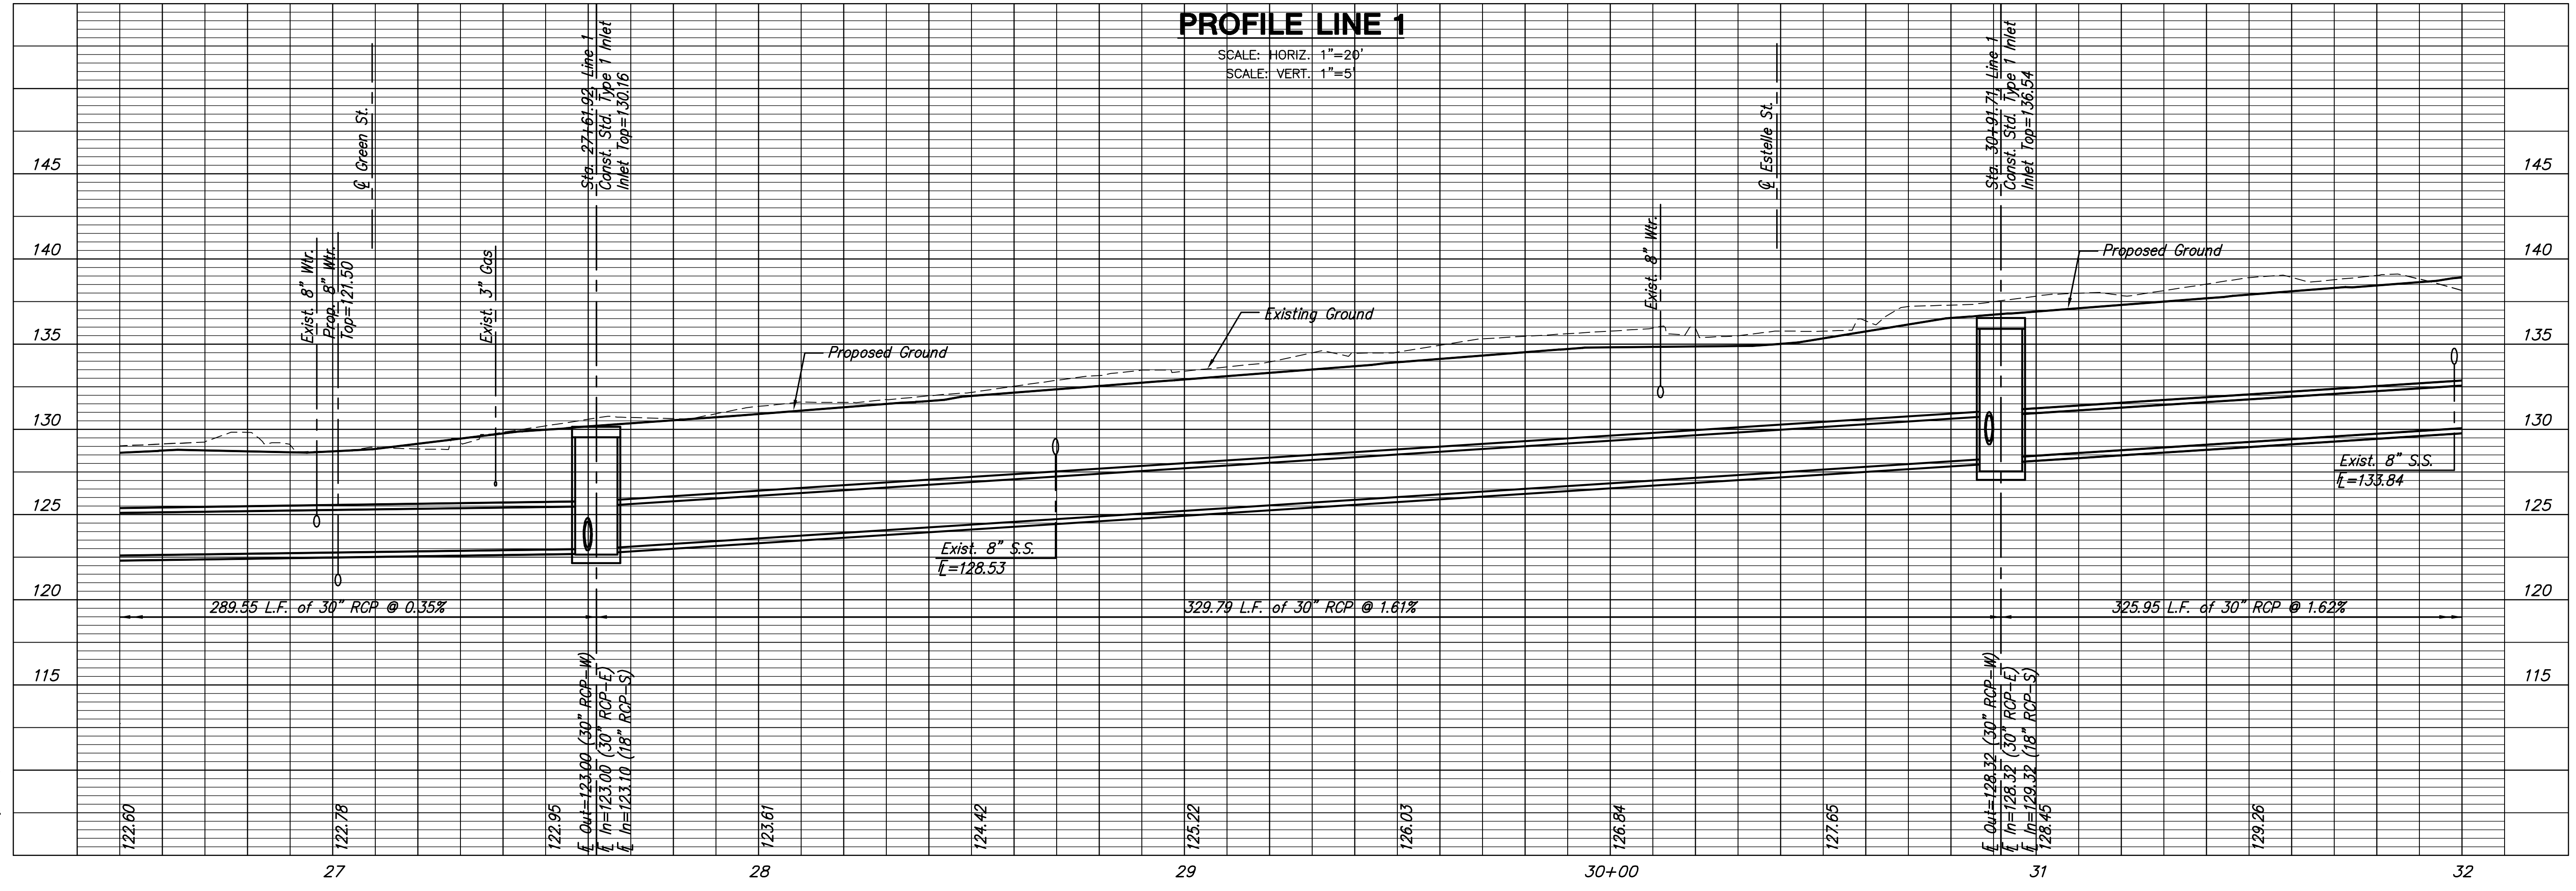

PROFILE LINE 1

PLOT DATE: Wednesday, June 03, 2009 01:58PM

J:\CIVIL\04179\DWG\SWS\04179D4.DWG