

STATE	PROJECT NO.	YEAR	SHEET NO.	SHEETS
KANSAS	87 N-0349-01	2009	22	133

MKEC
ENGINEERING
CONSULTANTS, INC.
411 N. WEBB ROAD
WICHITA, KS. 67206
316-684-9600

**17th STREET
FROM GROVE TO HILLSIDE**


**Storm Line 1
Sta. 32+00
to
Sta. 37+50**
87 N-0349-01
PROJECT NUMBER

DESIGN BY: JRA
DRAWN BY: JSB
CHECKED BY: JRA


ISSUED: May 28, 2009
REVISED:

SHEET NO.
22 of 133

Note: Inlet changed to type 2 in order to fit in front of existing 20" WL.

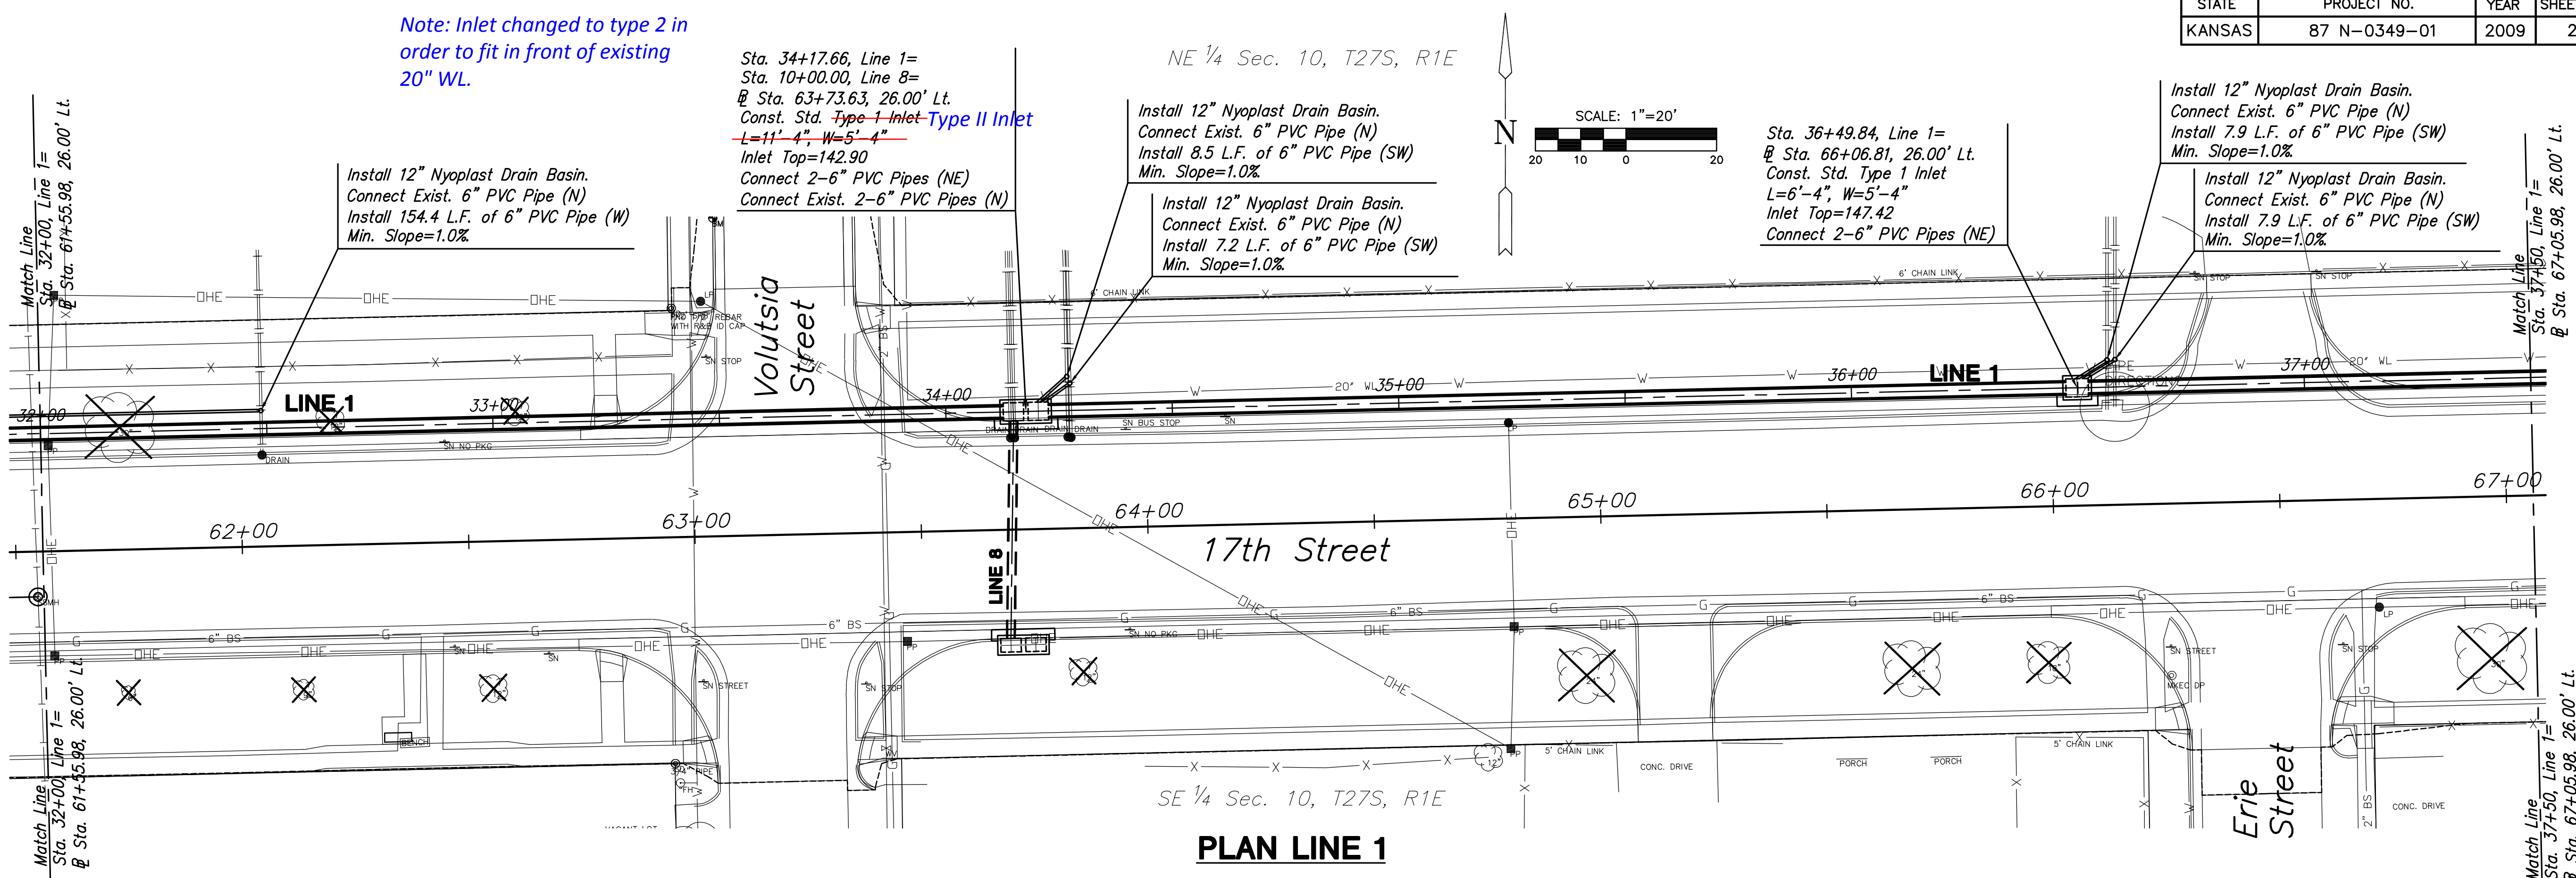

PLAN LINE 1

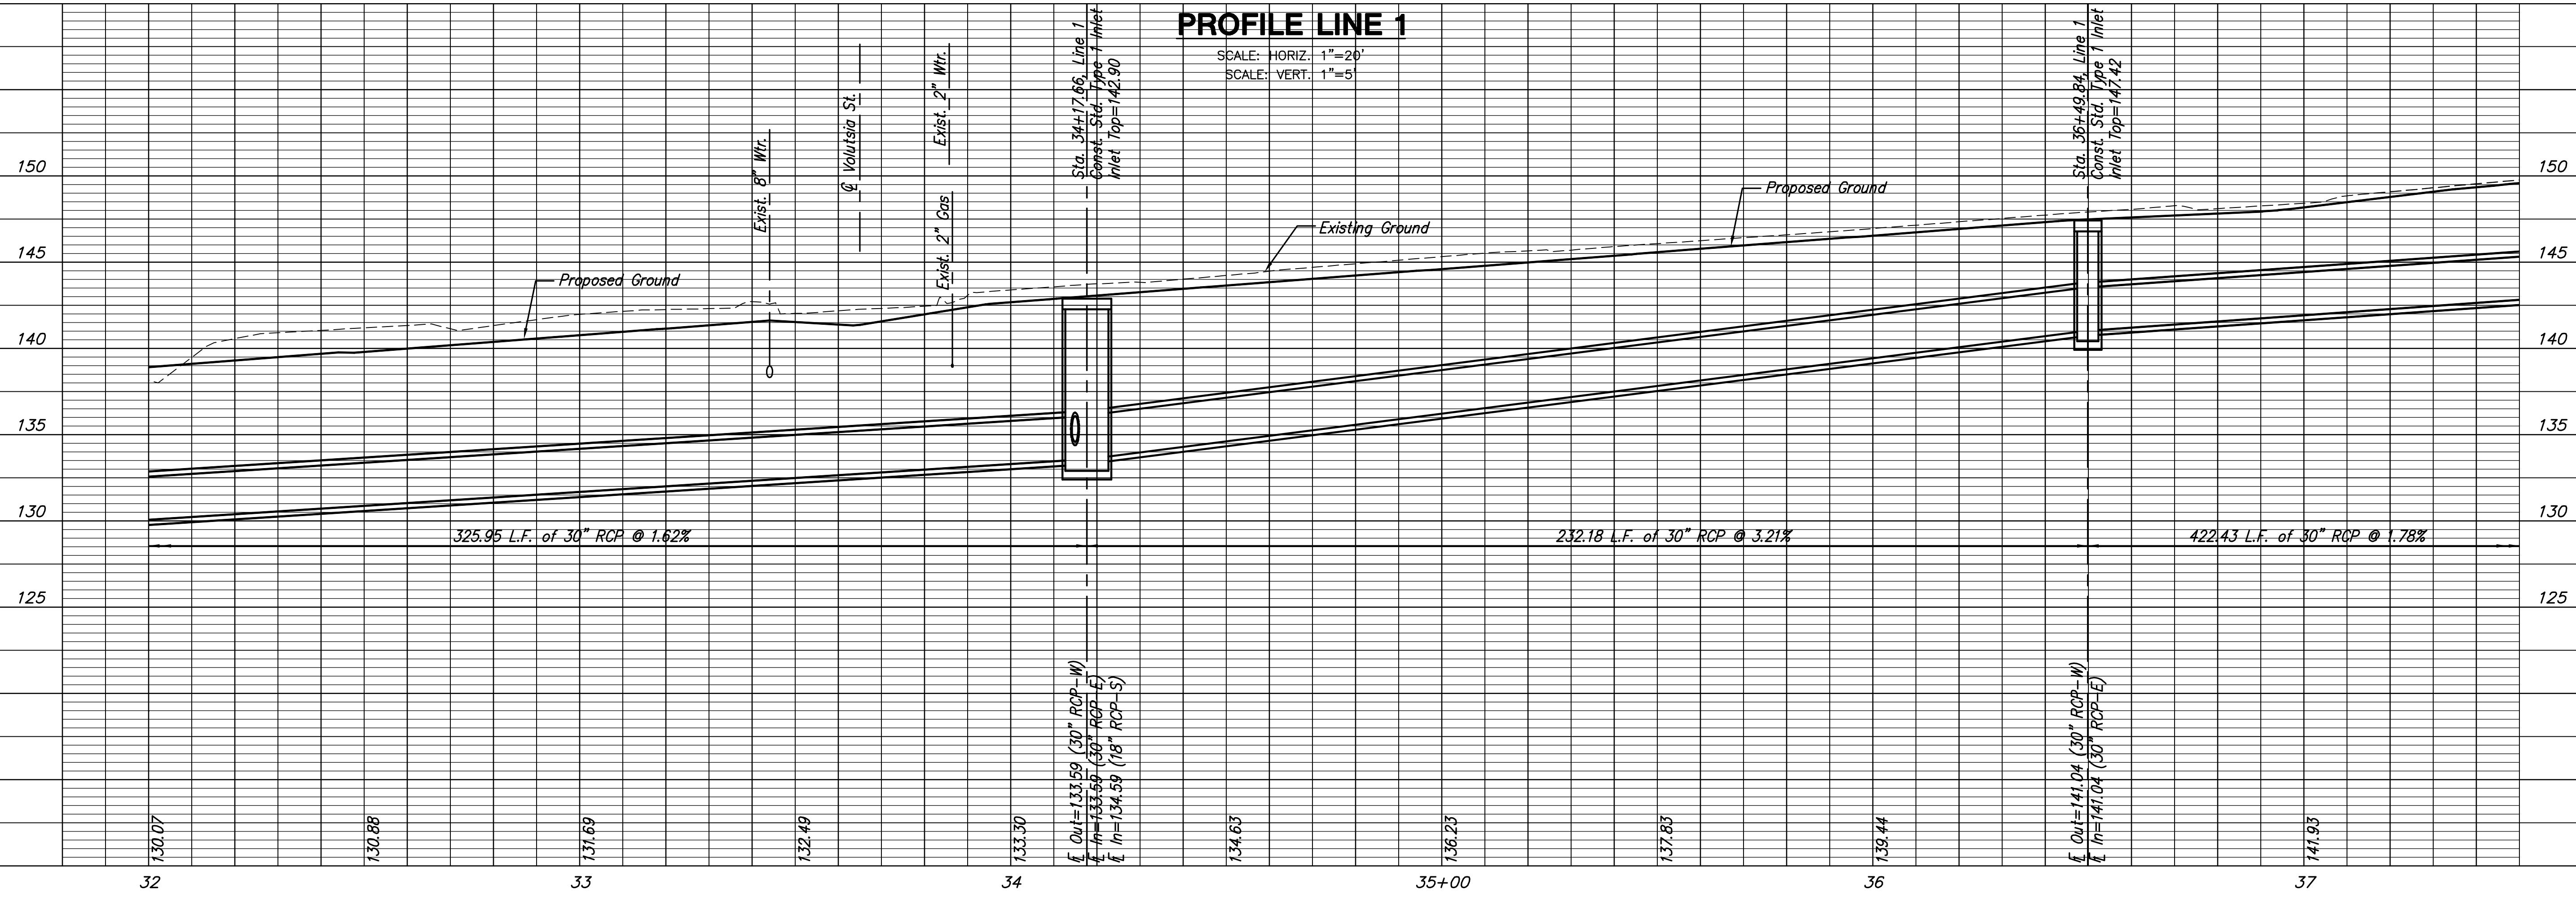

PROFILE LINE 1

PLOT: Thursday, May 28, 2009 10:32AM

J:\CIVIL\04179\WORK\SWS\0417905.DWG