

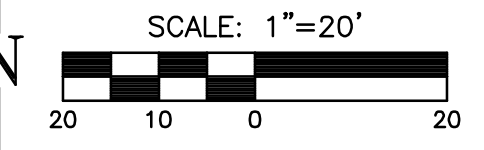


STATE	PROJECT NO.	YEAR	SHEET NO.	SHEETS
KANSAS	87 N-0349-01	2009	24	133

MKEC
ENGINEERING
CONSULTANTS, INC.
411 N. WEBB ROAD
WICHITA, KS. 67206
316-684-9600

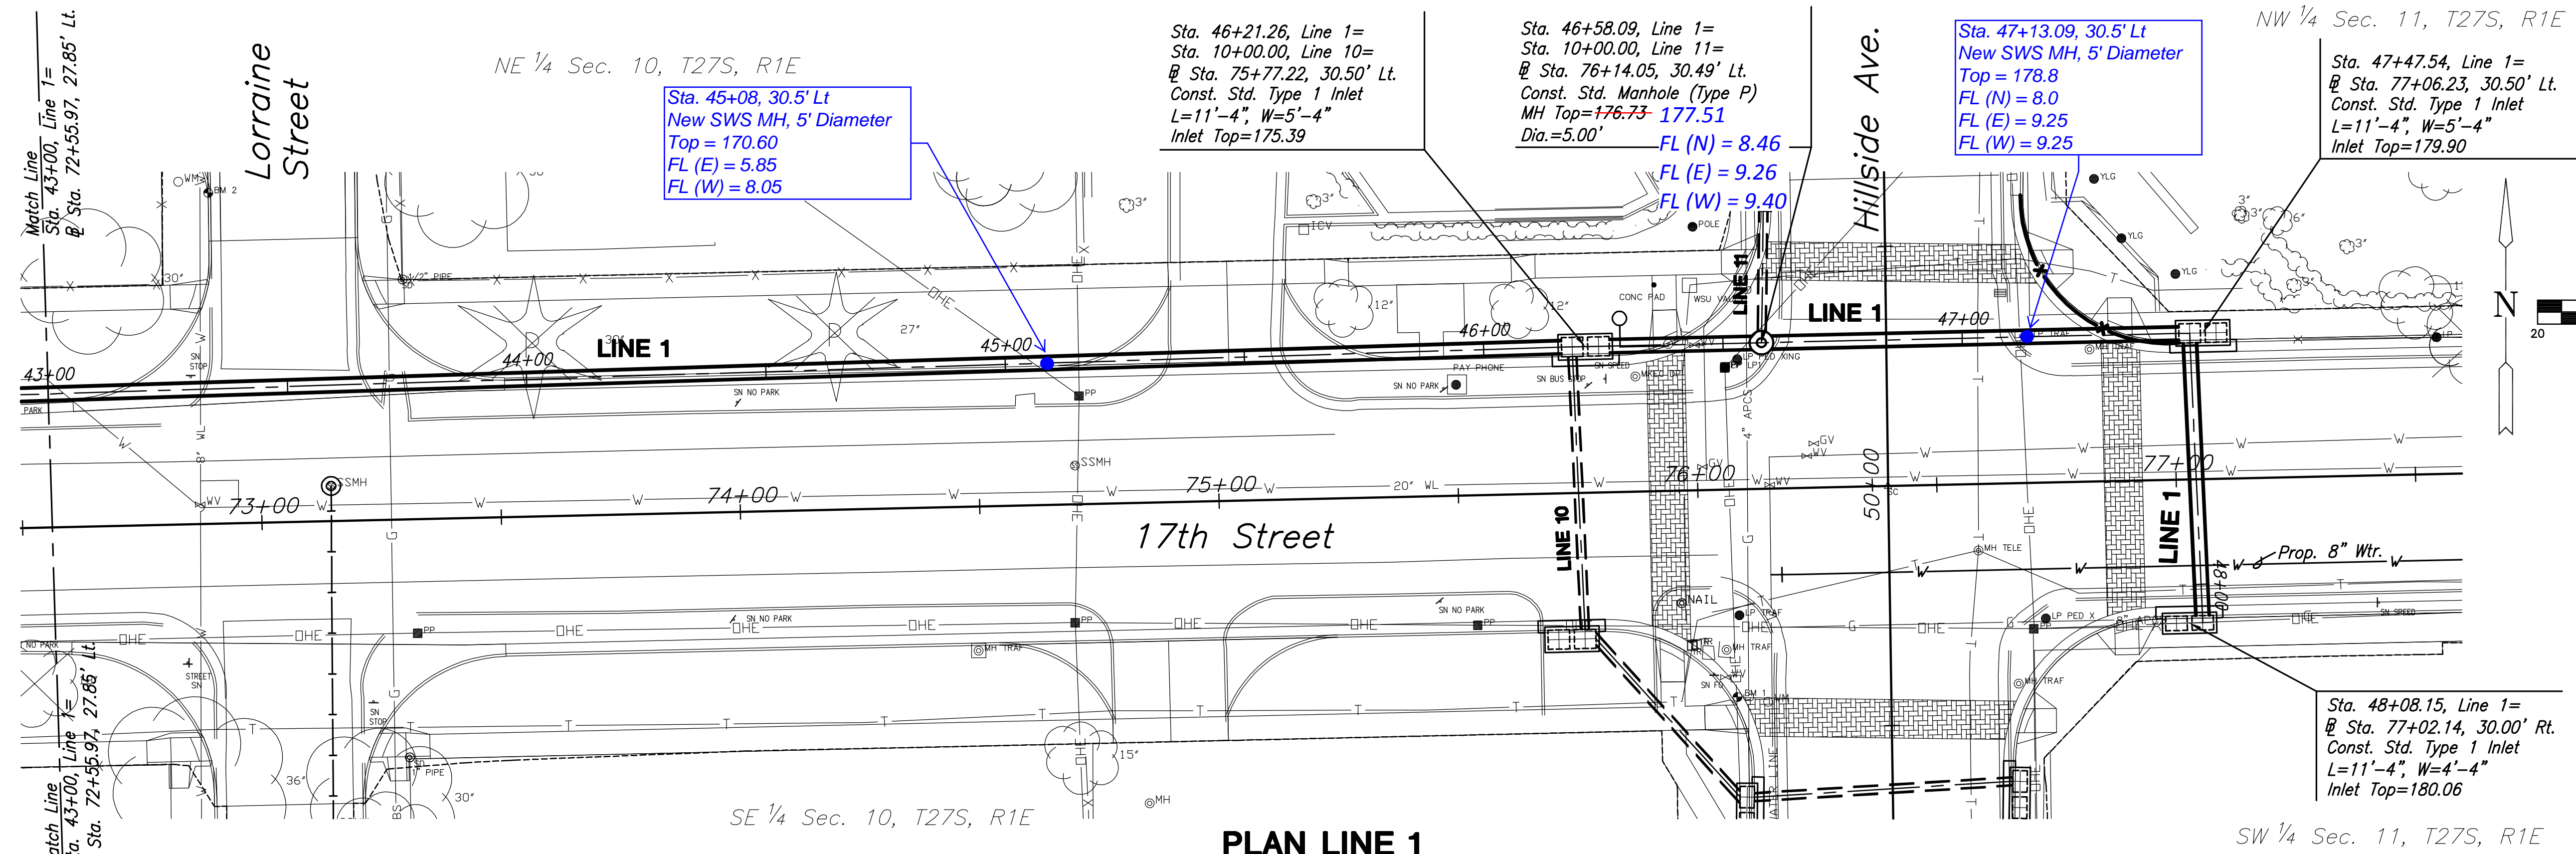

PLAN LINE 1

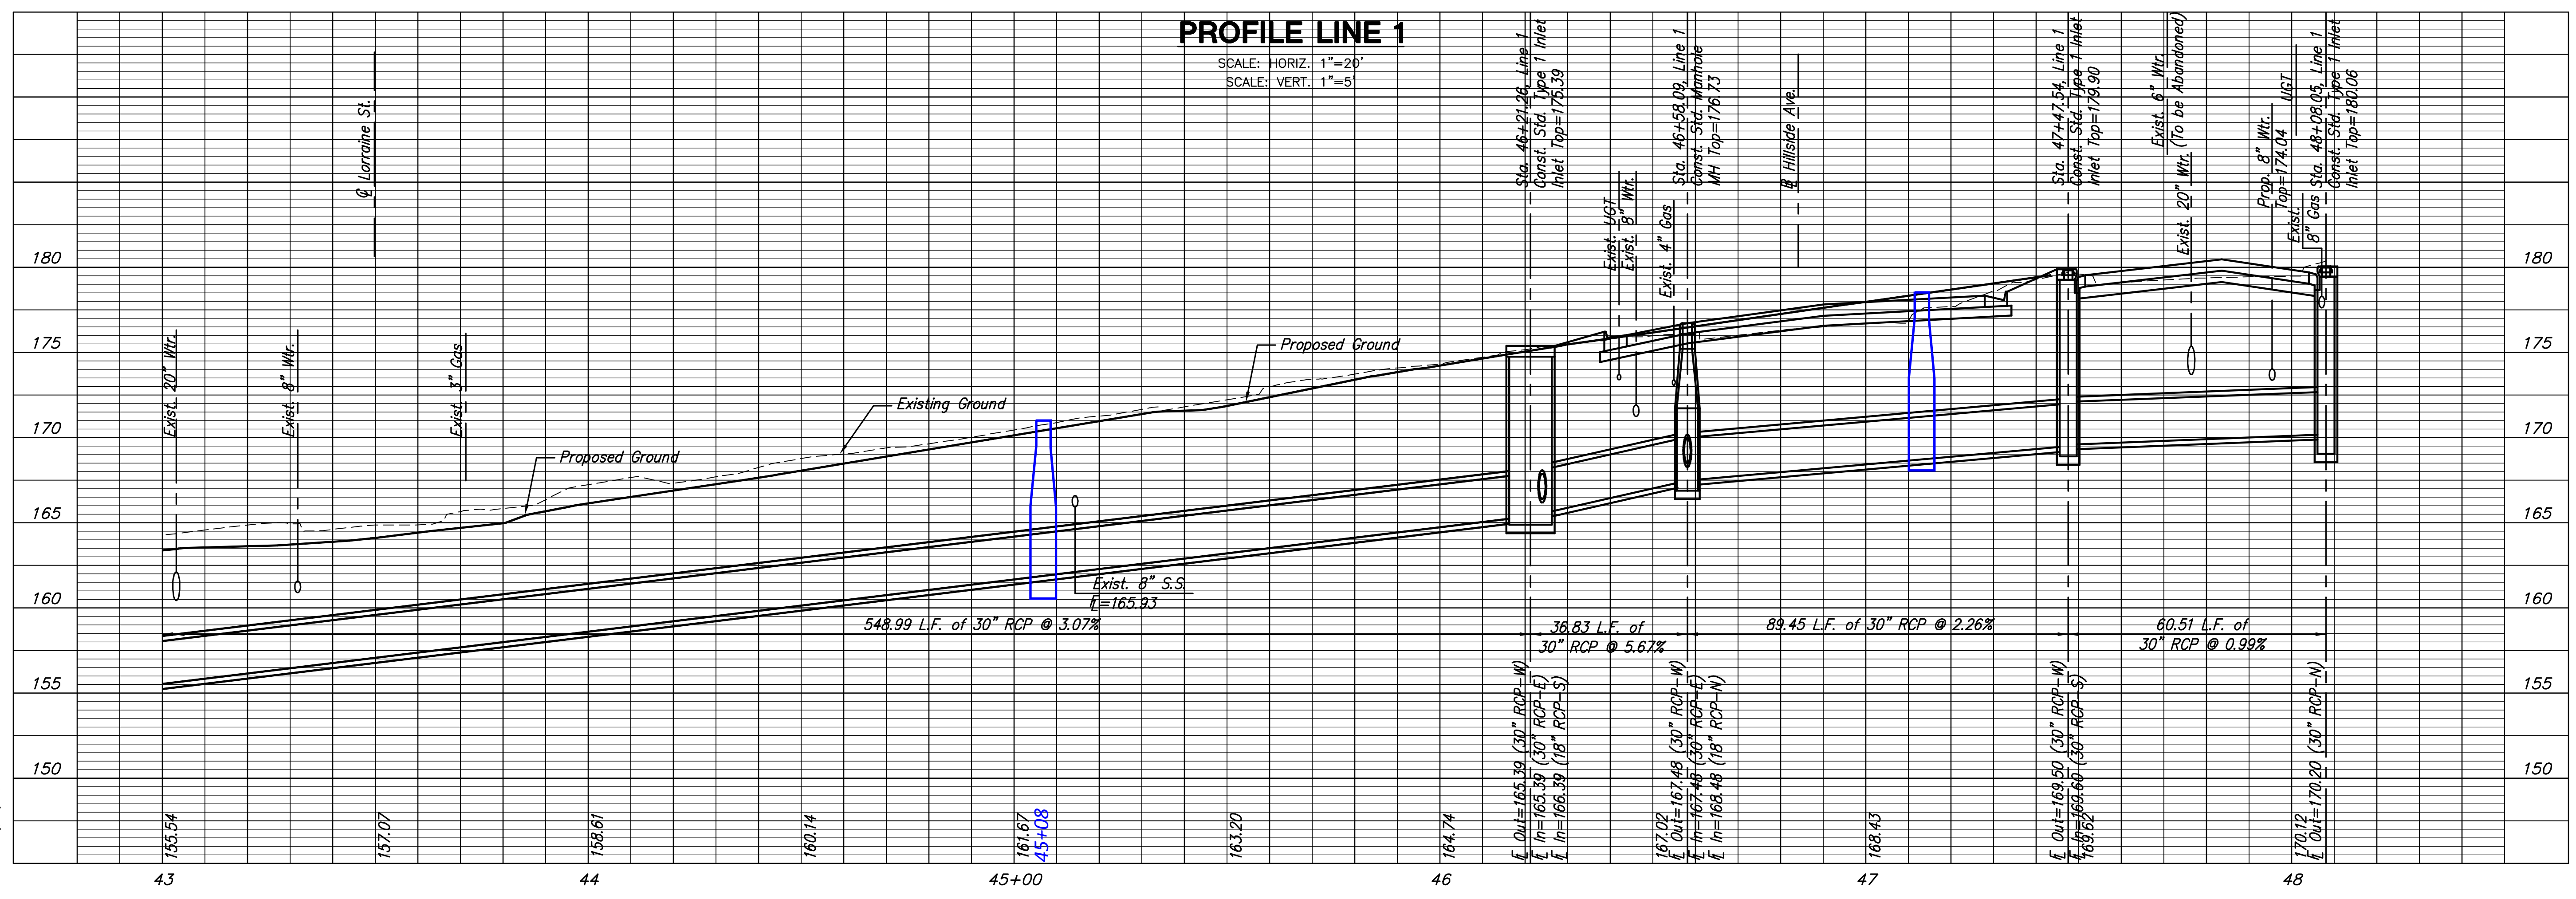

PROFILE LINE 1

SCALE: HORIZ. 1"=20'
SCALE: VERT. 1"=5'

**17th STREET
FROM GROVE TO HILLSIDE**

**Storm Line 1
Sta. 43+00
to
Sta. 48+08.31**
SHEET TITLE
87 N-0349-01
PROJECT NUMBER

DESIGN BY: JRA
DRAWN BY: JSB
CHECKED BY: JRA

ISSUED: May 28, 2009
REVISED:

SHEET NO.
24 of 133

PLOTTED: Thursday, May 28, 2009 @ 10:32AM

J:\DWG\04179\DWG\SWS\0417907.DWG