P:\Projects\Projects 2006-3268\3268E (Sierra Hills 2nd Addition)\Water.dwg, Water Line 2 (3), 6/9/2009 10:31:30 AM, eric_g

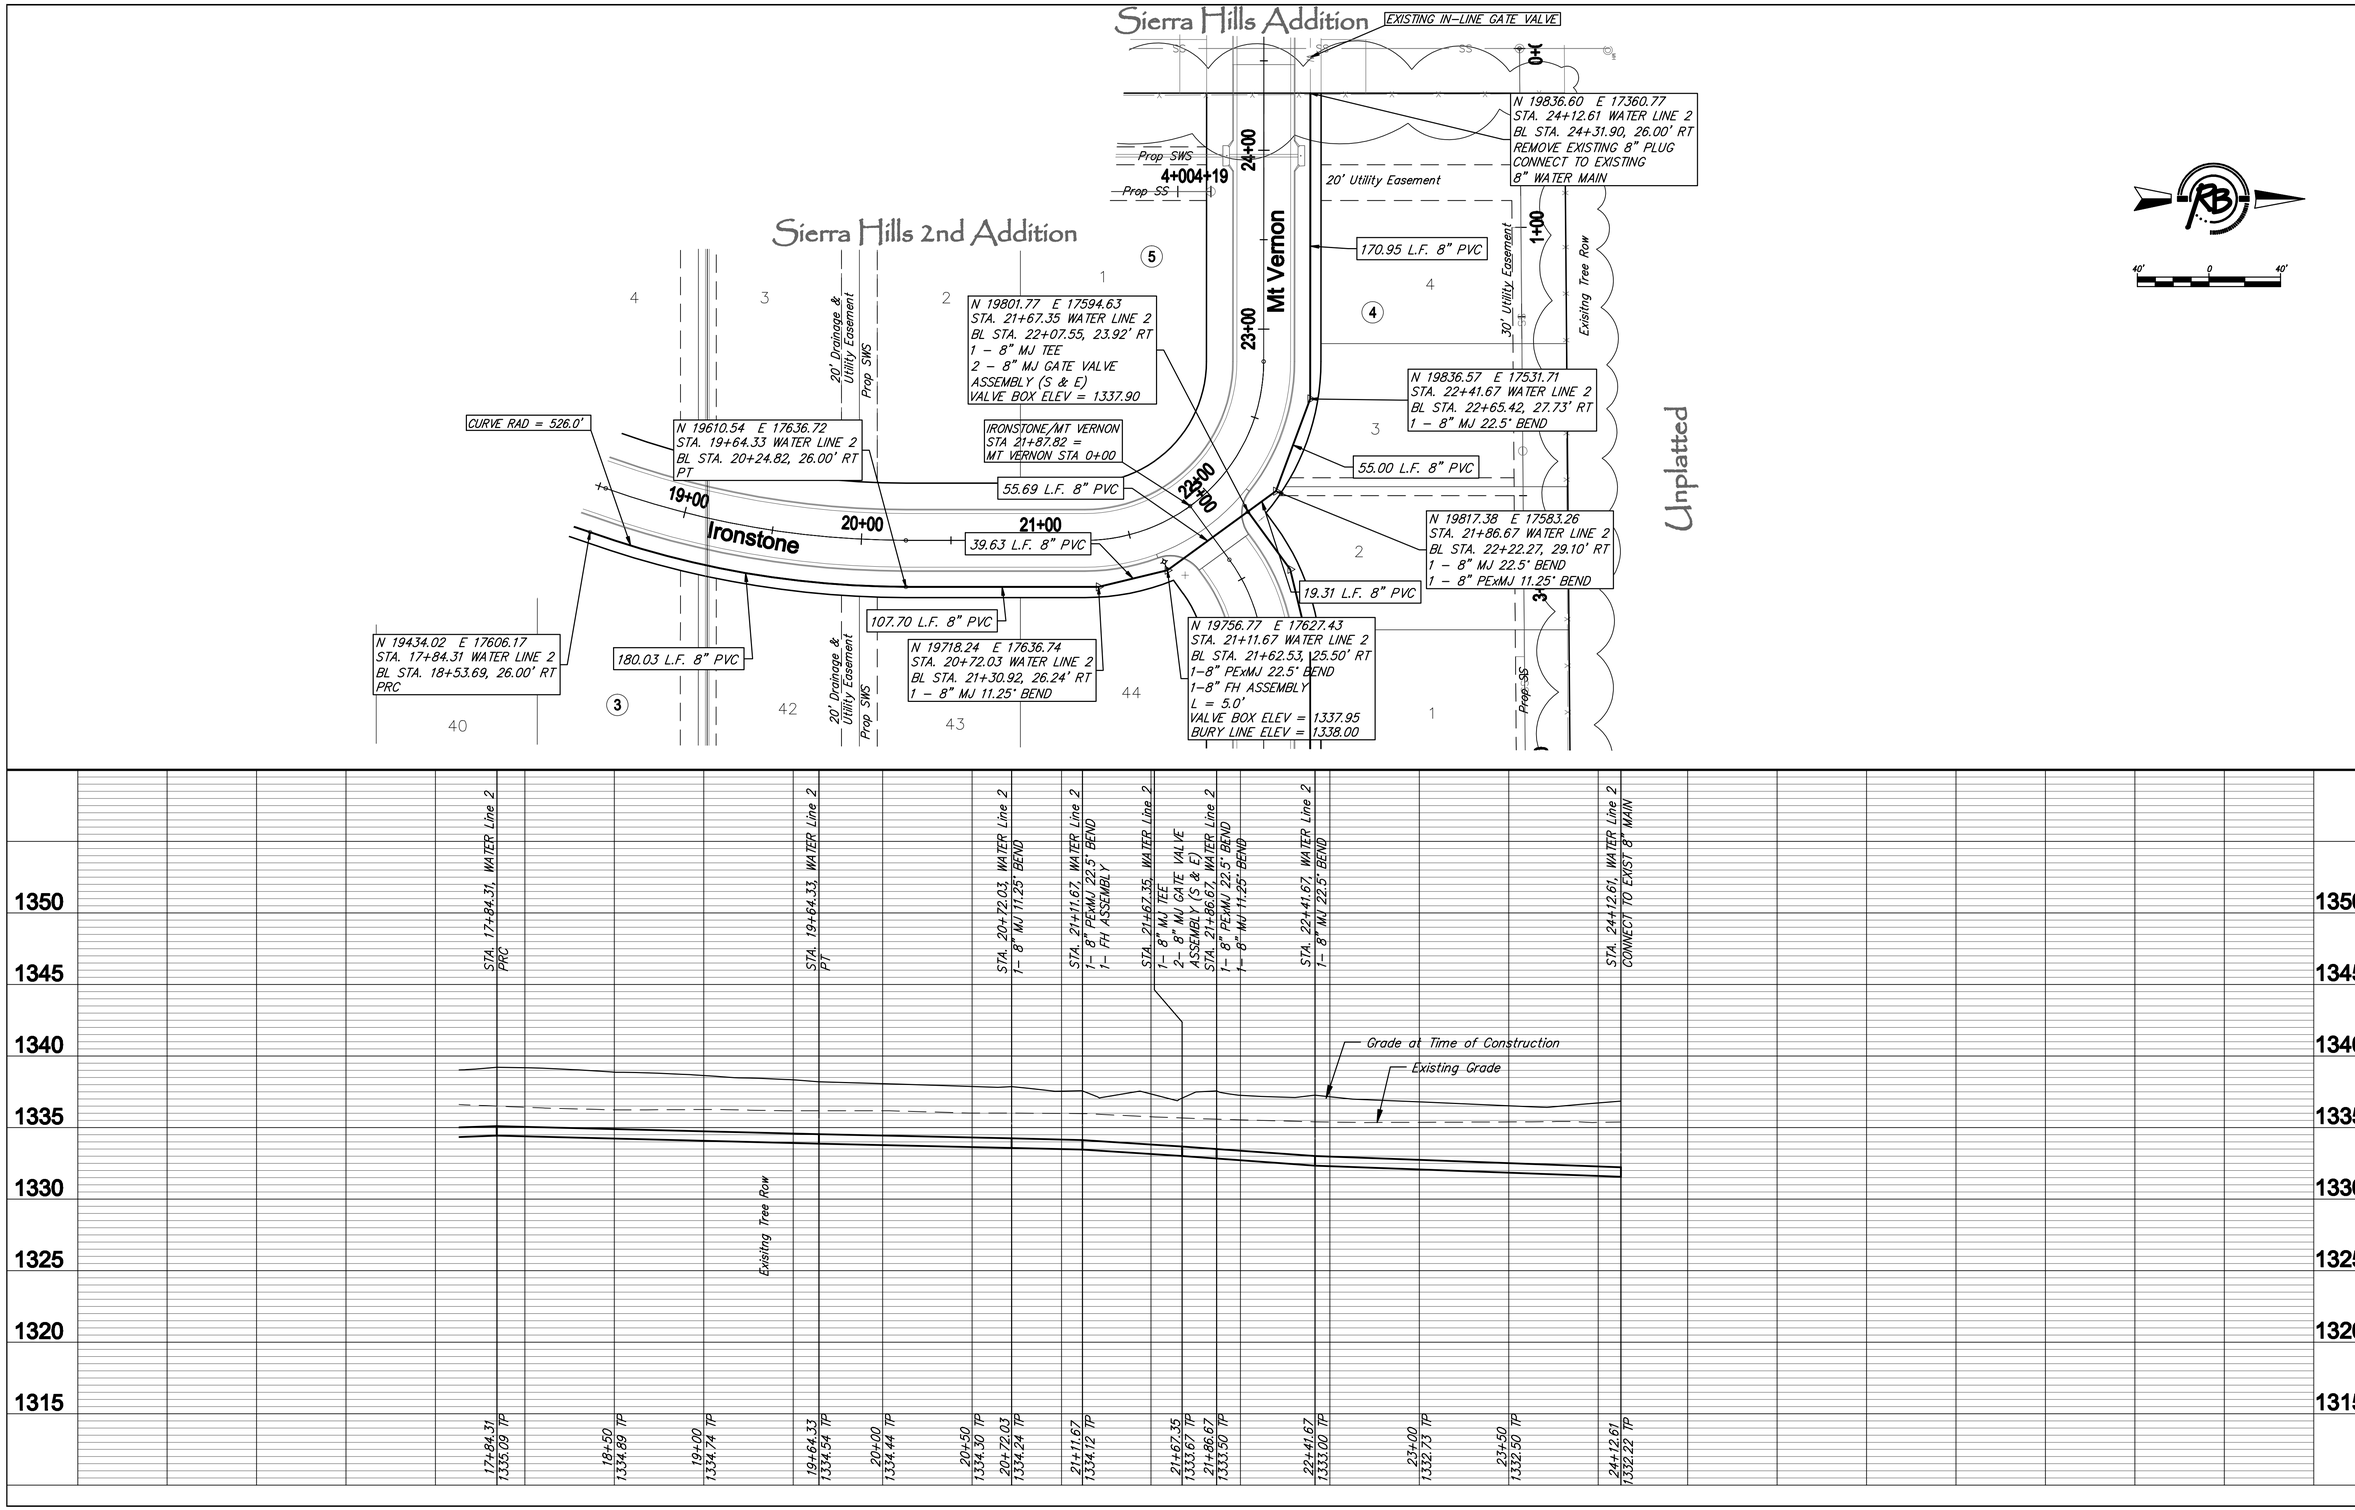

Ruggles & Bailey, P.A.
Engineering, Surveying, Land Planning
Phone (316) 262-2691
Fax (316) 262-1799
Wichita, Kansas 67202
www.ruggles-bailey.com

DRAWN EJG
DESIGNED EJG
CHECKED
APPROVED
DATE July 10, 2008
SCALE ----

PROJECT NUMBER 446-90389
DRAWING FILE Water (Water Line 2 (3))

PAVING IMPROVEMENTS
Water Line 2 (3)
WICHITA, KANSAS

3268E

4
13