

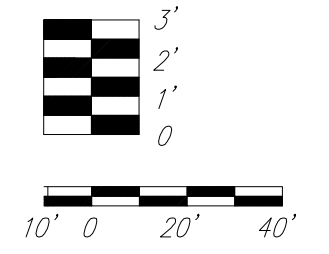
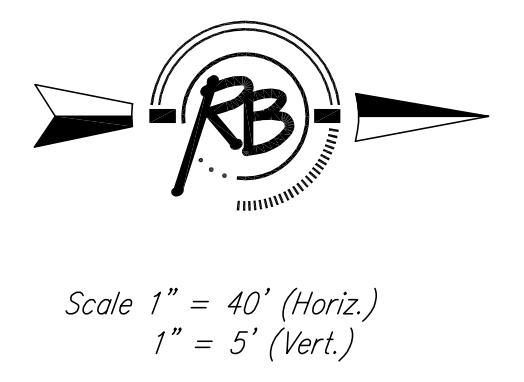


NE 1/4, SEC. 29, T 26 S, R 1 E

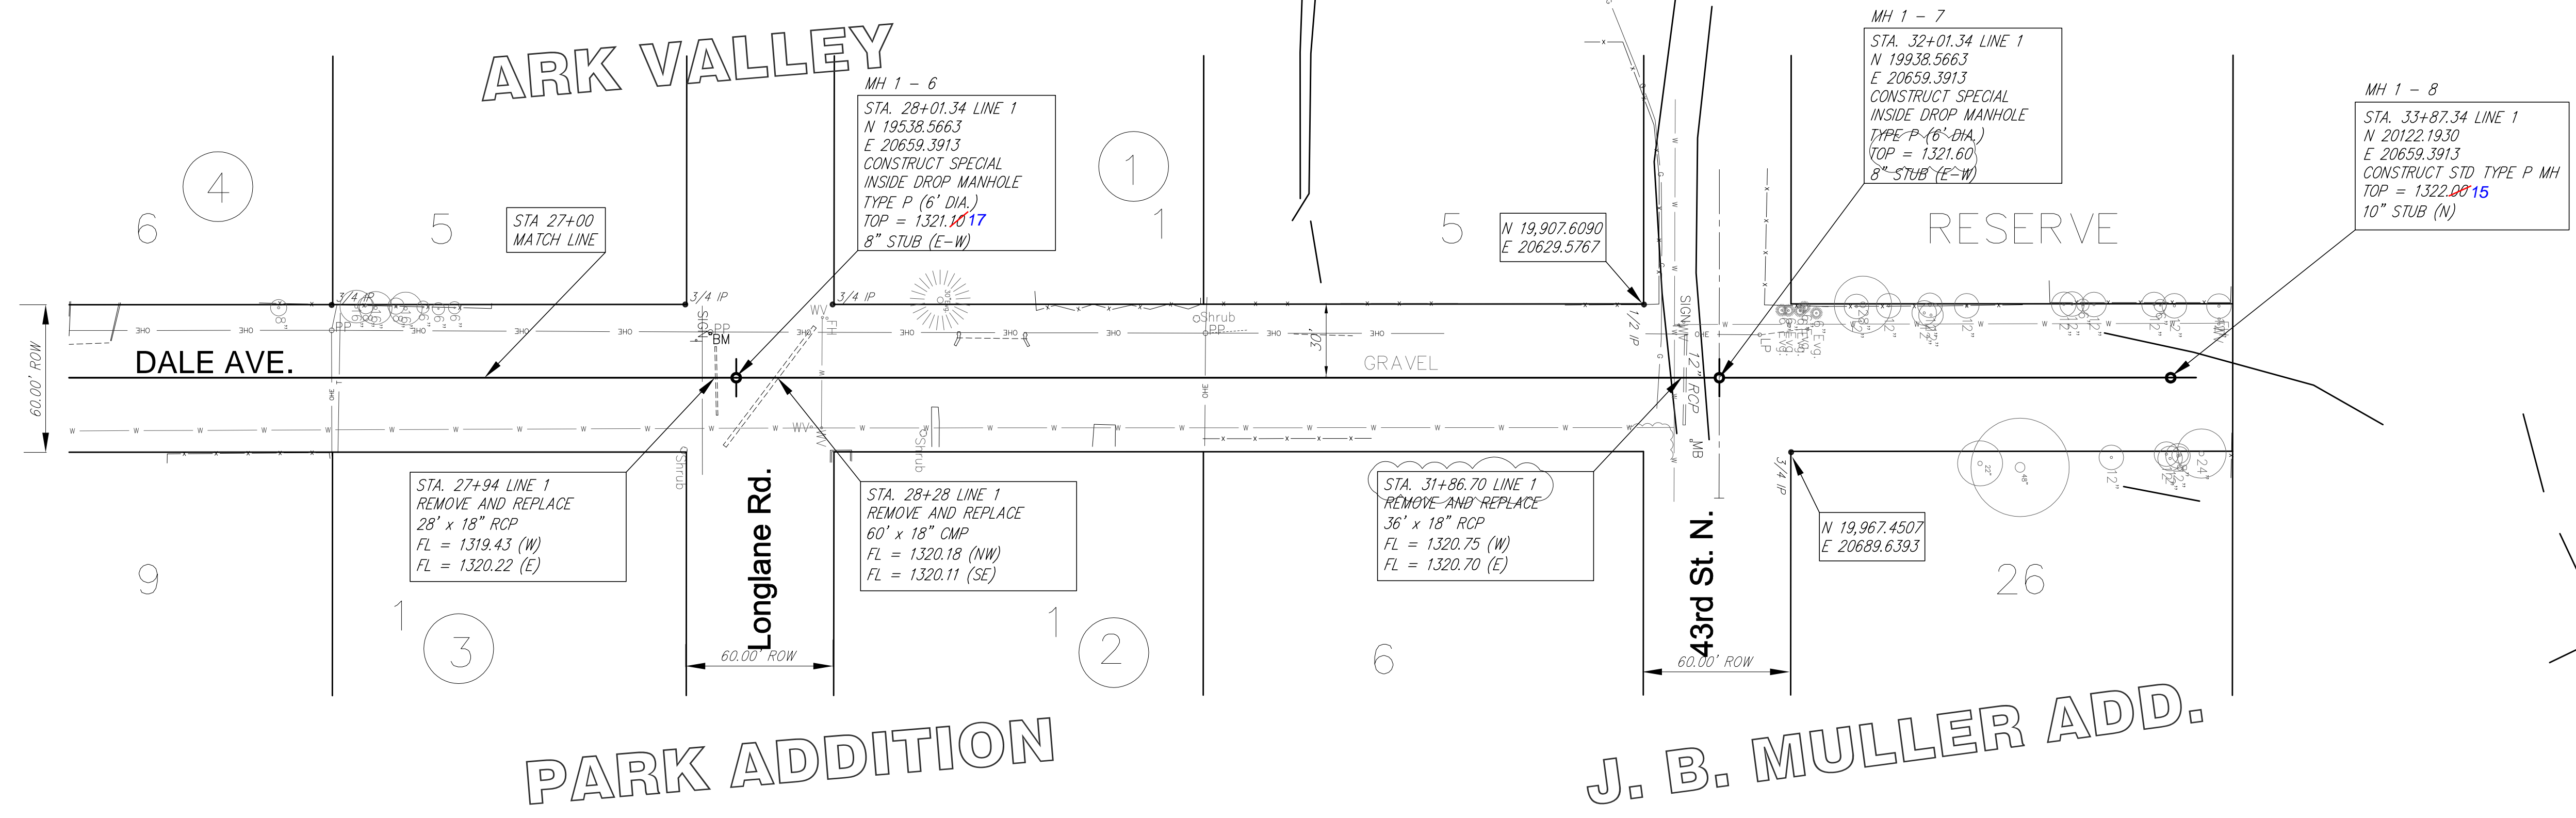

REVISED: 12/31/07
 REVISED: 12/20/07

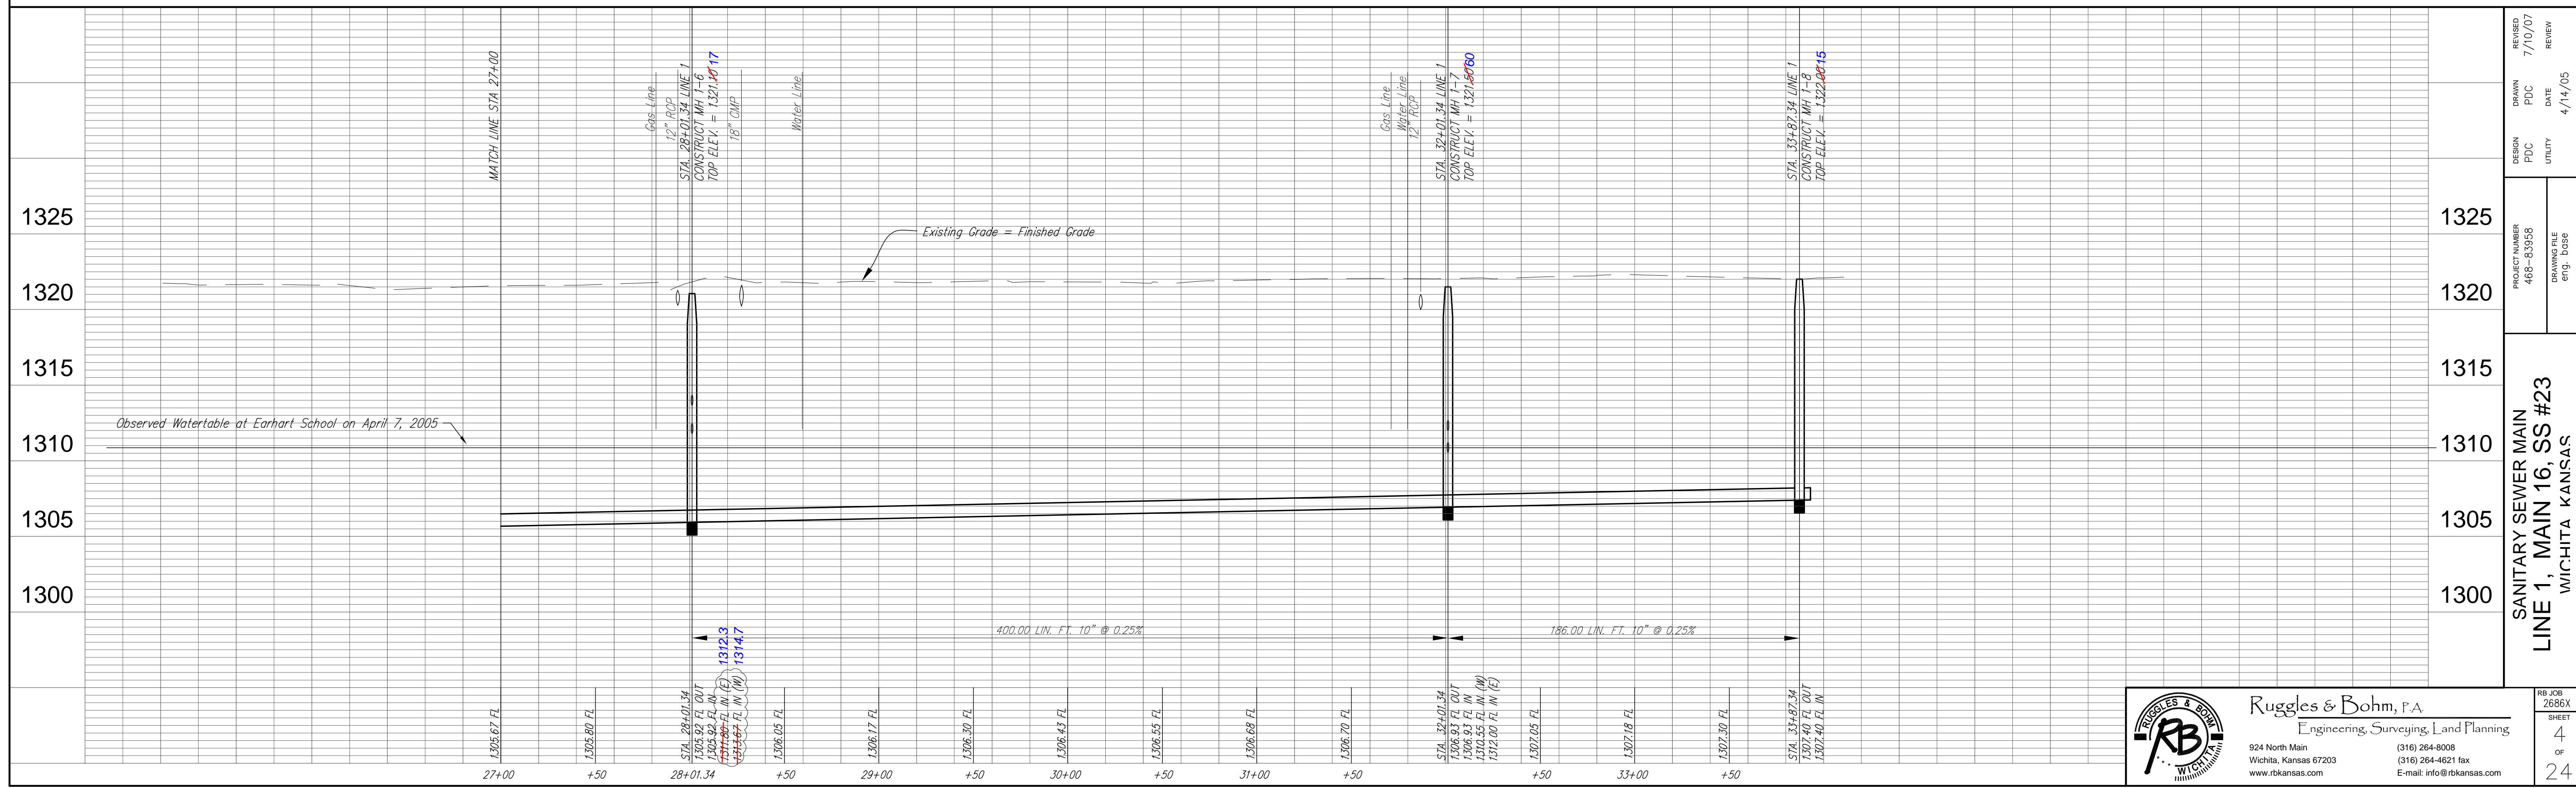

REVISION	DATE	BY
REVISED	7/10/07	REVIEW
DESIGN	DATE	UTILITY
PDC	4/14/05	
PROJECT NUMBER	DRAWING FILE	
468-63958	eng. doc	
SANITARY SEWER MAIN		
LINE 1, MAIN 16, SS #23		
WICHITA KANSAS		

Ruggles & Bohm, P.A.
 Engineering, Surveying, Land Planning

824 North Main
 Wichita, Kansas 67203
 www.rbkansas.com

(316) 264-8008
 (316) 264-4621 fax
 E-mail: info@rbkansas.com

RB JOB 2686X
 SHEET 4 OF 24