


**RIVERSIDE ACRES ADDITION**

**JESSE E. EDWARDS ADDITION**

REVISED: 12/31/07  
 REVISED: 12/20/07

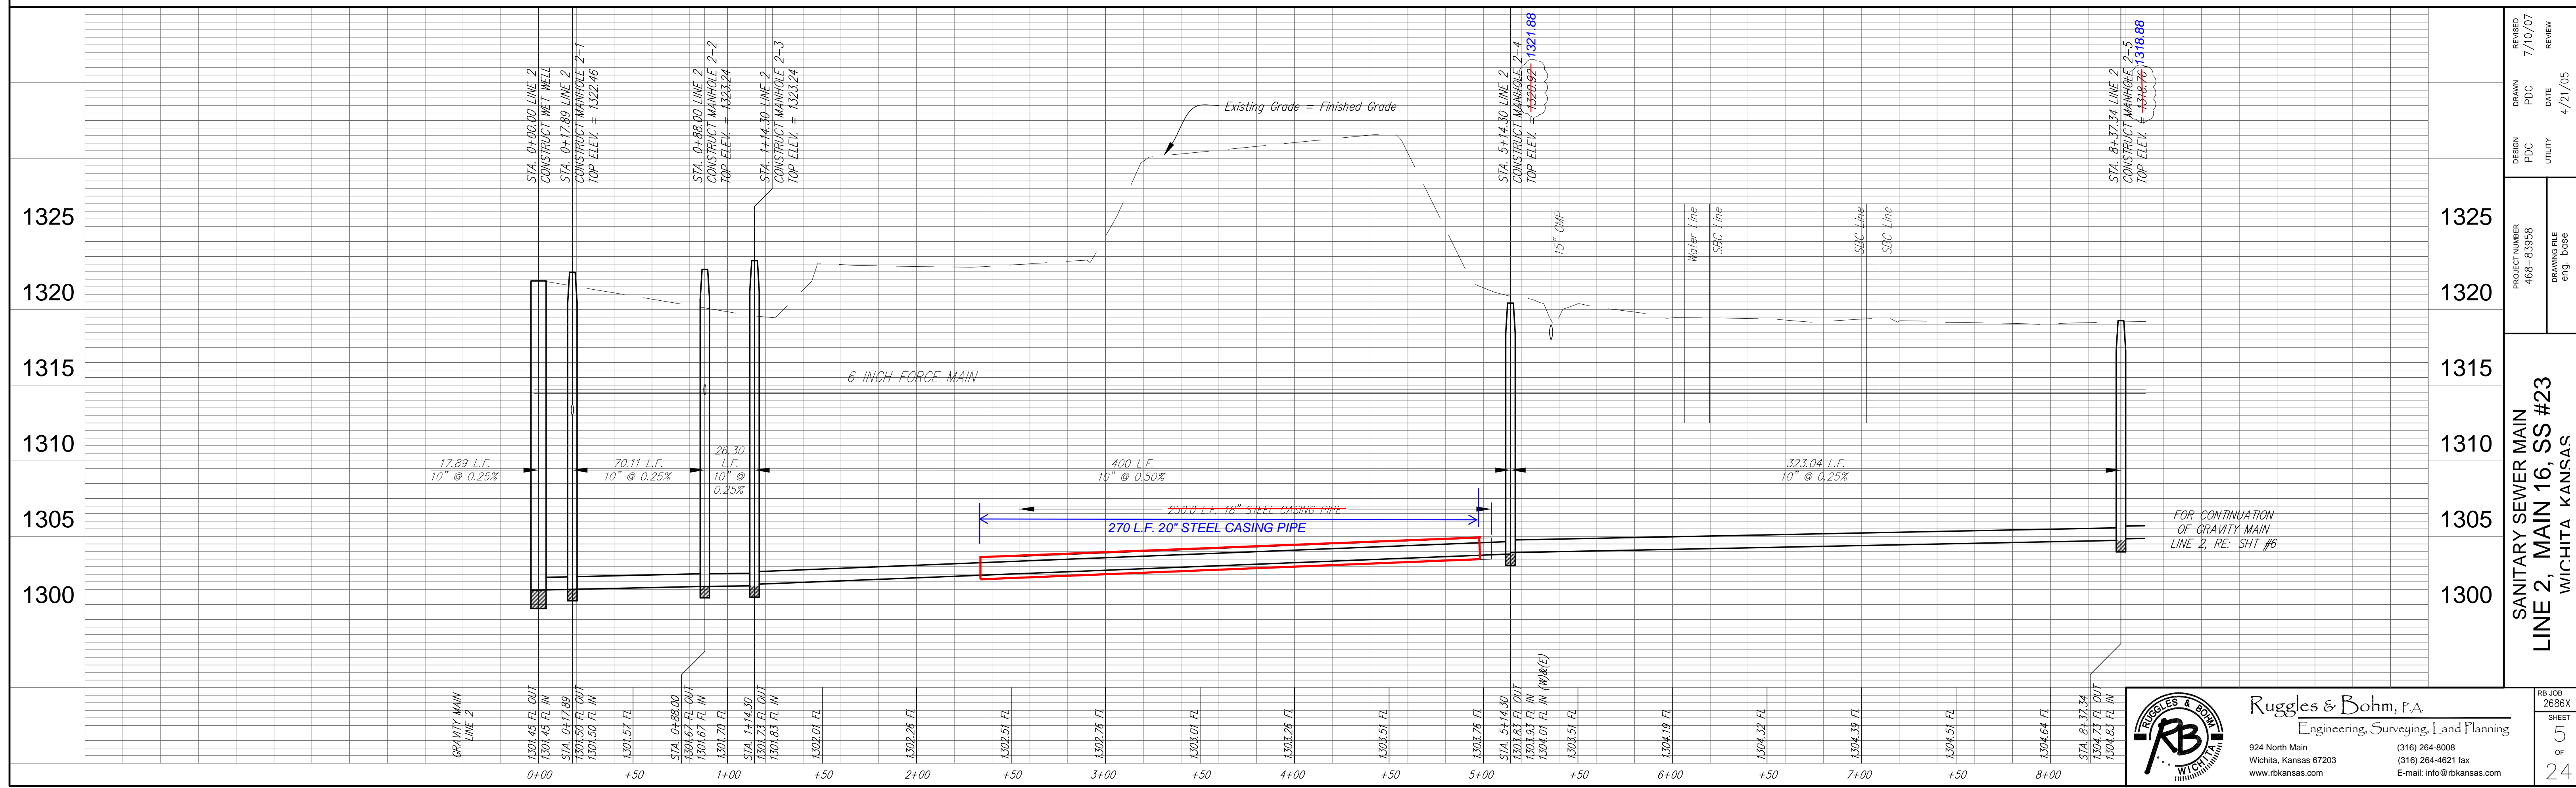

PROJECT NUMBER 468-63958	DESIGN PDC	DRAWN PDC	REVIEW PDC
DRAWING FILE eng. 'dase	UTILITY	DATE 4/21/05	REVIEW 7/10/07
<b>SANITARY SEWER MAIN</b>			
<b>LINE 2, MAIN 16, SS #23</b>			
<b>WICHITA KANSAS</b>			

**Ruggles & Bohm, P.A.**  
 Engineering, Surveying, Land Planning

824 North Main  
 Wichita, Kansas 67203  
 www.rbkansas.com

(316) 264-8008  
 (316) 264-4621 fax  
 E-mail: info@rbkansas.com

RB JOB 2686X  
 SHEET 5 OF 24