

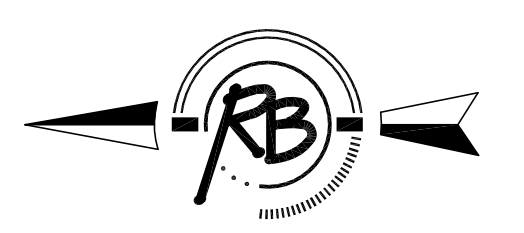


SE 1/4, SEC. 29, T 26 S, R 1 E

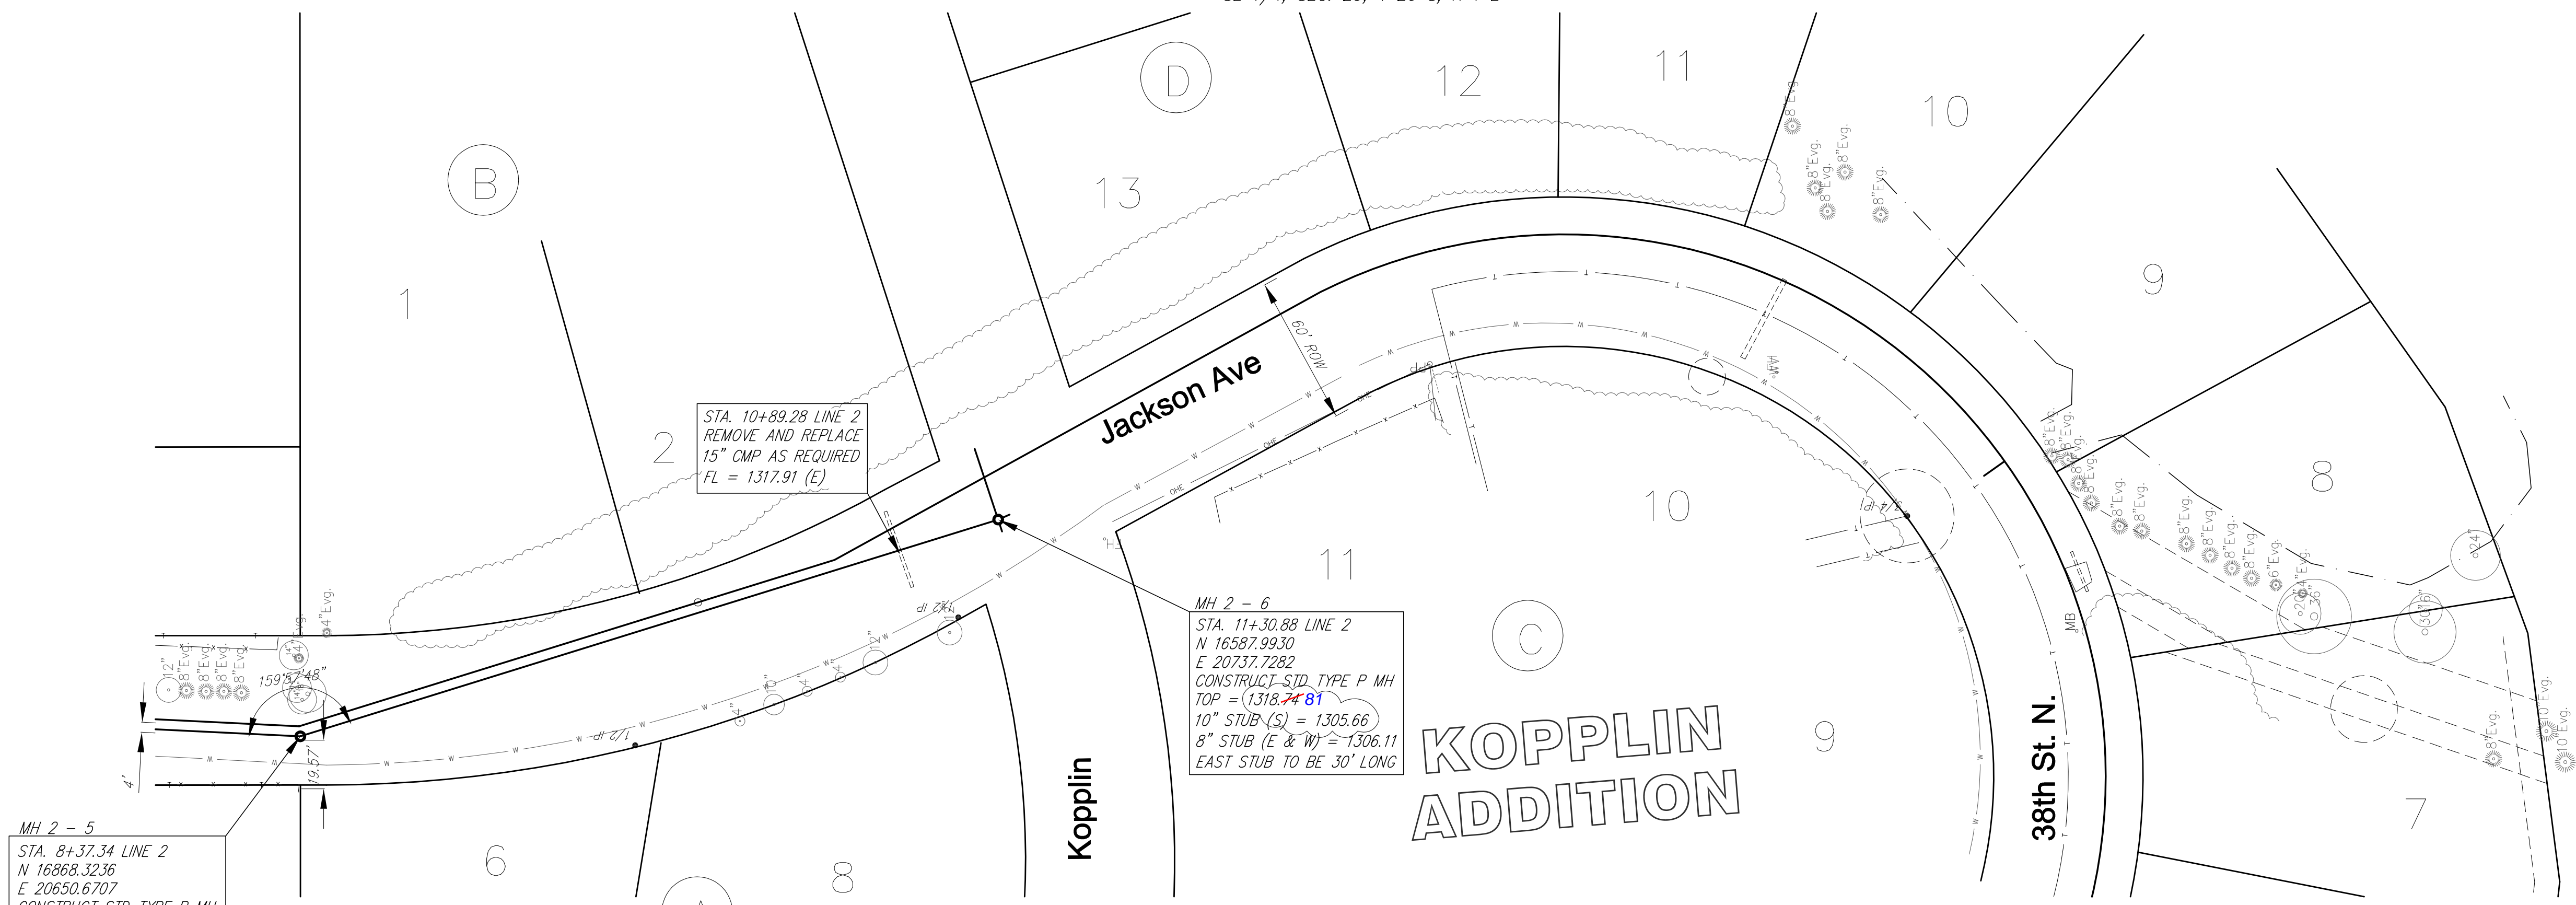


Scale 1" = 40' (Horiz.)  
1" = 5' (Vert.)

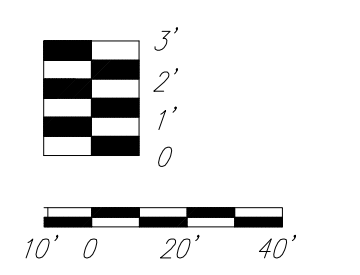

# LINE 2 - GRAVITY MAIN

REVISED: 12/31/07  
REVISED: 12/20/07

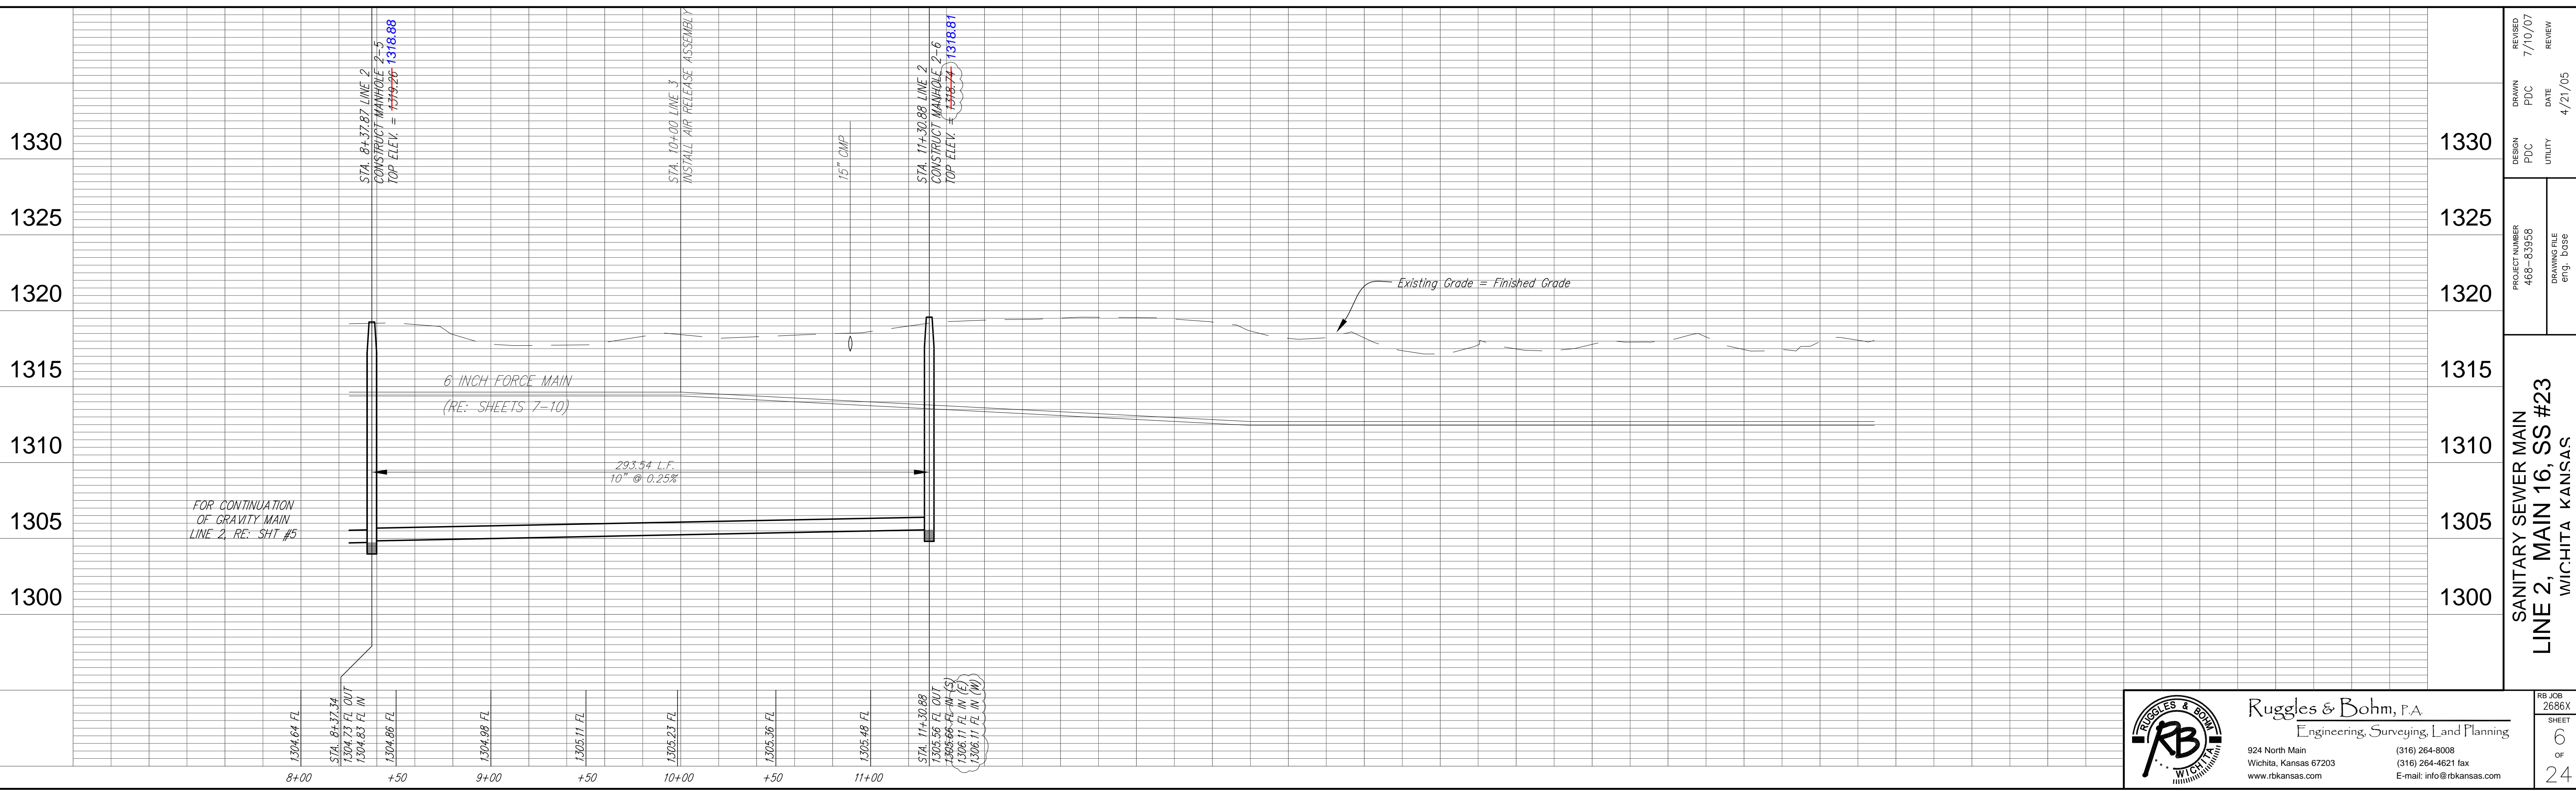

REVISION	DATE	BY
7/10/07	PDC	REVIEW
4/21/05	DATE	UTILITY
4/21/05	DATE	eng. - Dose

SANITARY SEWER MAIN  
LINE 2, MAIN 16, SS #23  
WICHITA KANSAS

**Ruggles & Bohm, P.A.**  
Engineering, Surveying, Land Planning  
924 North Main  
Wichita, Kansas 67203  
www.rbkansas.com  
(316) 264-8008  
(316) 264-4621 fax  
E-mail: info@rbkansas.com