
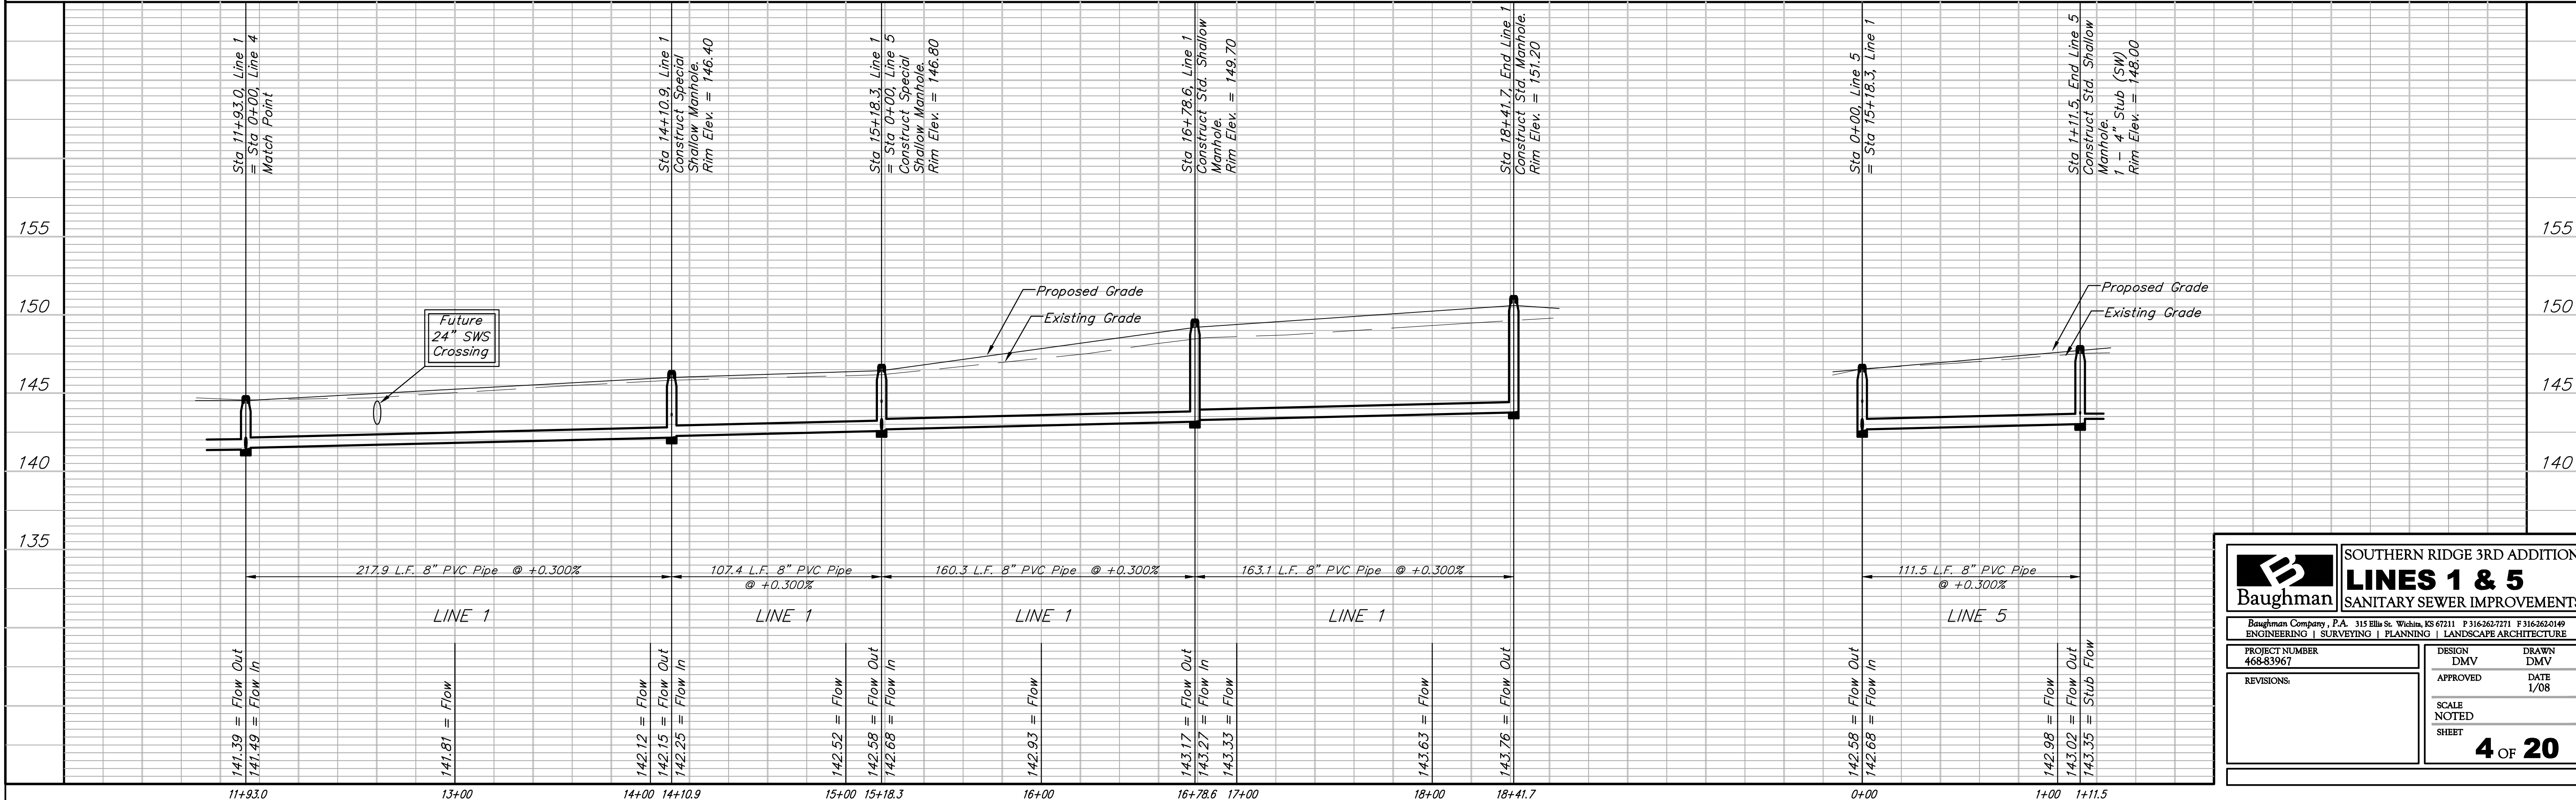
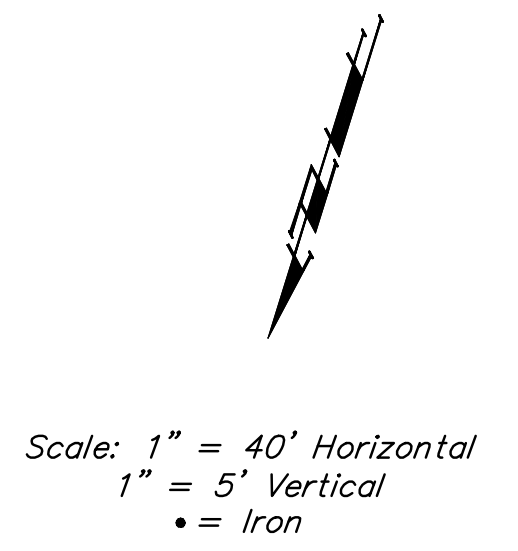


**BENCHMARKS:**

BM #1: COW Disc in top of curb adjacent to the fire hydrant at the SW corner of Yosemite and Lamp Cir.  
Elev. = 146.73 (City Datum)

BM #2: COW Disc in top of curb adjacent to the fire hydrant on the west side of Westgate along the southwesterly line of Lot 13, Block B, Southern Ridge Addition.  
Elev. = 144.10 (City Datum)

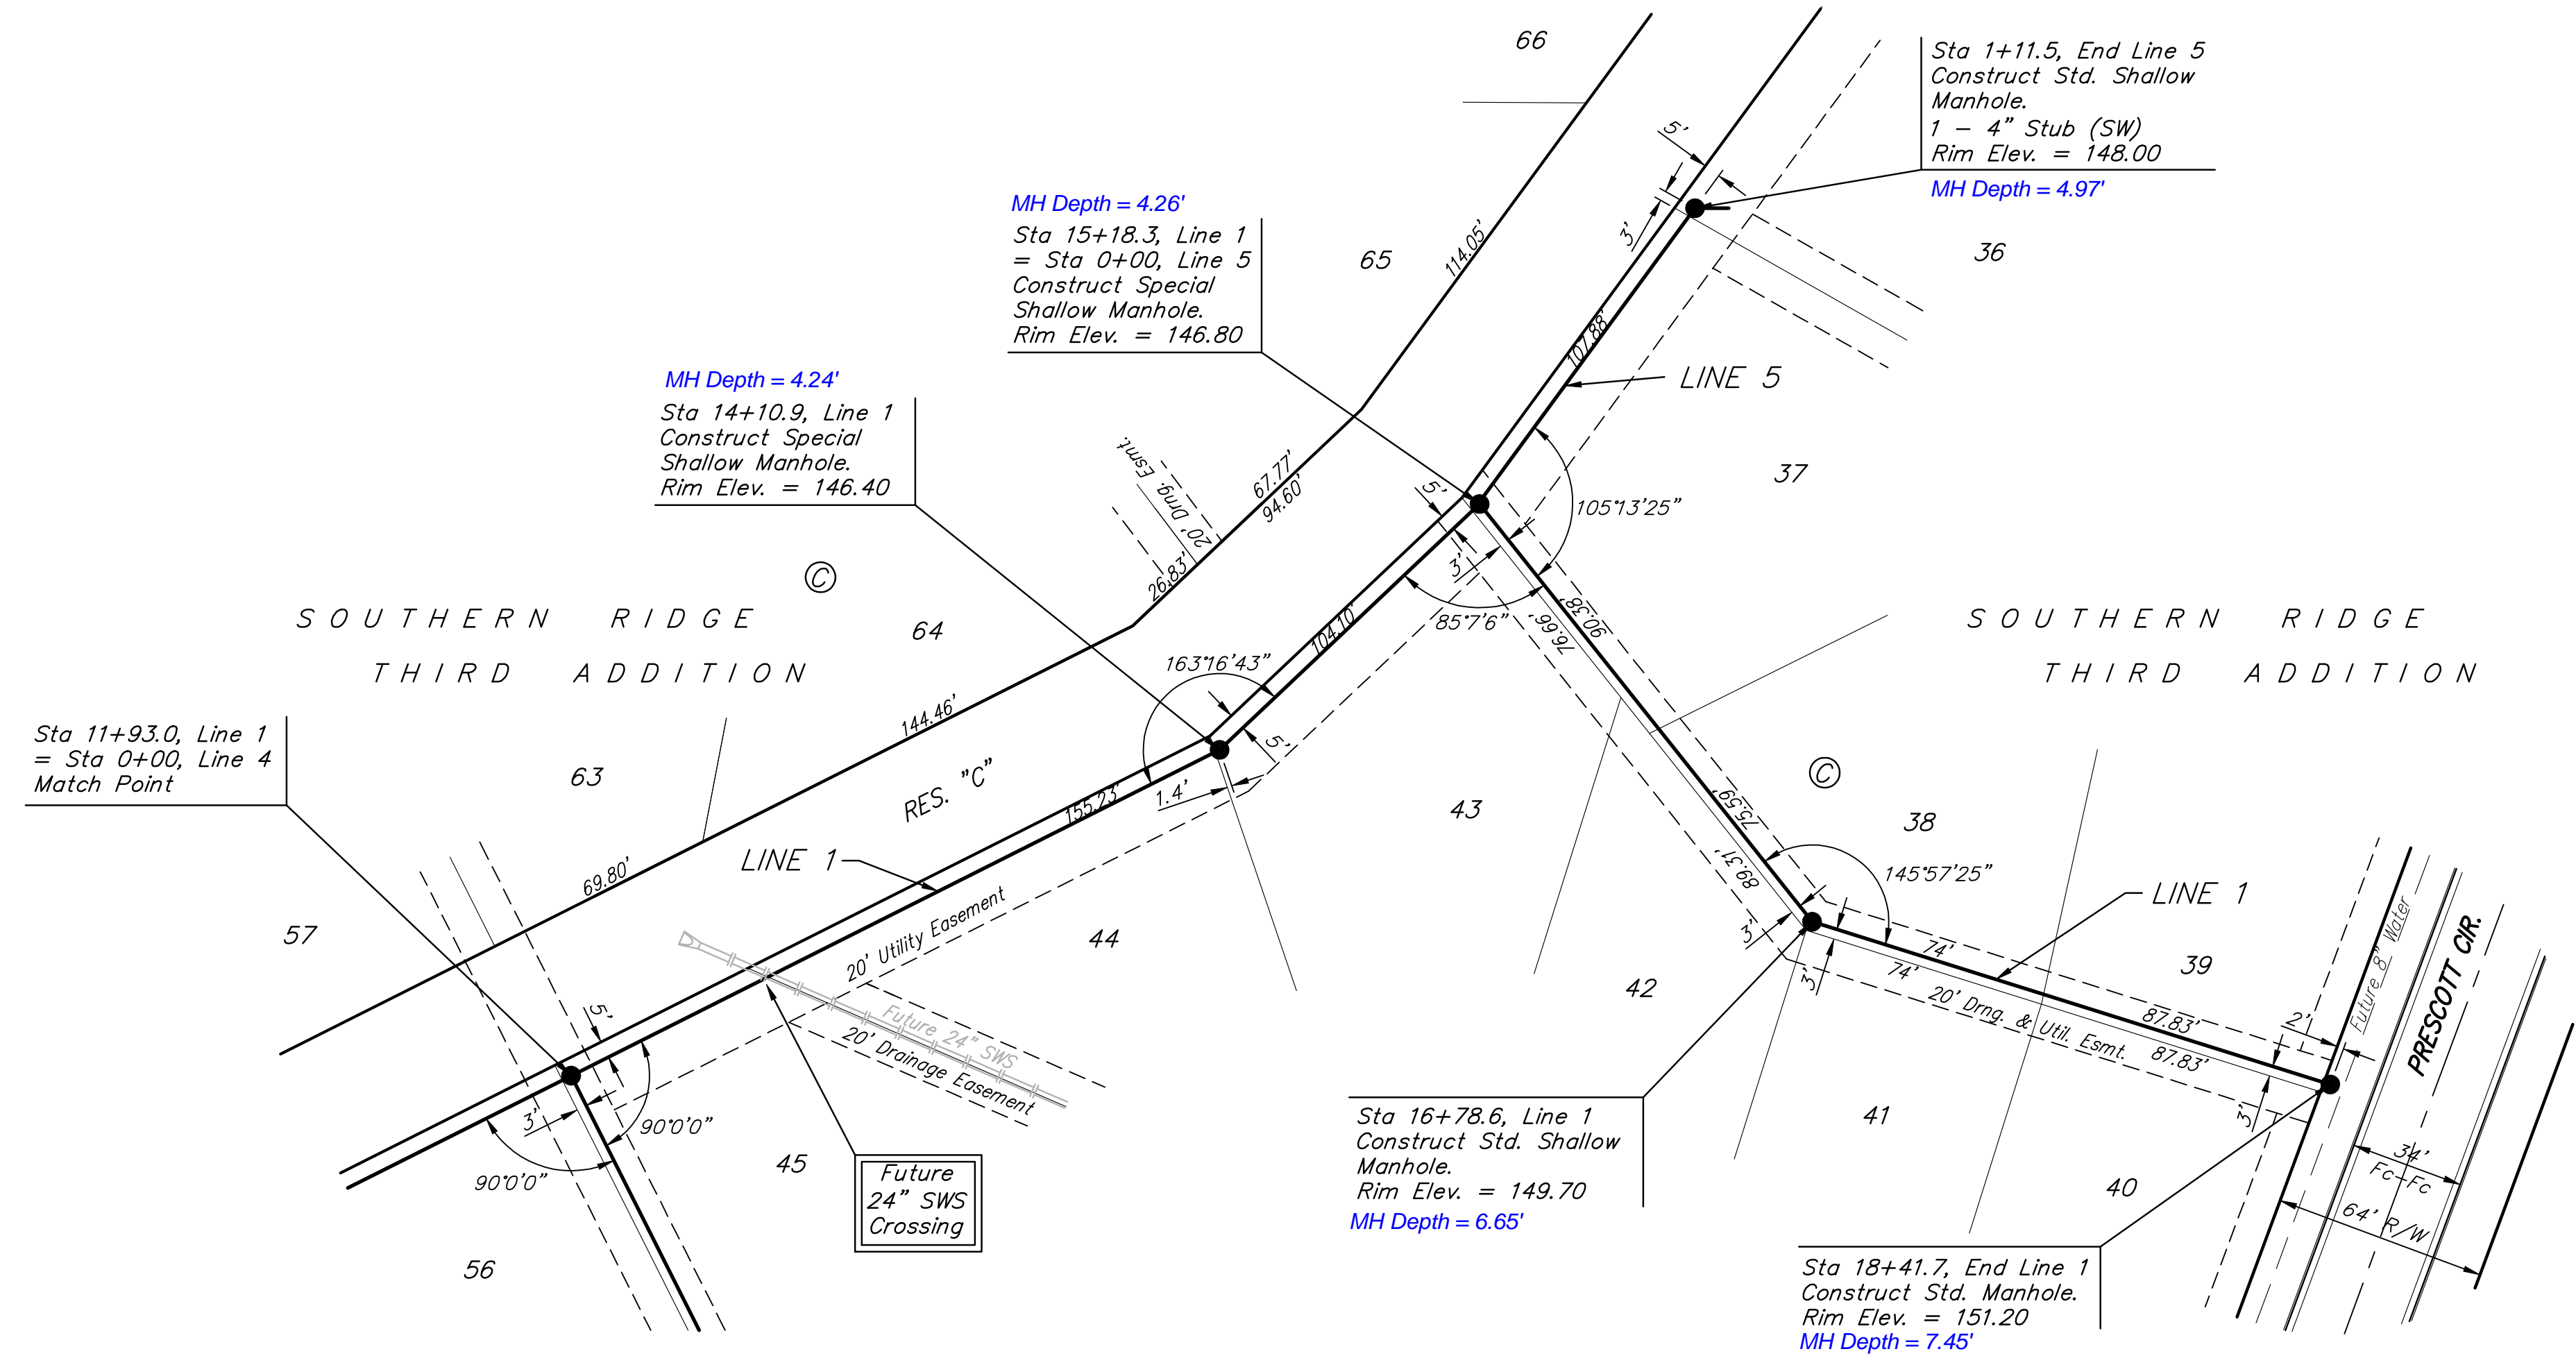

<b>Baughman</b>		SOUTHERN RIDGE 3RD ADDITION	
		<b>LINES 1 &amp; 5</b>	
		SANITARY SEWER IMPROVEMENTS	
<small>Baughman Company, P.A. 315 Ellis St. Wichita, KS 67211 P 316-262-7171 F 316-262-0149 ENGINEERING   SURVEYING   PLANNING   LANDSCAPE ARCHITECTURE</small>			
PROJECT NUMBER 468-83967	DESIGN DMV	DRAWN DMV	
REVISIONS:	APPROVED	DATE 1/08	
	SCALE NOTED		
	SHEET	<b>4 OF 20</b>	