
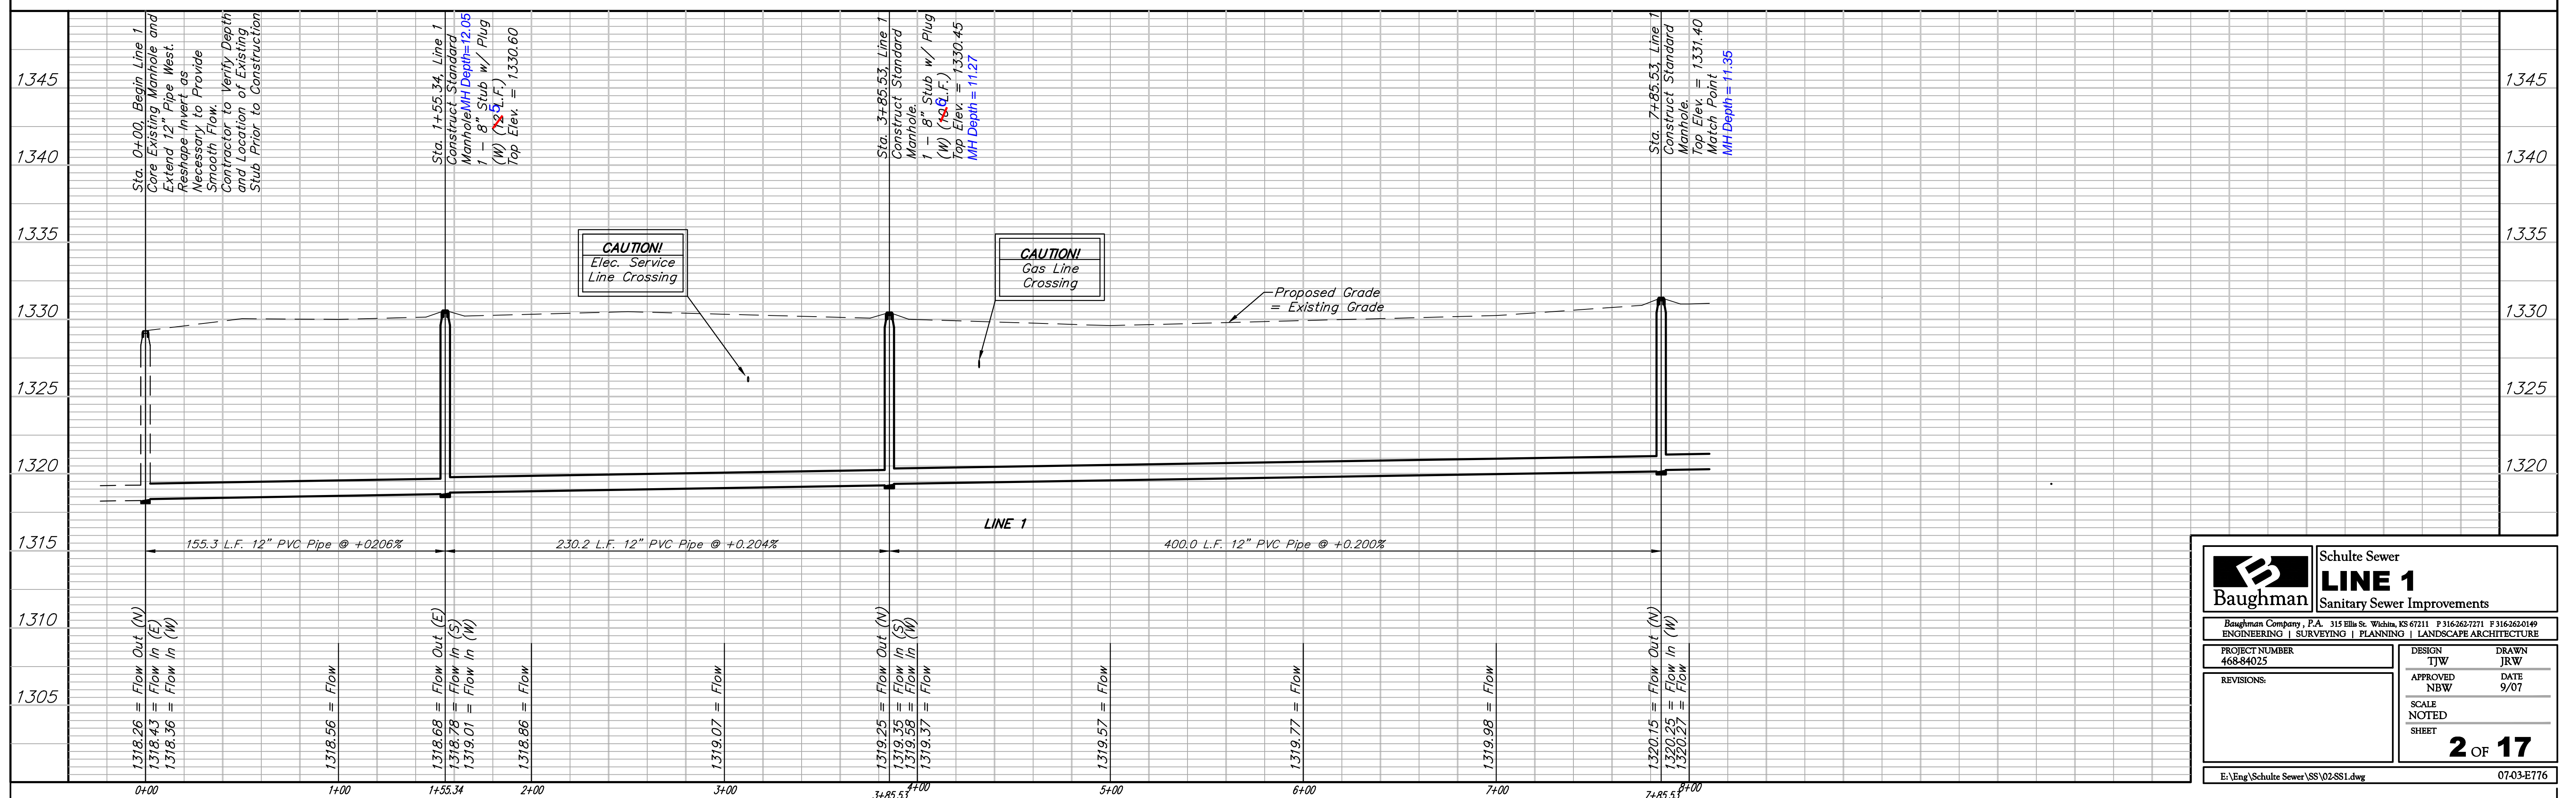


**Benchmarks:**  
 BM #1: Small RR spike in 2nd PP north of K-42 Highway, west side of Maize Elev. = 1331.01 (M.S.L.)  
 BM #2: Small RR spike in PP east of East 1/4 Corner (G) Elev. = 1334.40 (M.S.L.)  
 BM #3: "□" Top Headwall southeast corner K-42 Highway and Maize (County BM with City Datum Elev. = 1331.44 (M.S.L.)

SCALE:  
 1" = 40' HORIZONTAL  
 1" = 5' VERTICAL  
 • = IRON

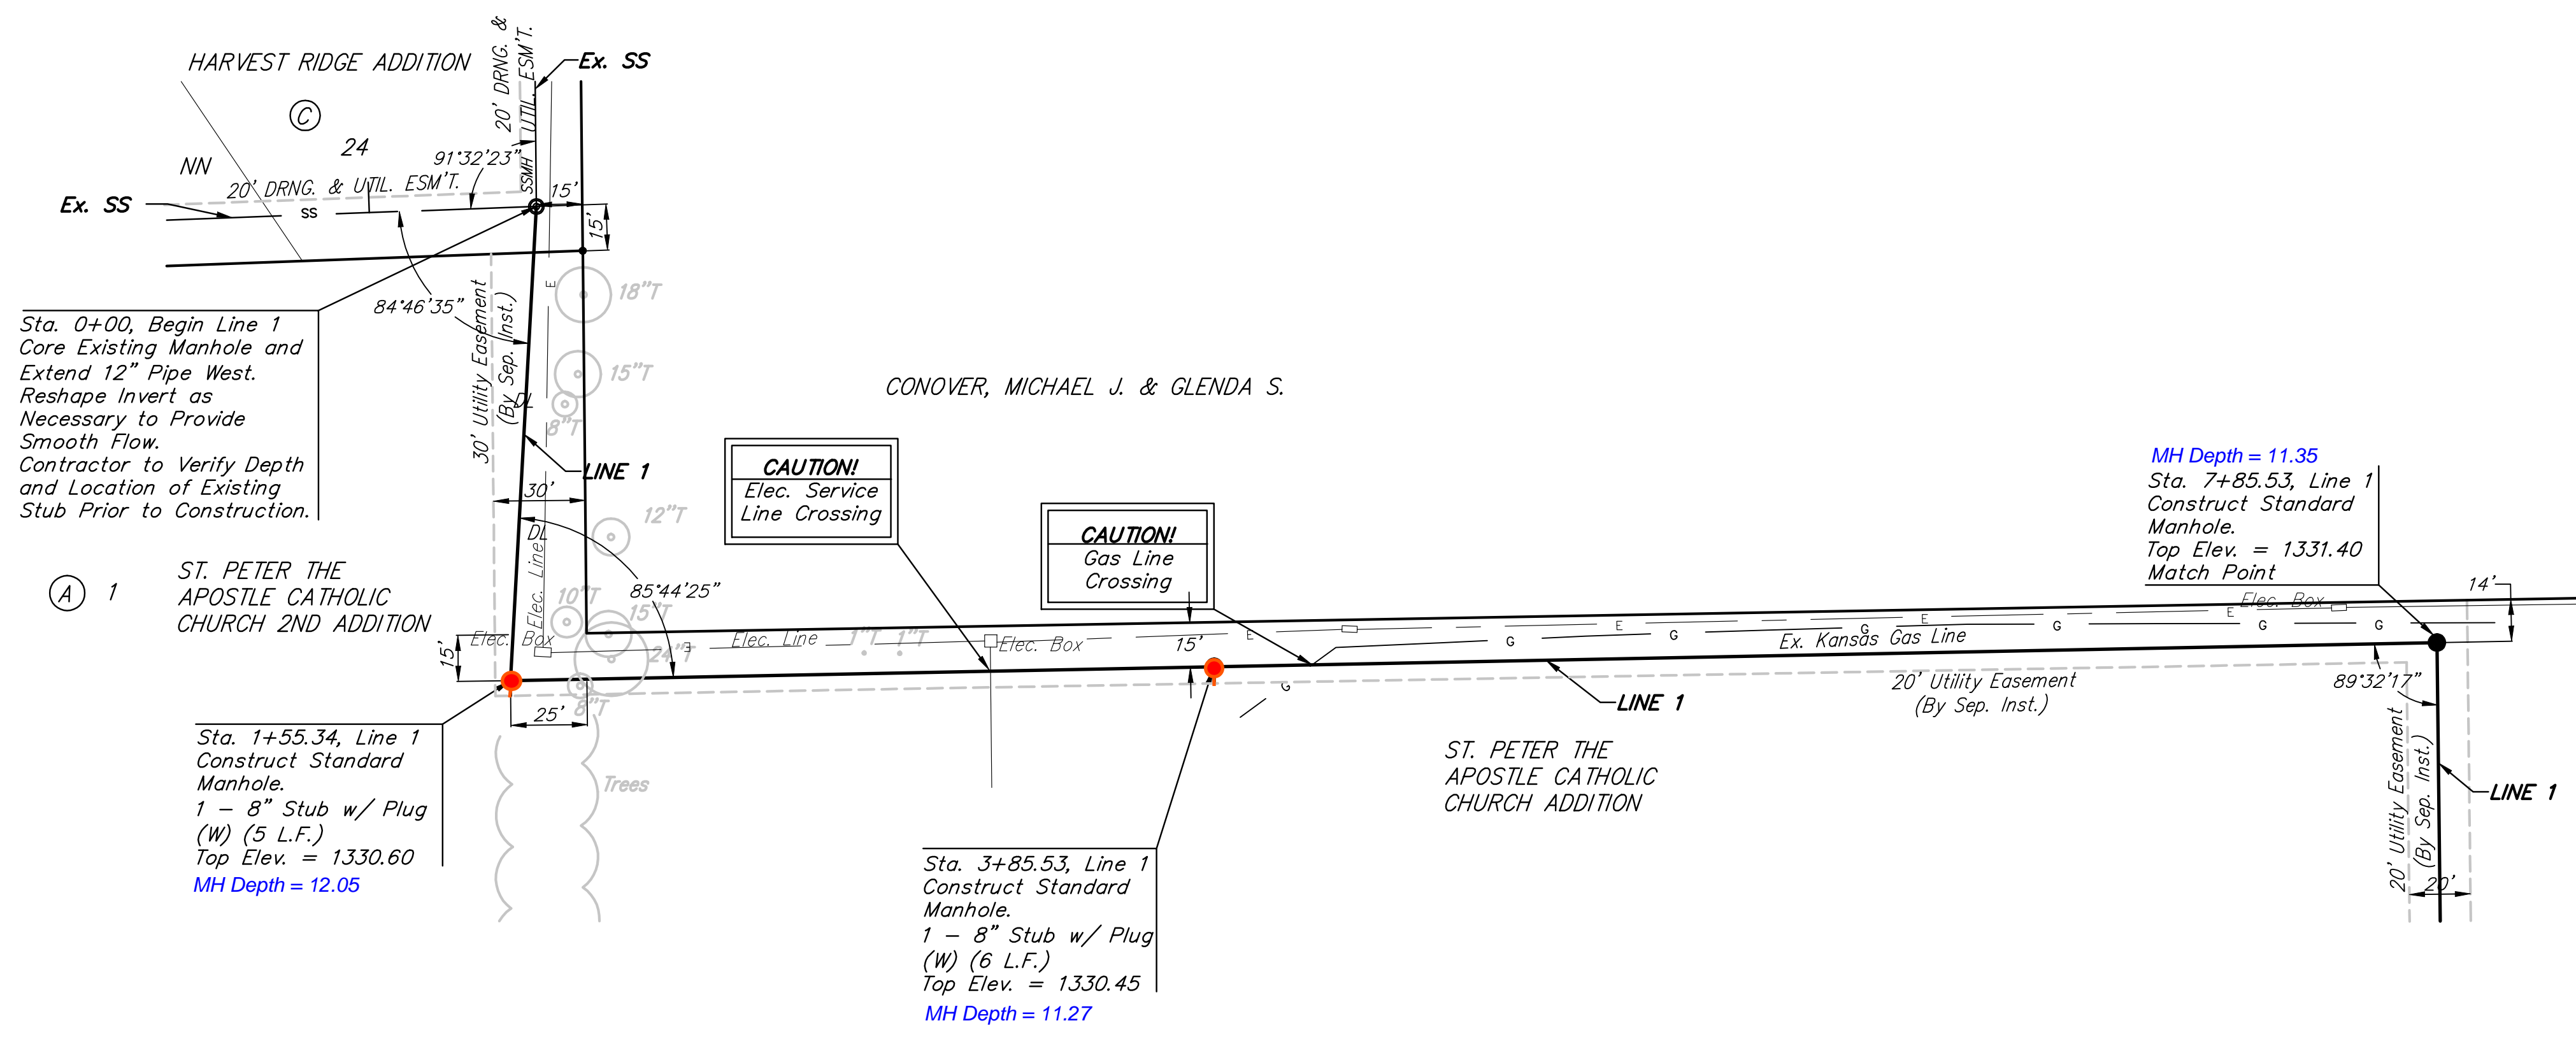

		Schulte Sewer	
		<b>LINE 1</b>	
Sanitary Sewer Improvements		<small>Baughman Company, P.A. 315 Ellis St. Wichita, KS 67211 P 316-262-7271 F 316-262-0149          ENGINEERING   SURVEYING   PLANNING   LANDSCAPE ARCHITECTURE</small>	
PROJECT NUMBER 468-84025	DESIGN TJW	DRAWN JRW	
REVISIONS:	APPROVED NBW	DATE 9/07	
	SCALE NOTED	SHEET	
		<b>2 OF 17</b>	
E:\Eng\Schulte Sewer\SS\02-SS1.dwg		0703-E776	