
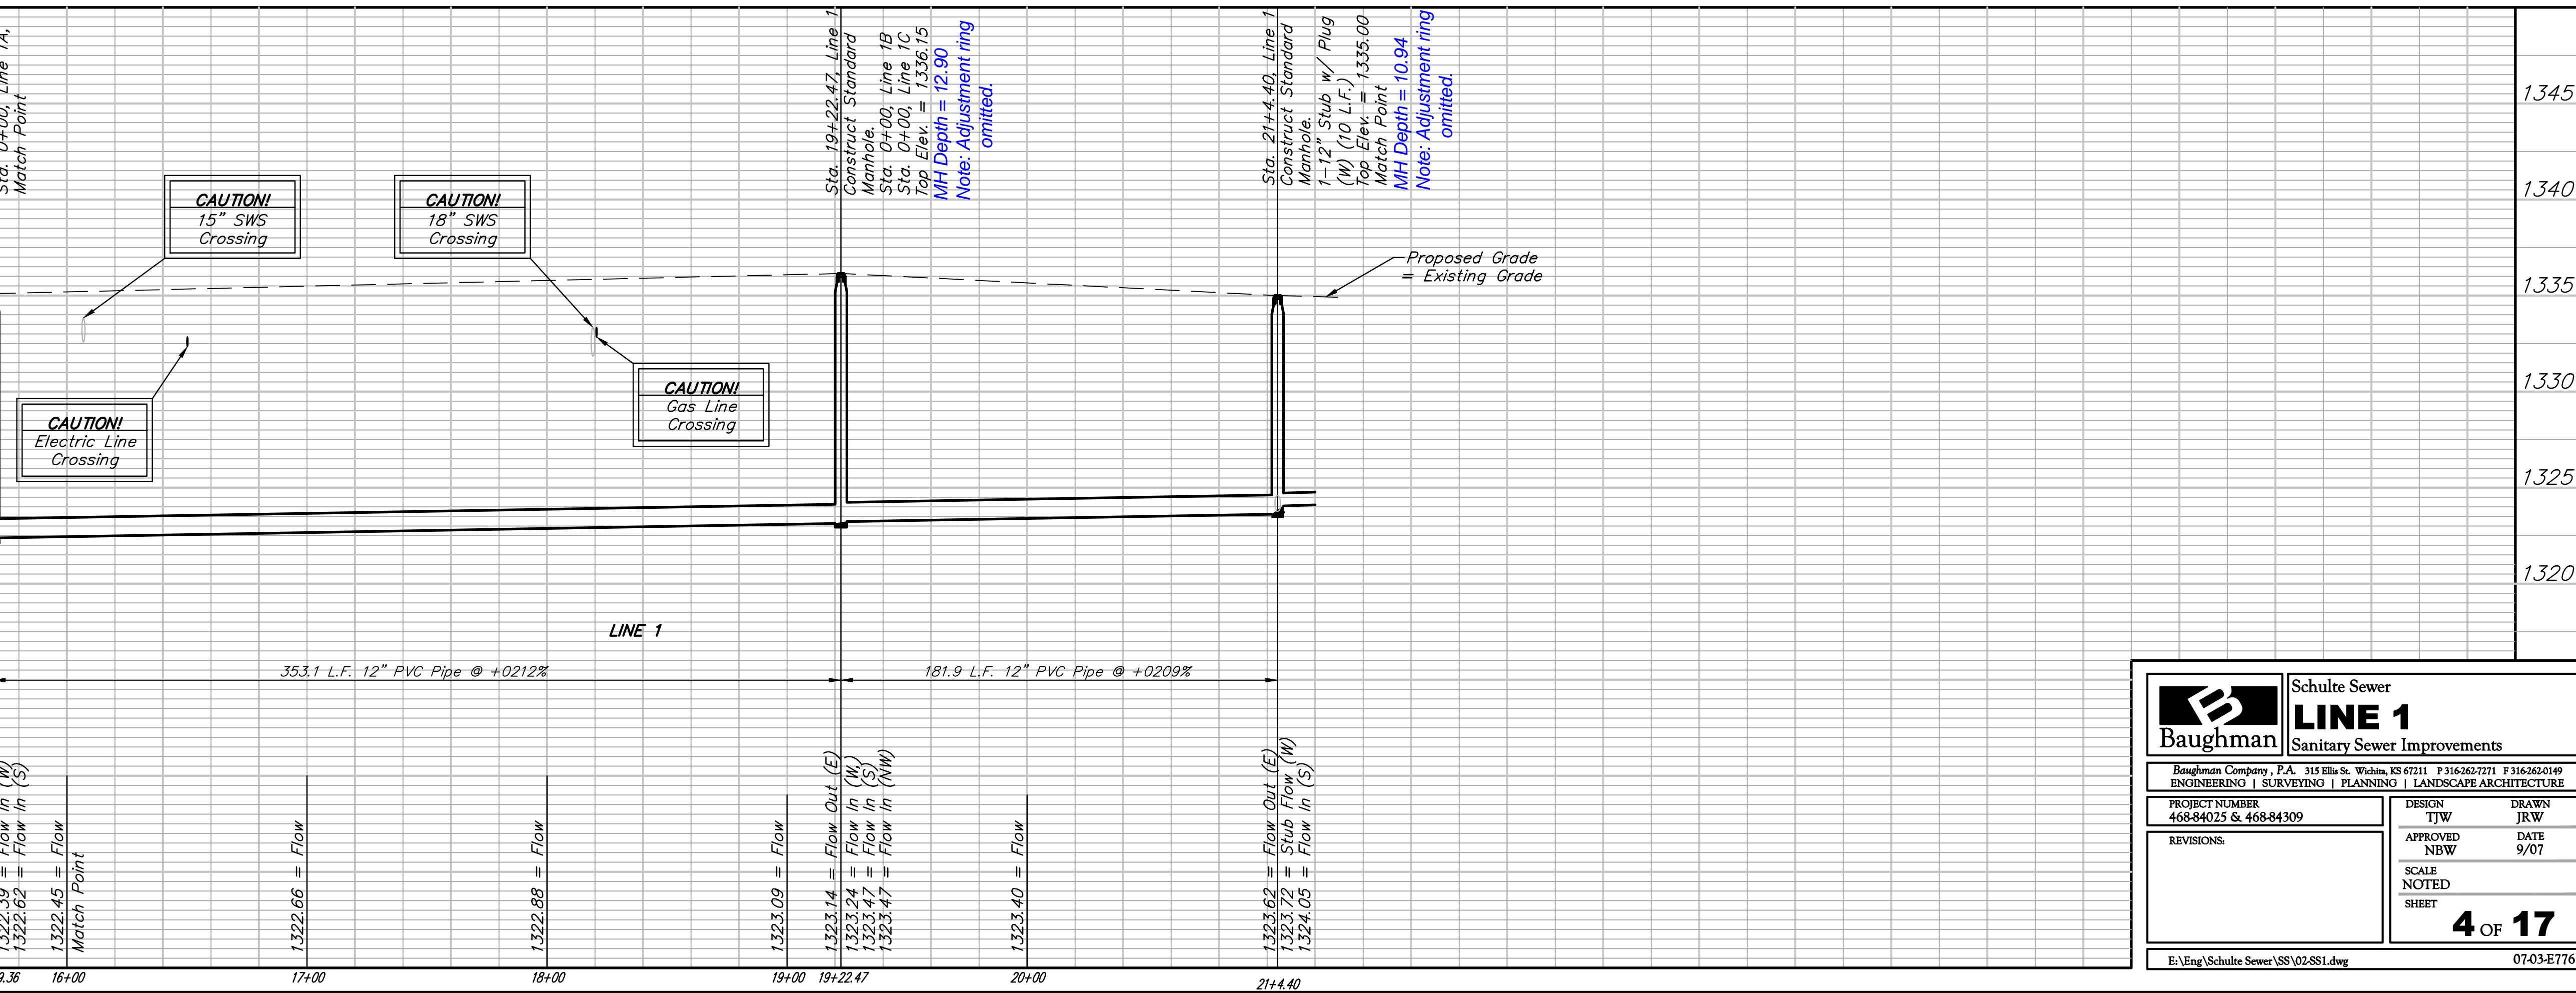


Benchmarks:
 BM #1: Small RR spike in 2nd PP north of K-42 Highway, west side of Maize
 Elev. = 1331.01 (M.S.L.)
 BM #2: Small RR spike in PP east of East 1/4 Corner (G)
 Elev. = 1334.40 (M.S.L.)
 BM #3: "□" Top Headwall southeast corner K-42 Highway and Maize (County BM with City Datum)
 Elev. = 1331.44 (M.S.L.)

SCALE:
 1" = 40' HORIZONTAL
 1" = 5' VERTICAL
 • = IRON

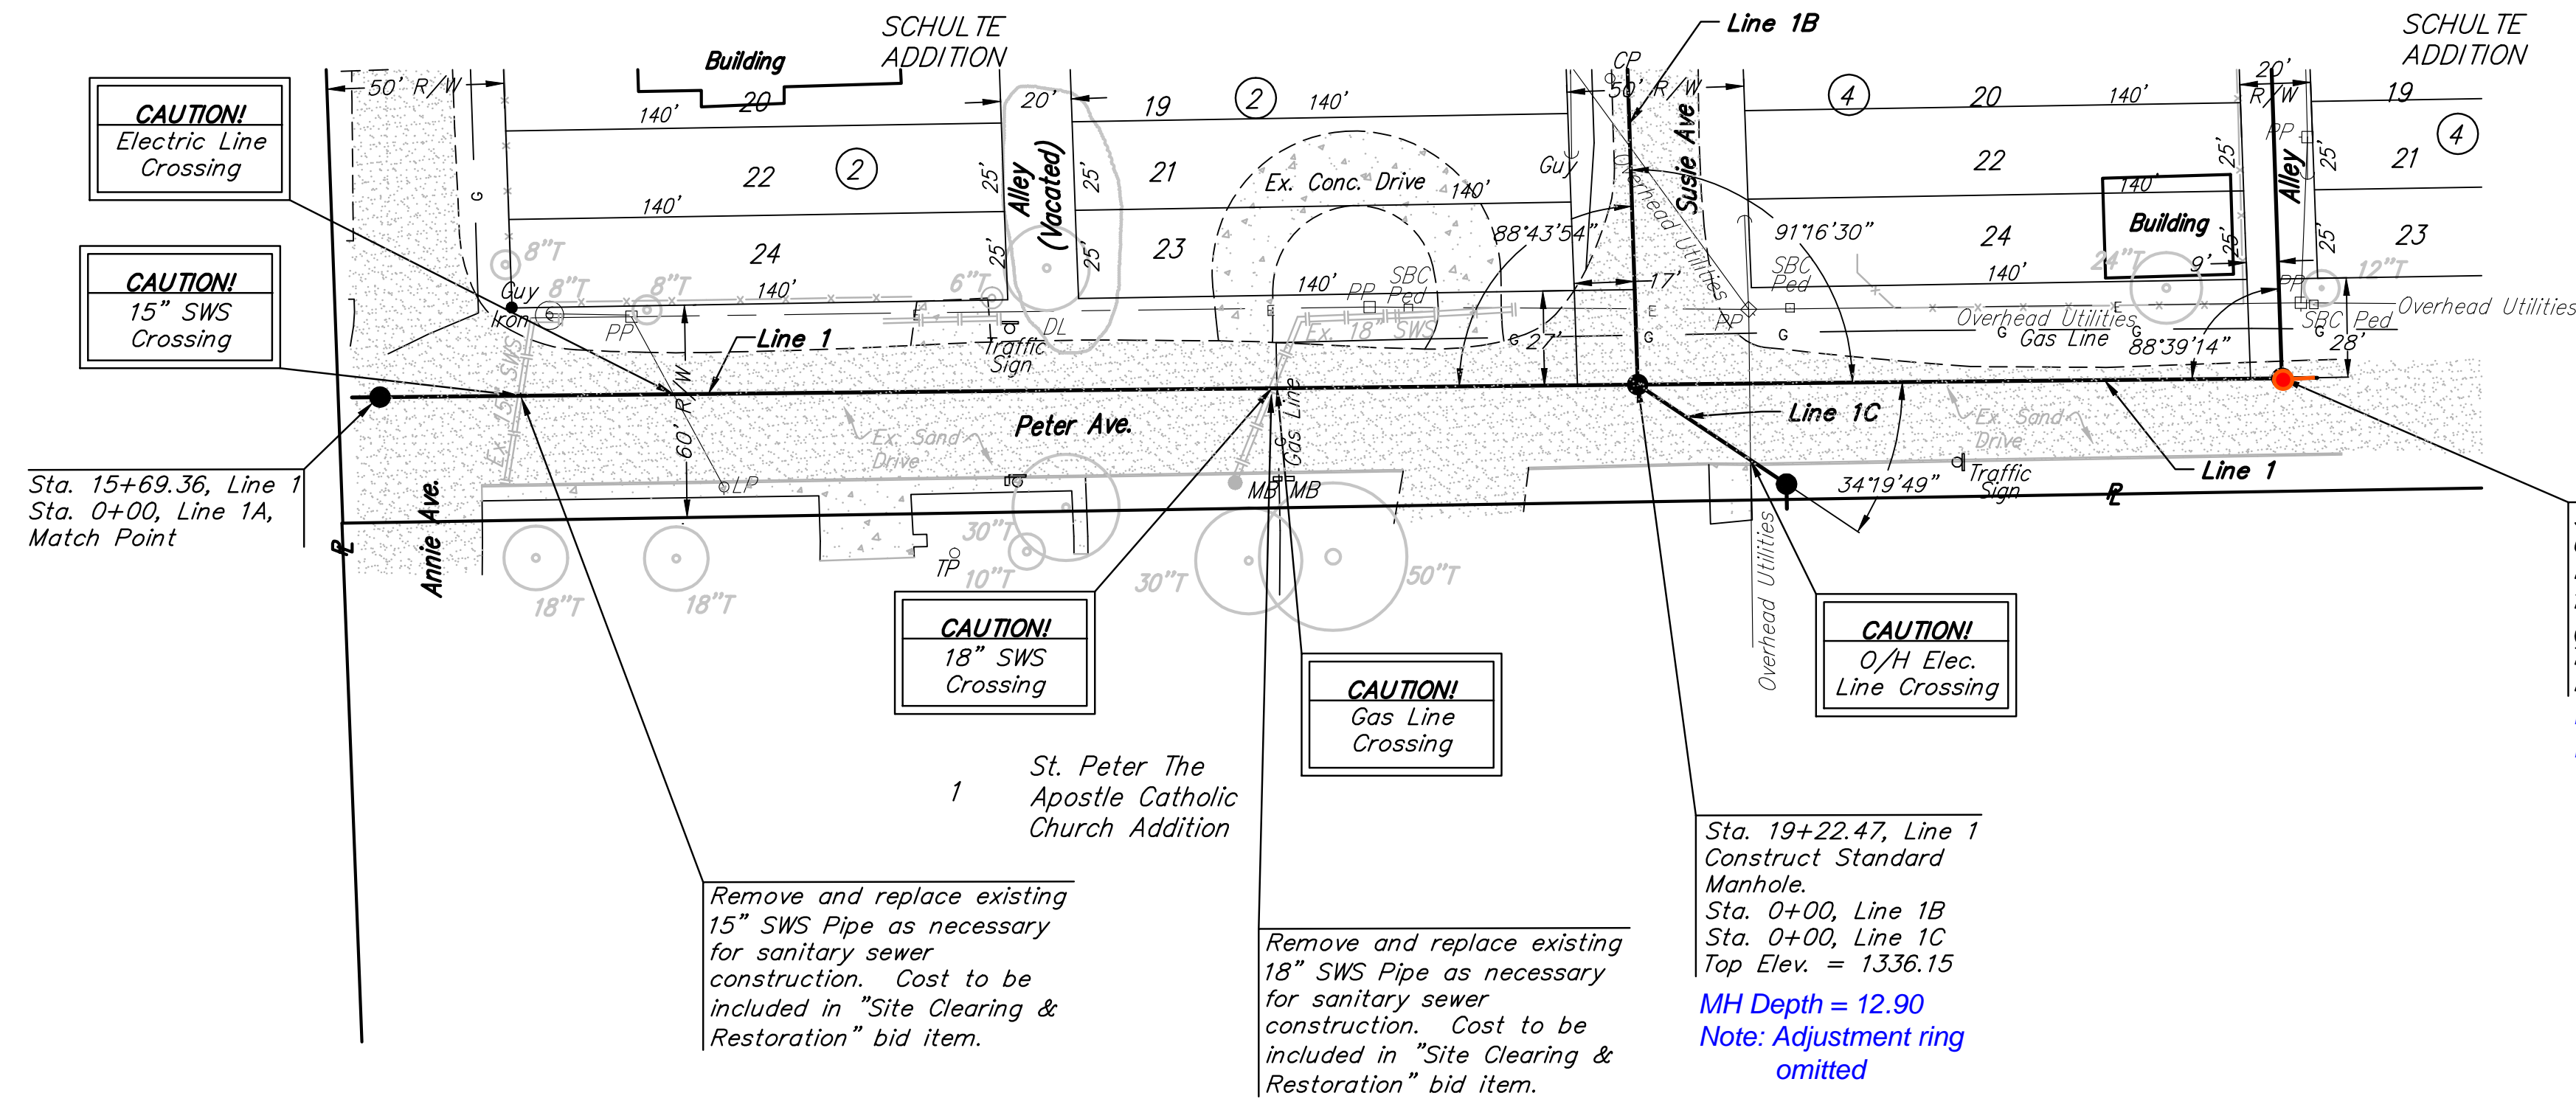

		Schulte Sewer	
		LINE 1	
Baughman Company, P.A. 315 Ellis St. Wichita, KS 67211 P 316-262-7271 F 316-262-0149		ENGINEERING SURVEYING PLANNING LANDSCAPE ARCHITECTURE	
PROJECT NUMBER 468-84025 & 468-84309	DESIGN TJW	DRAWN JRW	
REVISIONS:	APPROVED NBW	DATE 9/07	
	SCALE NOTED		
			4 OF 17
E:\Eng\Schulte Sewer\SS\02-SS1.dwg			07-03-E776