



**Benchmarks:**  
 BM #1: Small RR spike in 2nd PP north of K-42 Highway, west side of Maize. Elev. = 1331.01 (M.S.L.)  
 BM #2: Small RR spike in PP east of East 1/4 Corner (G). Elev. = 1334.40 (M.S.L.)  
 BM #3: "□" Top Headwall southeast corner K-42 Highway and Maize (County BM with City Datum). Elev. = 1331.44 (M.S.L.)

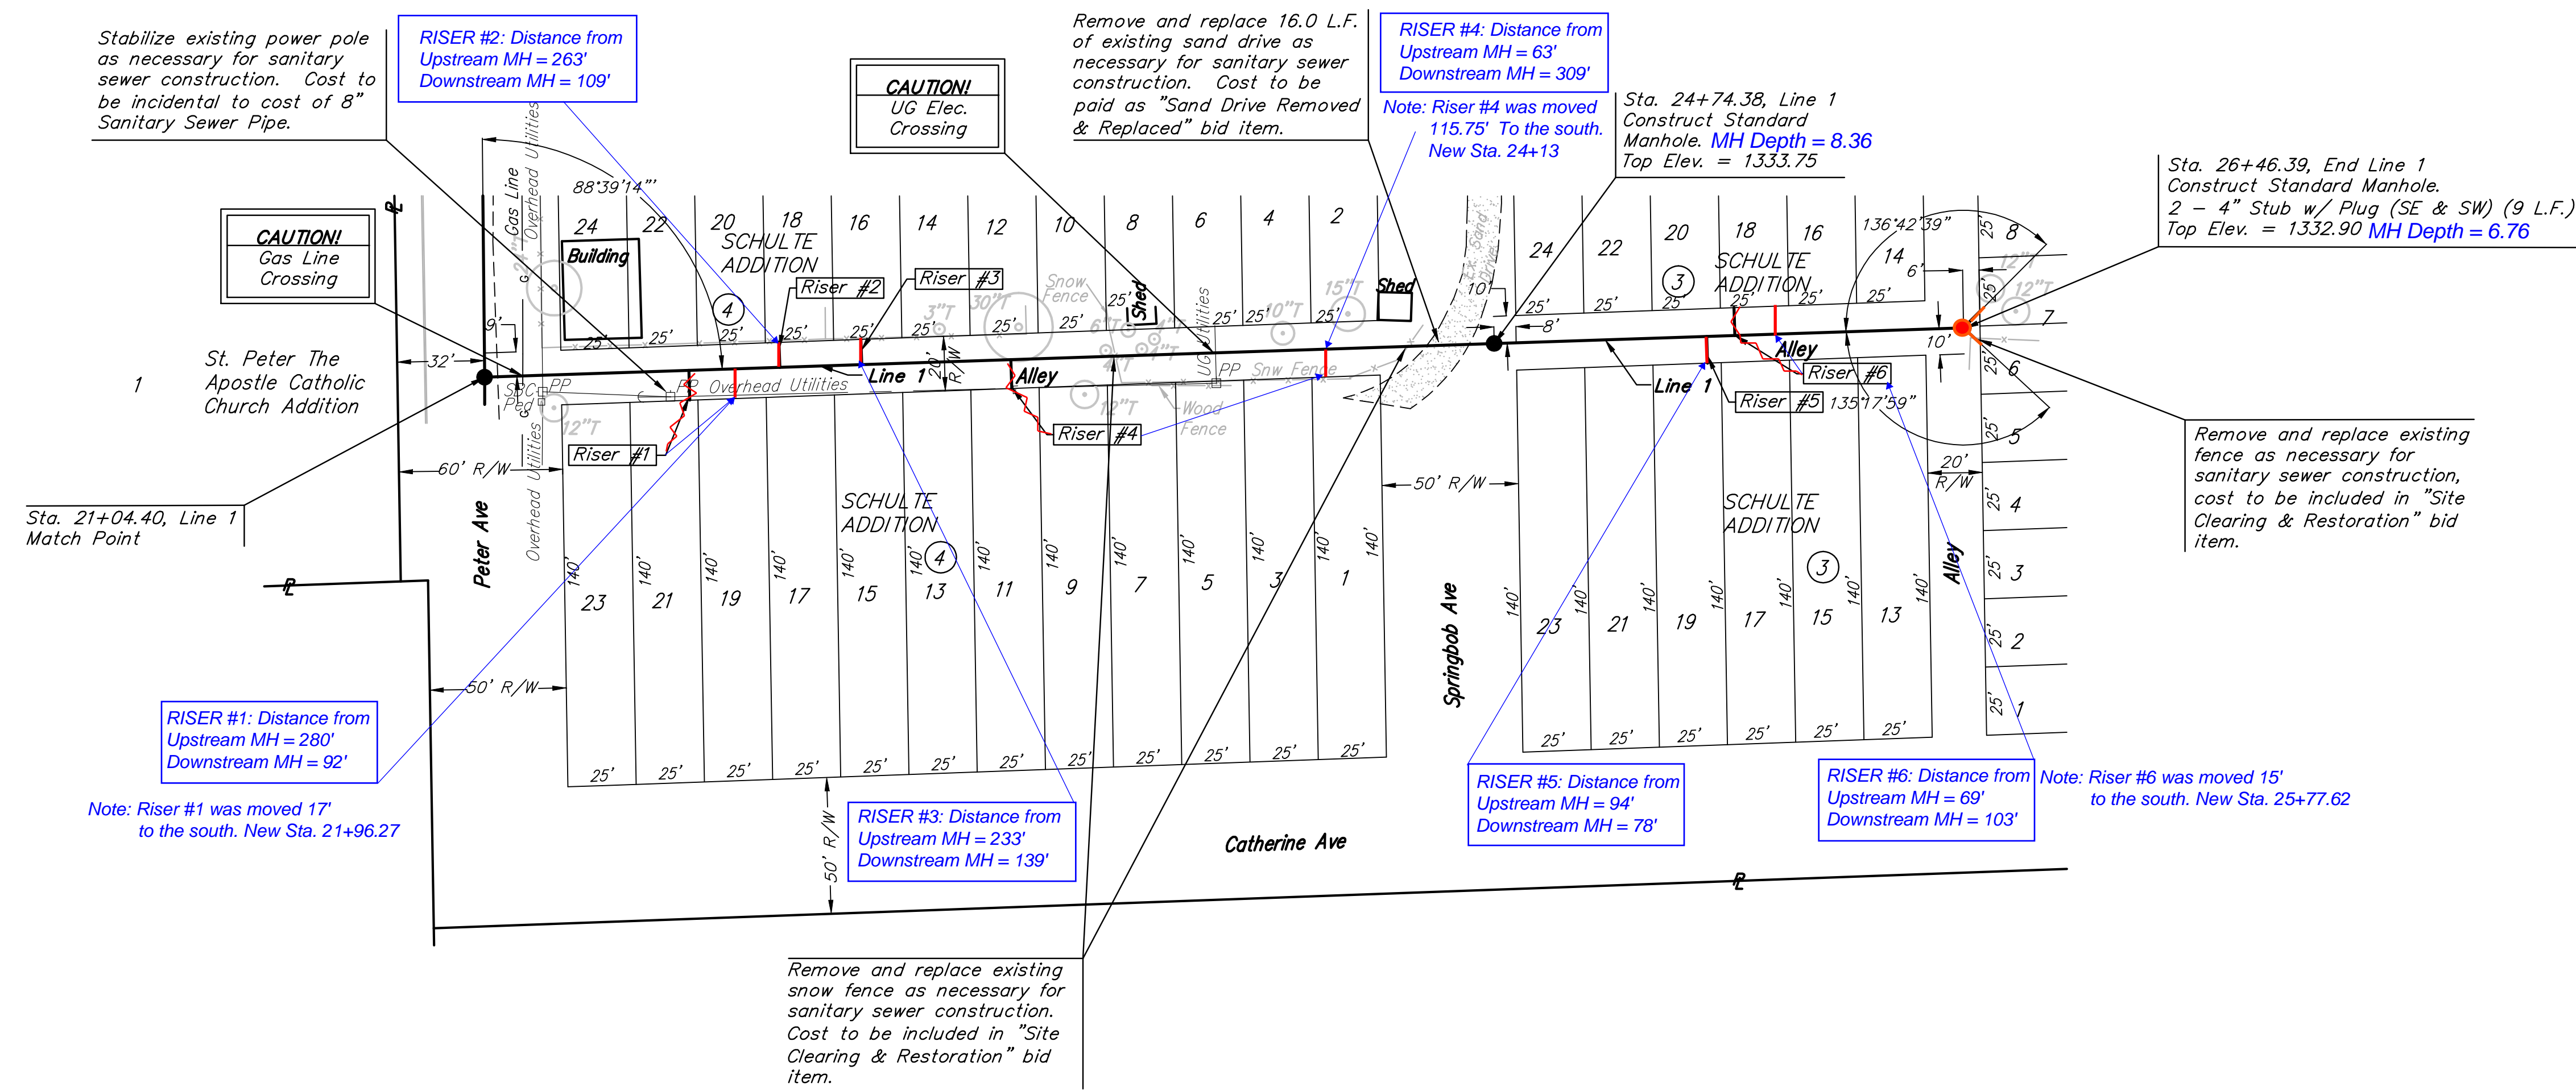

SCALE:  
 1" = 40' HORIZONTAL  
 1" = 5' VERTICAL  
 • = IRON

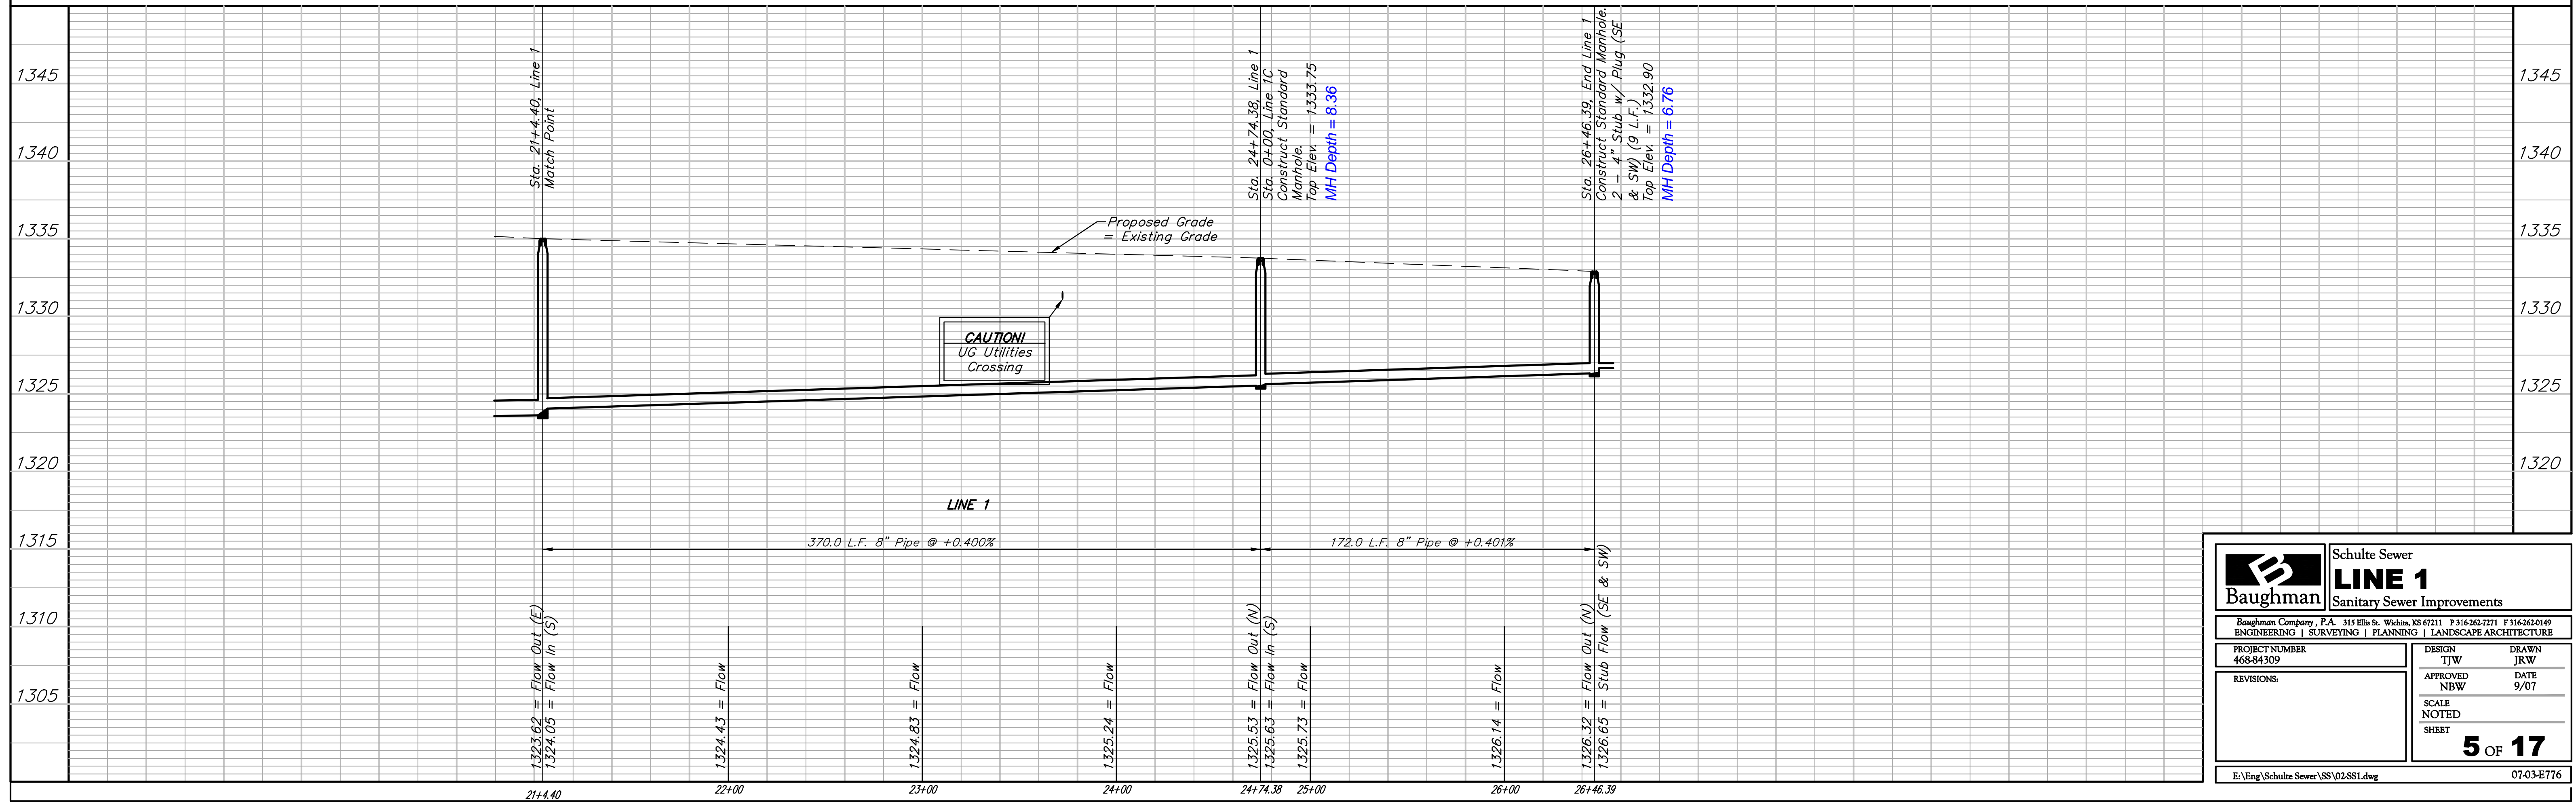

<b>Baughman</b>		Schulte Sewer	
		<b>LINE 1</b>	
		Sanitary Sewer Improvements	
Baughman Company, P.A. 315 Ellis St. Wichita, KS 67211 P 316-262-7271 F 316-262-0149 ENGINEERING   SURVEYING   PLANNING   LANDSCAPE ARCHITECTURE			
PROJECT NUMBER 468-84309	DESIGN TJW	DRAWN JRW	
REVISIONS:	APPROVED NBW	DATE 9/07	
	SCALE NOTED	SHEET	
	<b>5 OF 17</b>		
E:\Eng\Schulte Sewer\SS\02-SS1.dwg			07-03-E776