

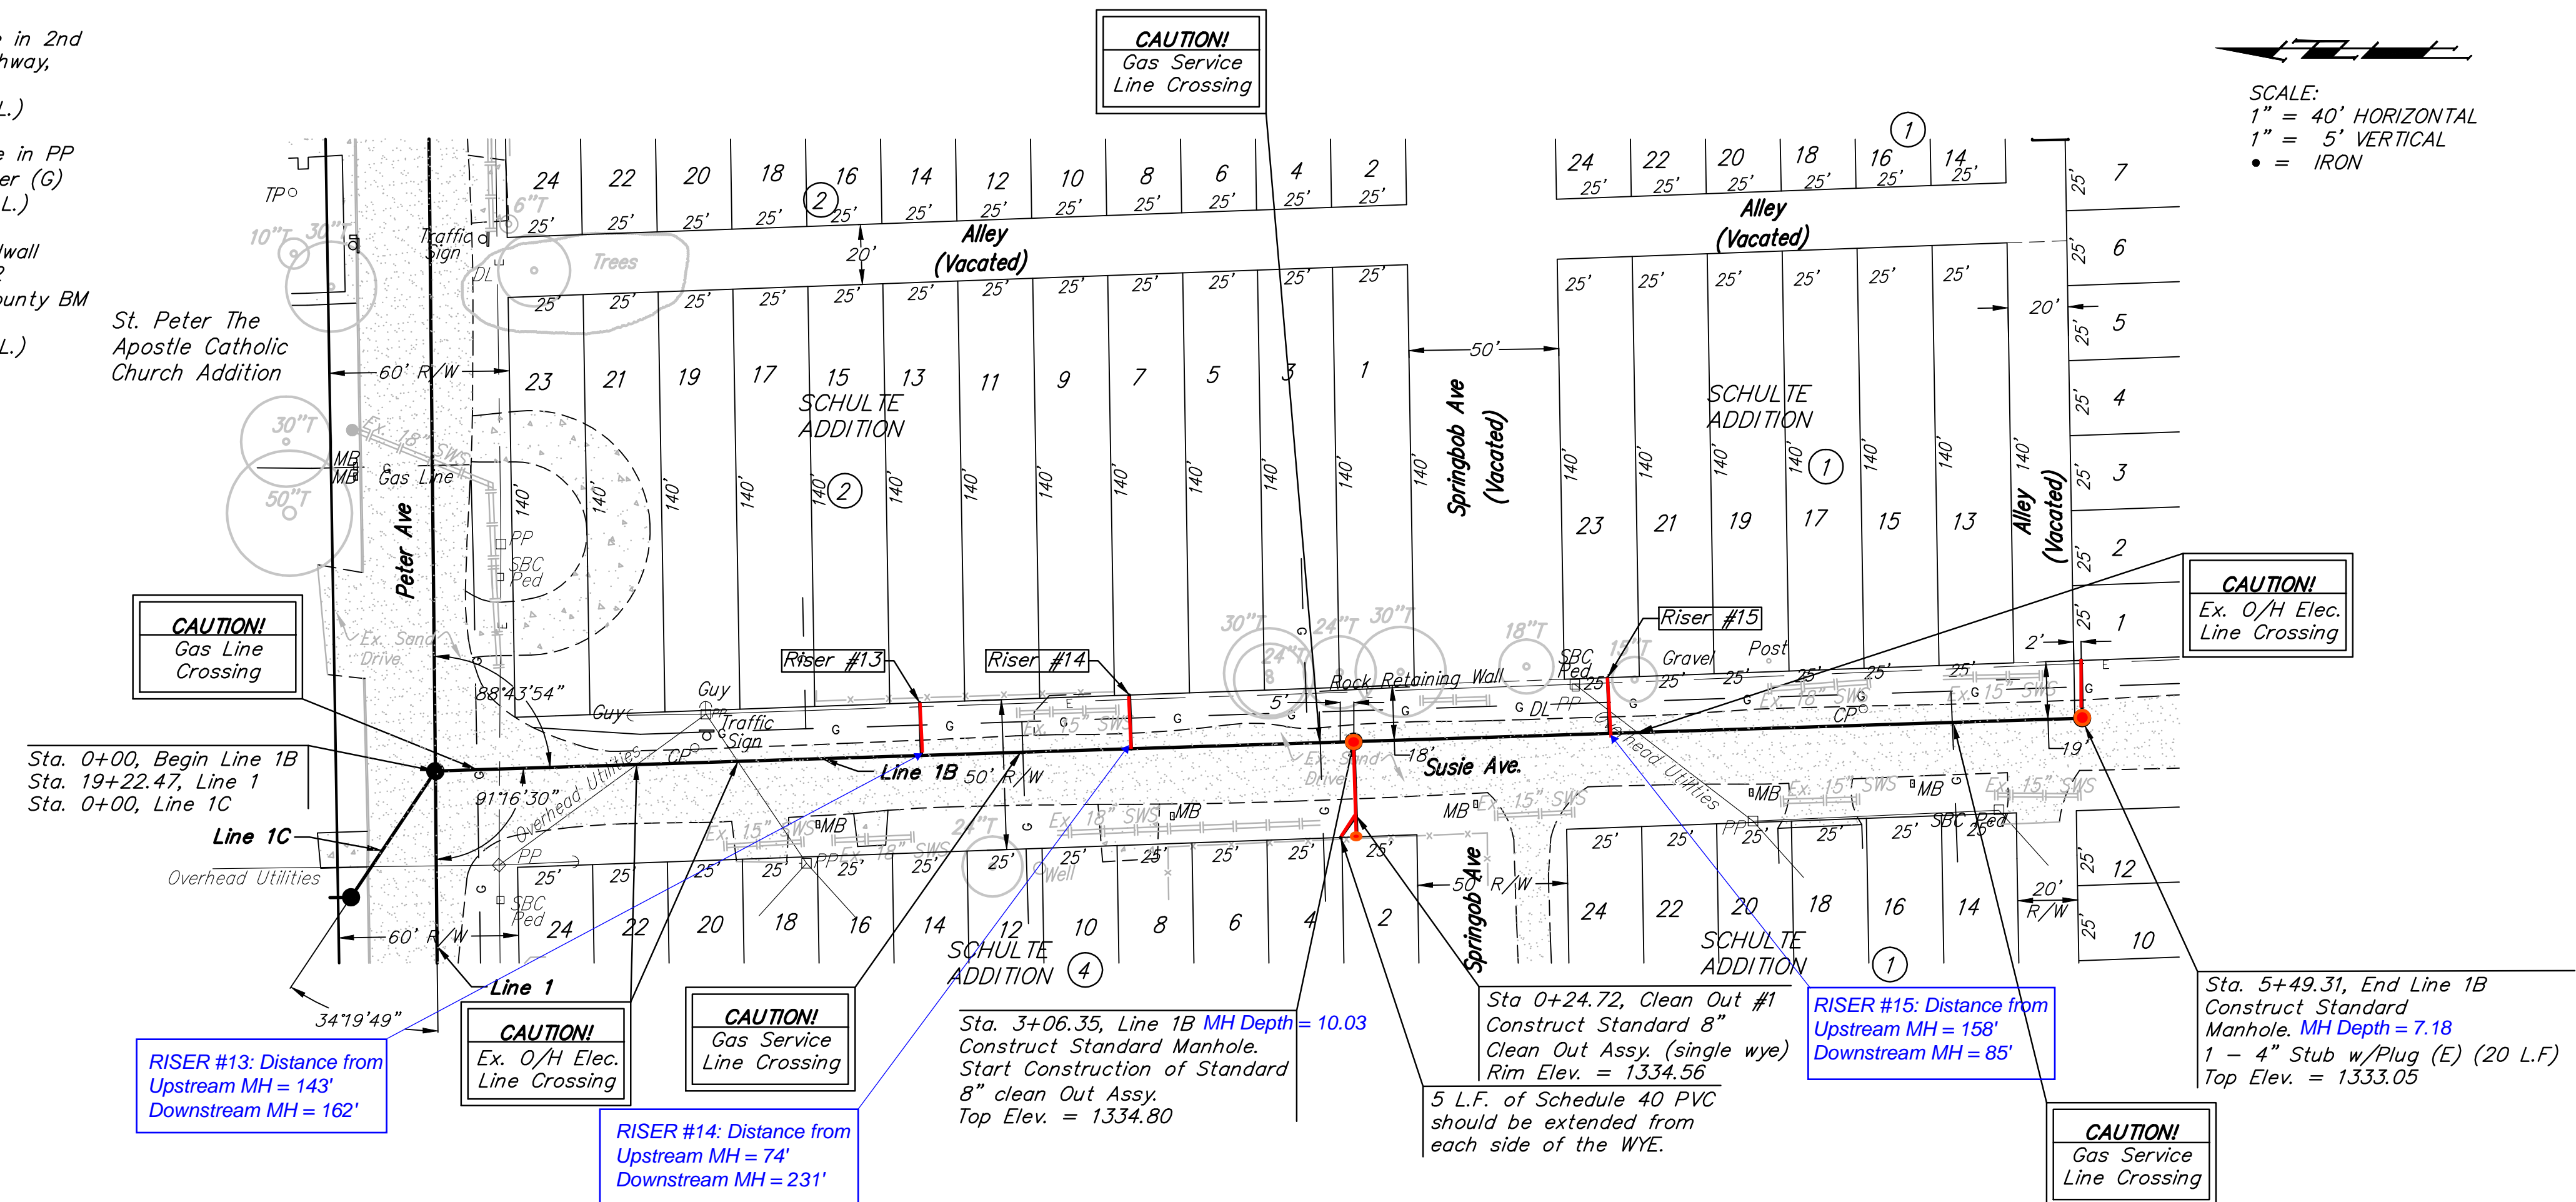


Benchmarks:
 BM #1: Small RR spike in 2nd PP north of K-42 Highway, west side of Maize Elev. = 1331.01 (M.S.L.)
 BM #2: Small RR spike in PP east of East 1/4 Corner (G) Elev. = 1334.40 (M.S.L.)
 BM #3: "□" Top Headwall southeast corner K-42 Highway and Maize (County BM with City Datum Elev. = 1331.44 (M.S.L.)

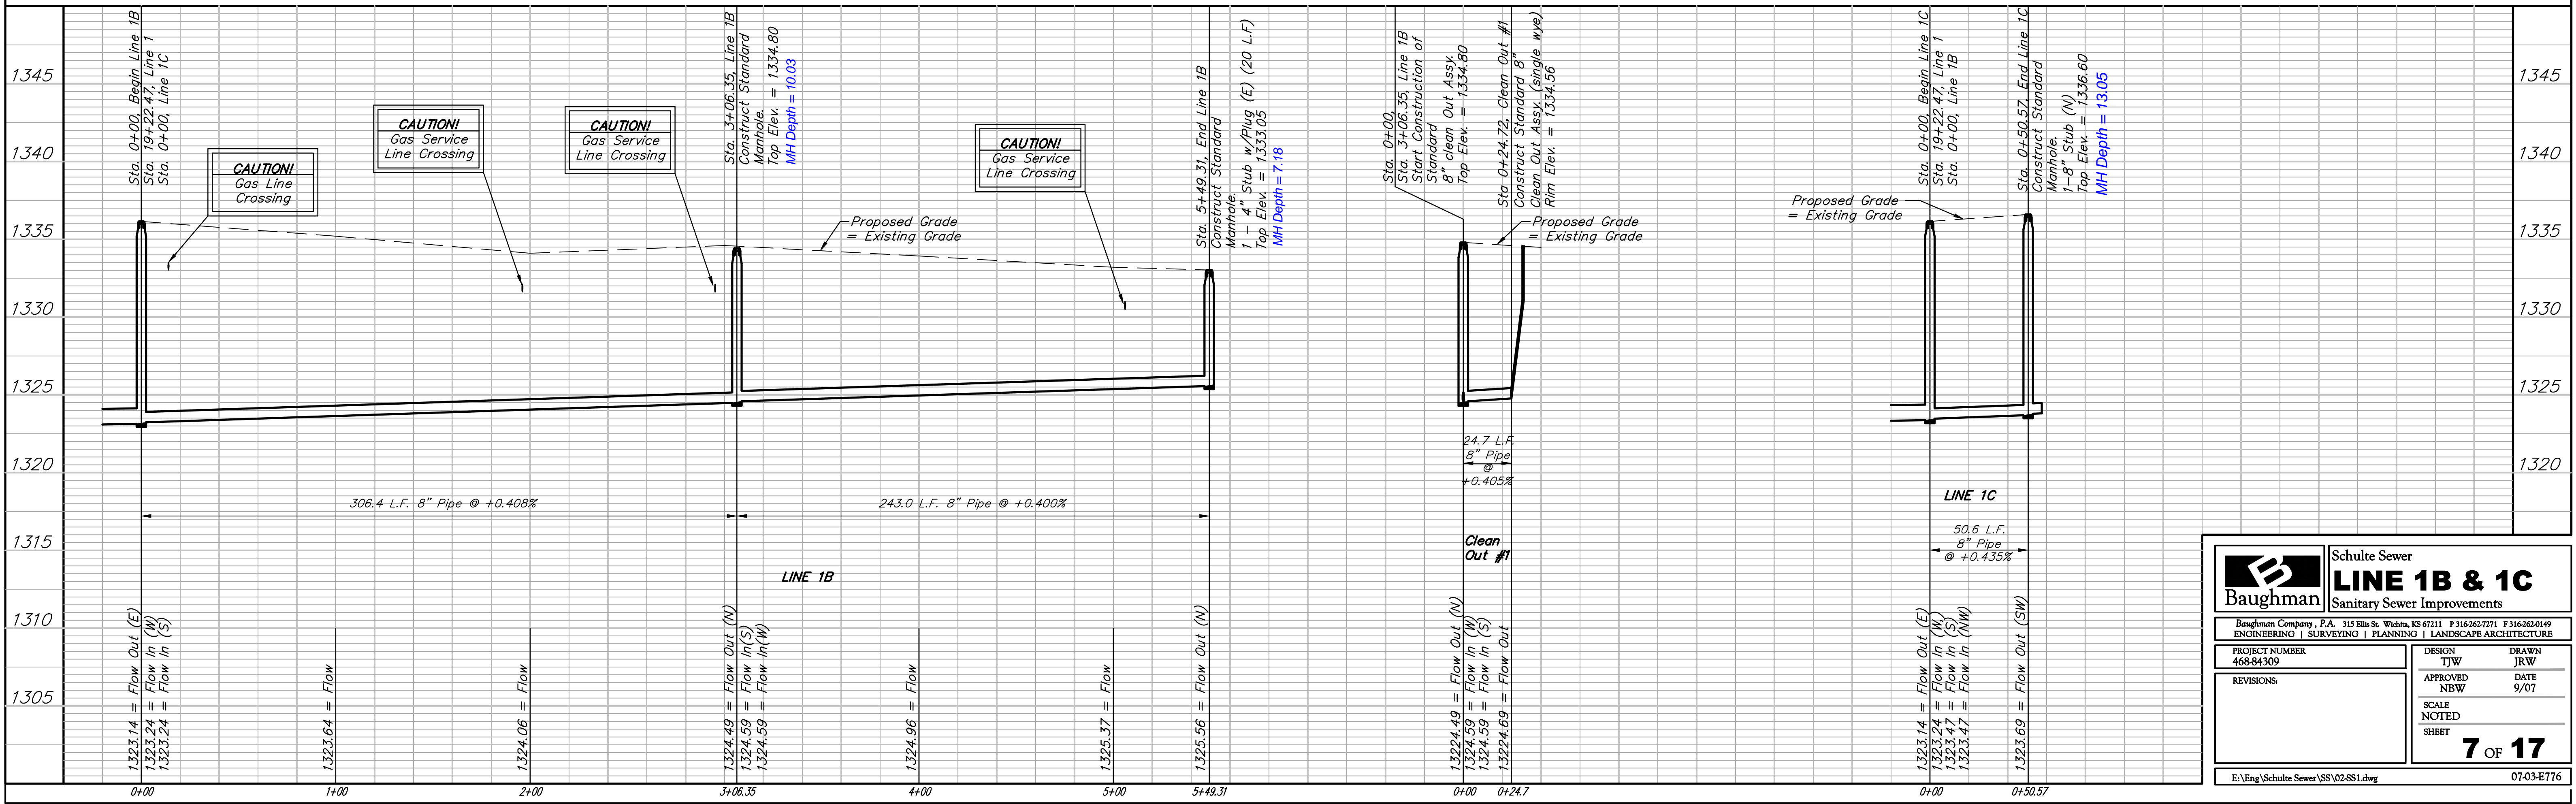

SCALE:
 1" = 40' HORIZONTAL
 1" = 5' VERTICAL
 • = IRON

SCALE:
 1" = 40' HORIZONTAL
 1" = 5' VERTICAL
 • = IRON

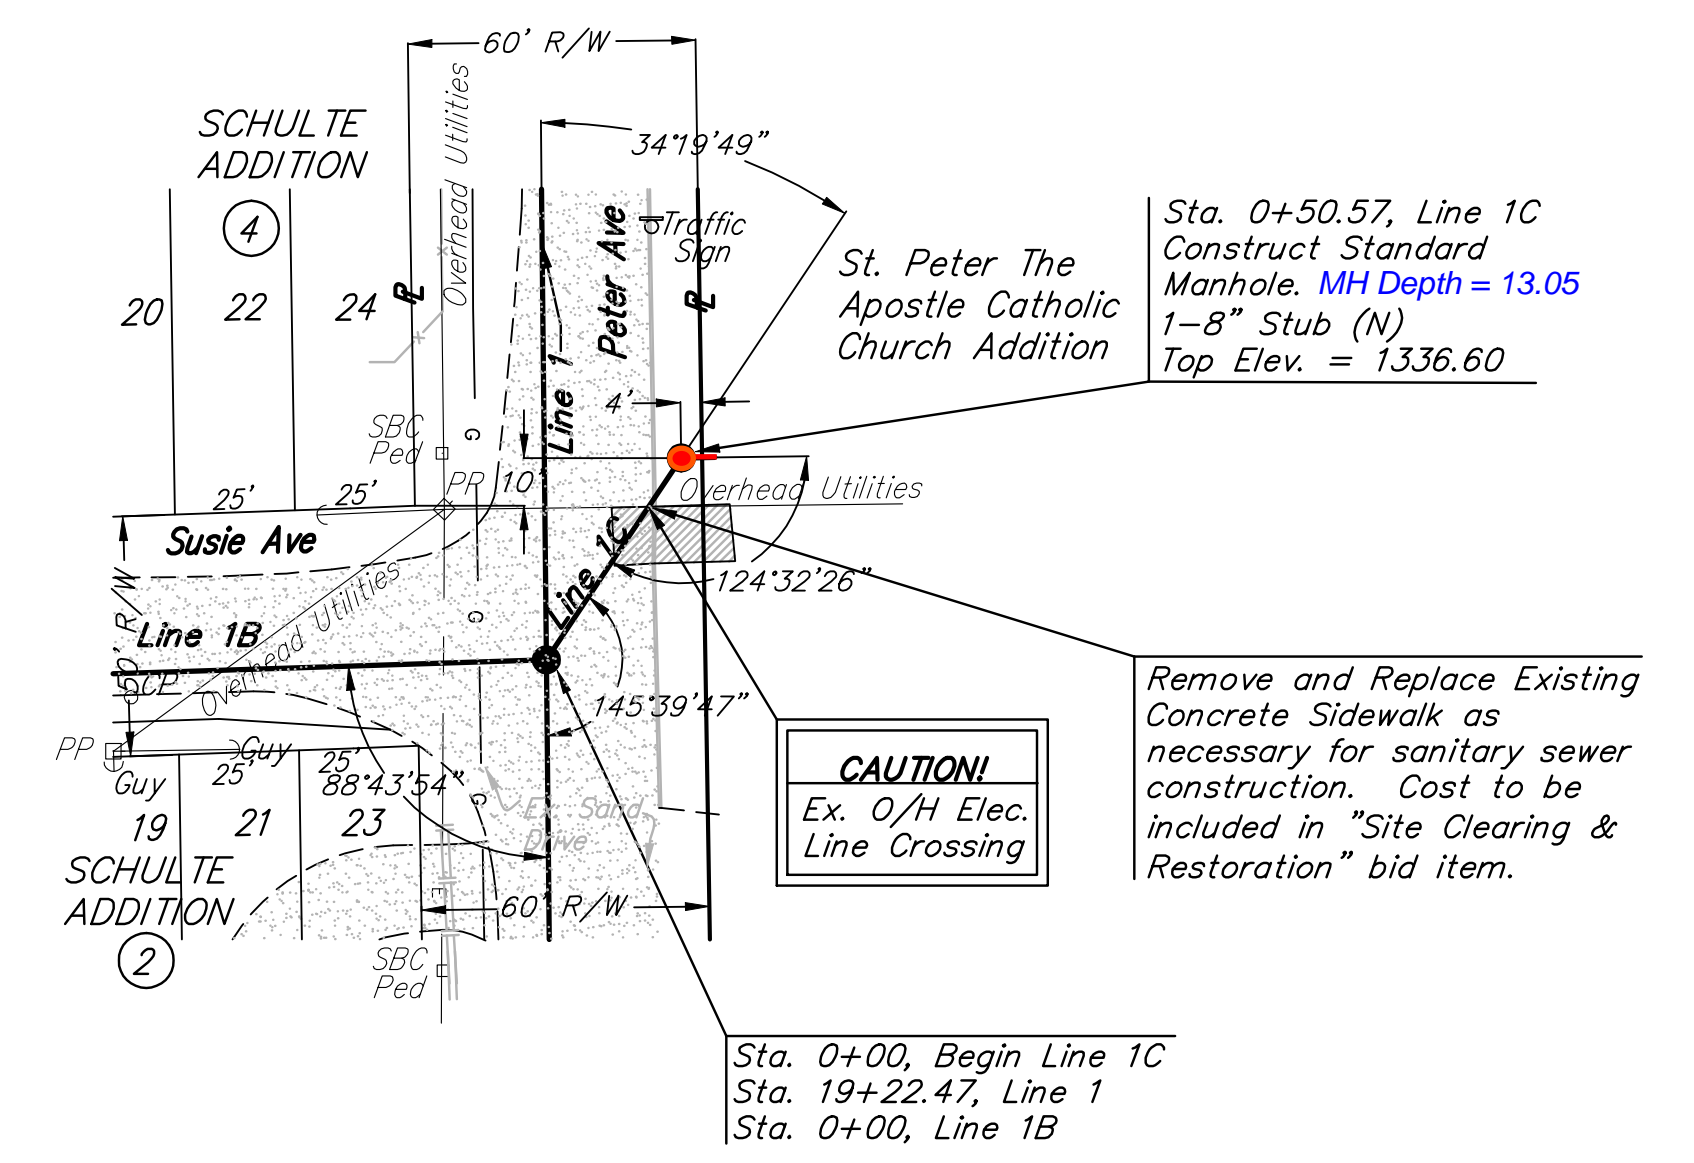

Baughman		Schulte Sewer	
LINE 1B & 1C		Sanitary Sewer Improvements	
Baughman Company, P.A. 315 Ellis St. Wichita, KS 67211 P 316-262-7271 F 316-262-0149 ENGINEERING SURVEYING PLANNING LANDSCAPE ARCHITECTURE			
PROJECT NUMBER 468-84309	DESIGN TJW	DRAWN JRW	DATE 9/07
REVISIONS:	APPROVED NBW	SCALE NOTED	SHEET 7 OF 17
E:\Eng\Schulte Sewer\SS\02-SS1.dwg			07-03-E716