
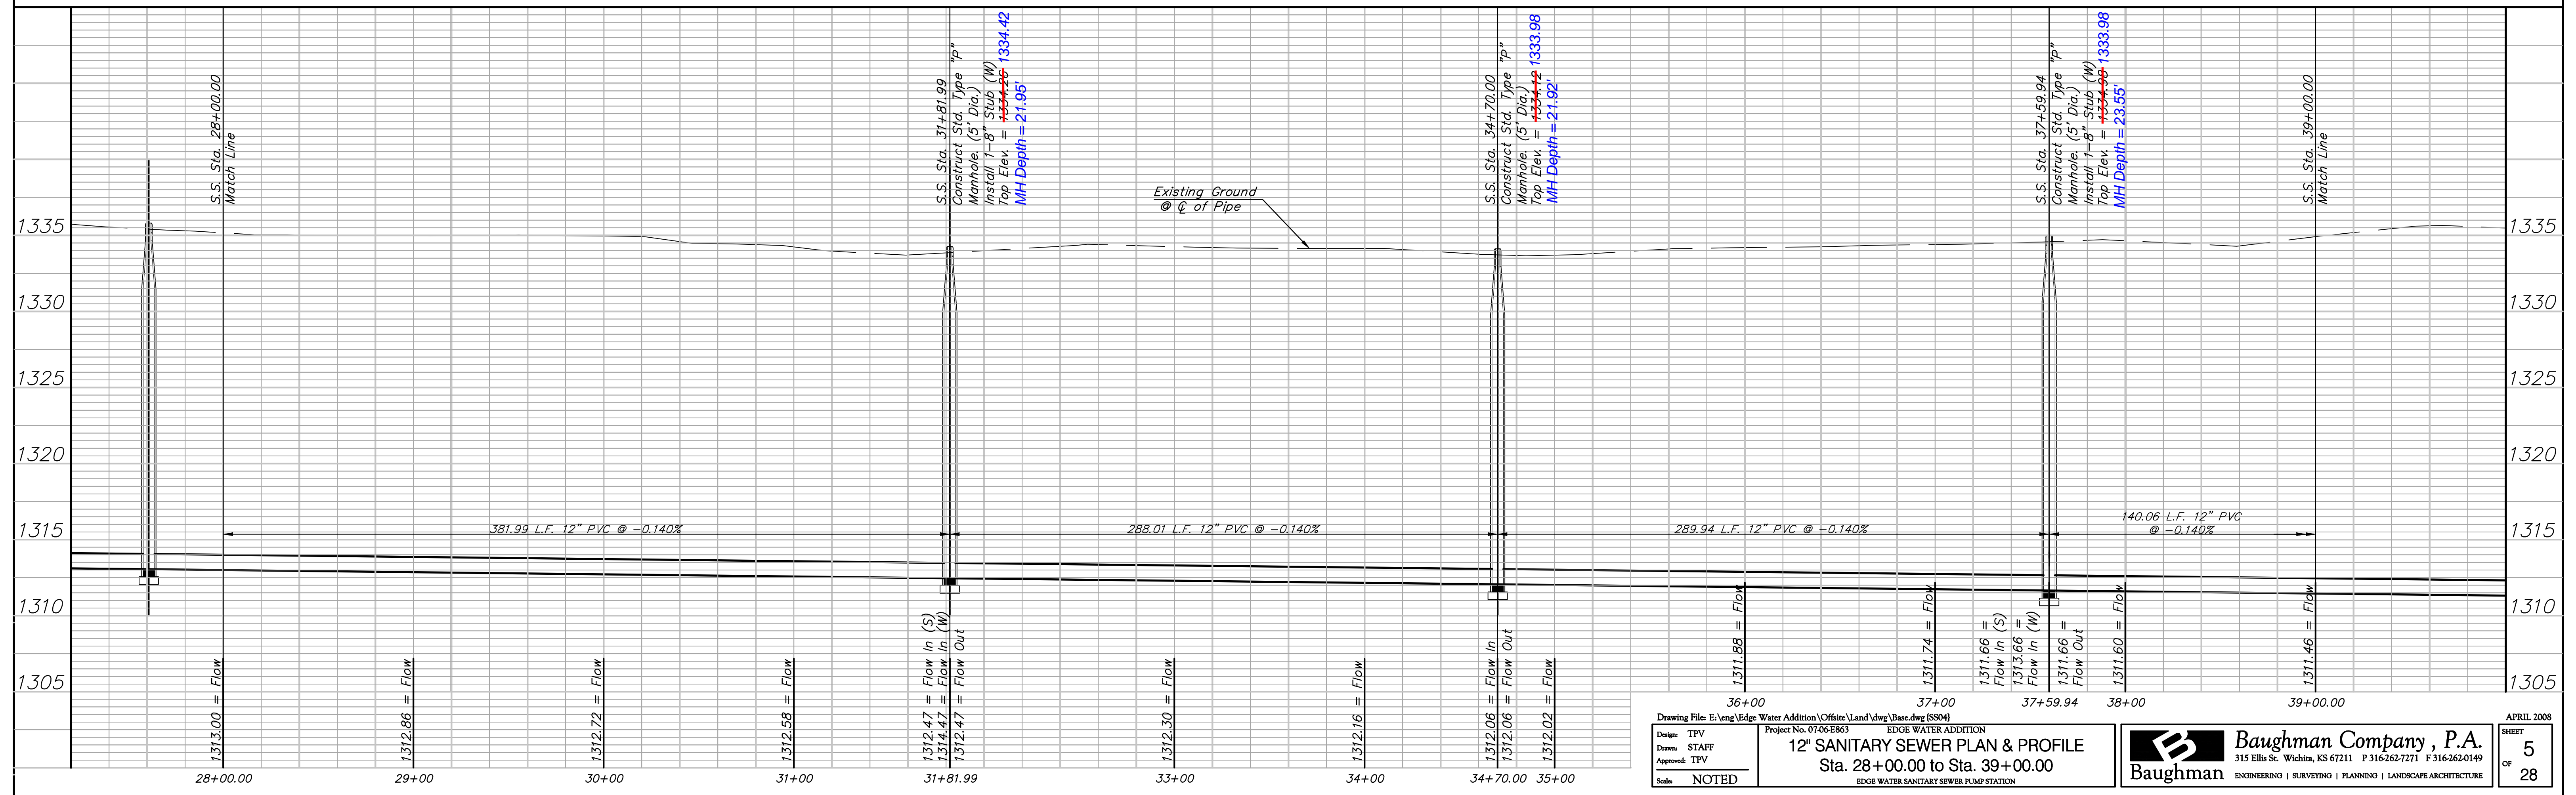


Reseed 1100 L.F. According to General Note 19 as Measured Along the Sewer Line from Sta. 28+00 to Sta. 39+00.

PK-176-1
R & R Realty, LLC

PK-177-2
R & R Realty, LLC

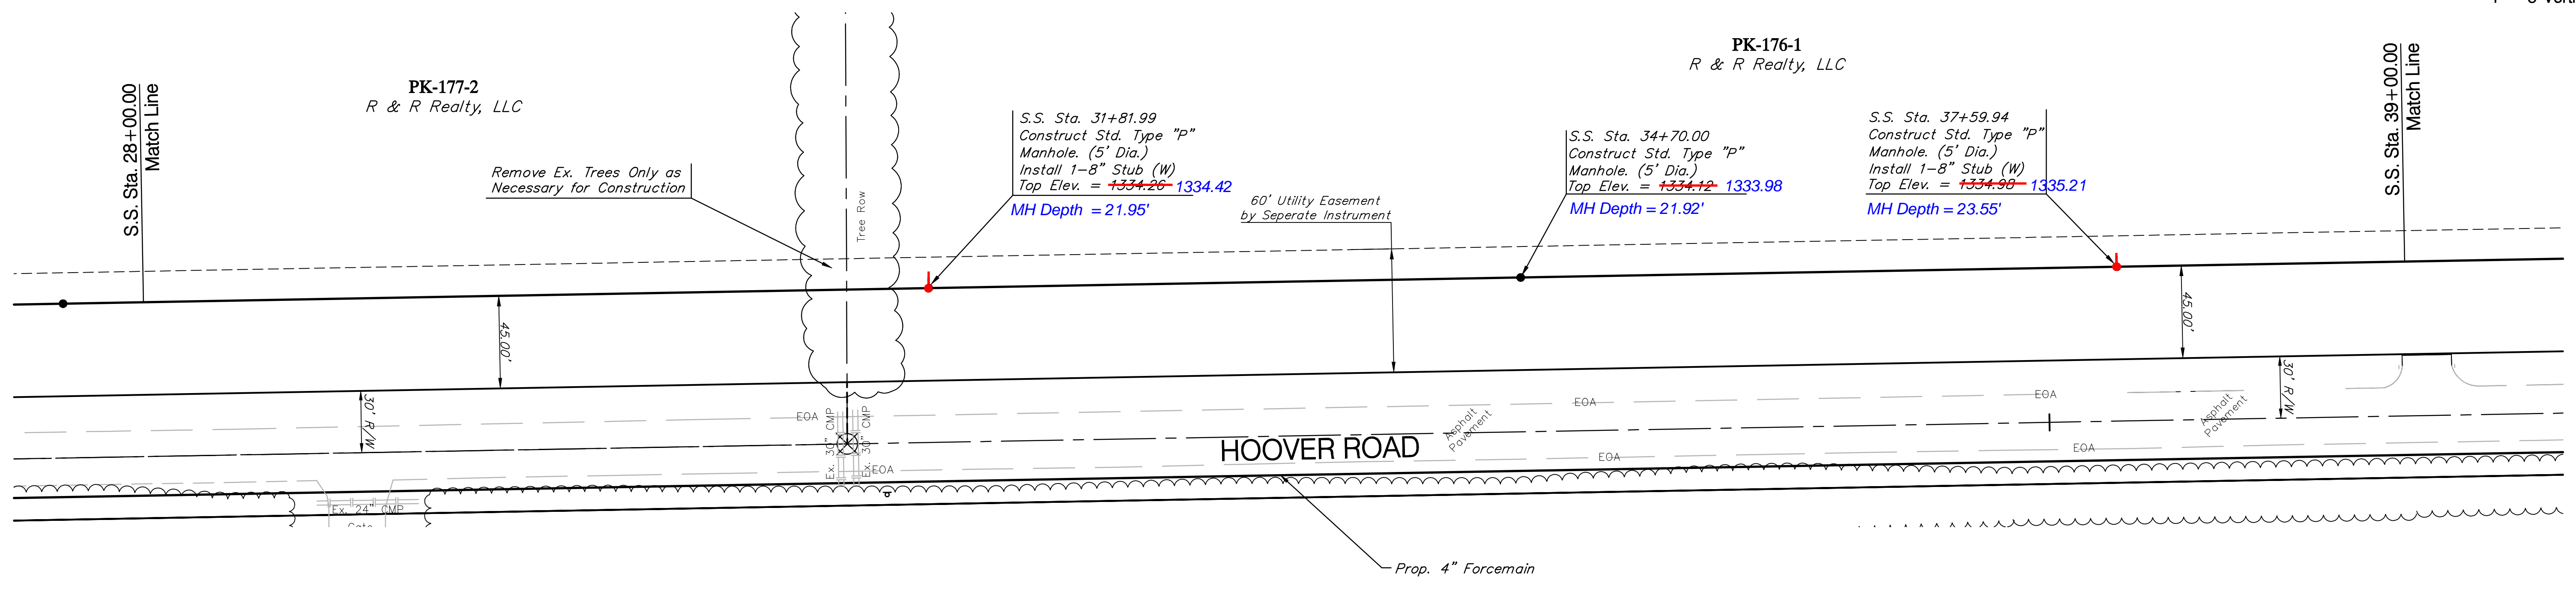

Drawing File: E:\eng\Edge Water Addition\Offsite\Land\dwg\Base.dwg (SS04) Project No. 07-06-E863 Design: TPV Drawn: STAFF Approved: TPV Scale: NOTED		EDGE WATER ADDITION 12" SANITARY SEWER PLAN & PROFILE Sta. 28+00.00 to Sta. 39+00.00 EDGE WATER SANITARY SEWER PUMP STATION		Baughman Company, P.A. 315 Ellis St. Wichita, KS 67211 P 316-262-7271 F 316-262-0149 ENGINEERING SURVEYING PLANNING LANDSCAPE ARCHITECTURE		APRIL 2008 SHEET 5 OF 28
---	--	---	--	---	--	--