BENCHMARK:
BM #6 – North Rim of Sanitary Sewer Manhole 100' East and 54' South of the Centerlines of Ridge Port and 37th St North.
B.L. Sta. 124+12.5, 45.9' Rt.
Elev. = 1332.71 (MSL)

SCALE:
1" = 40' Horizontal
1" = 5' Vertical

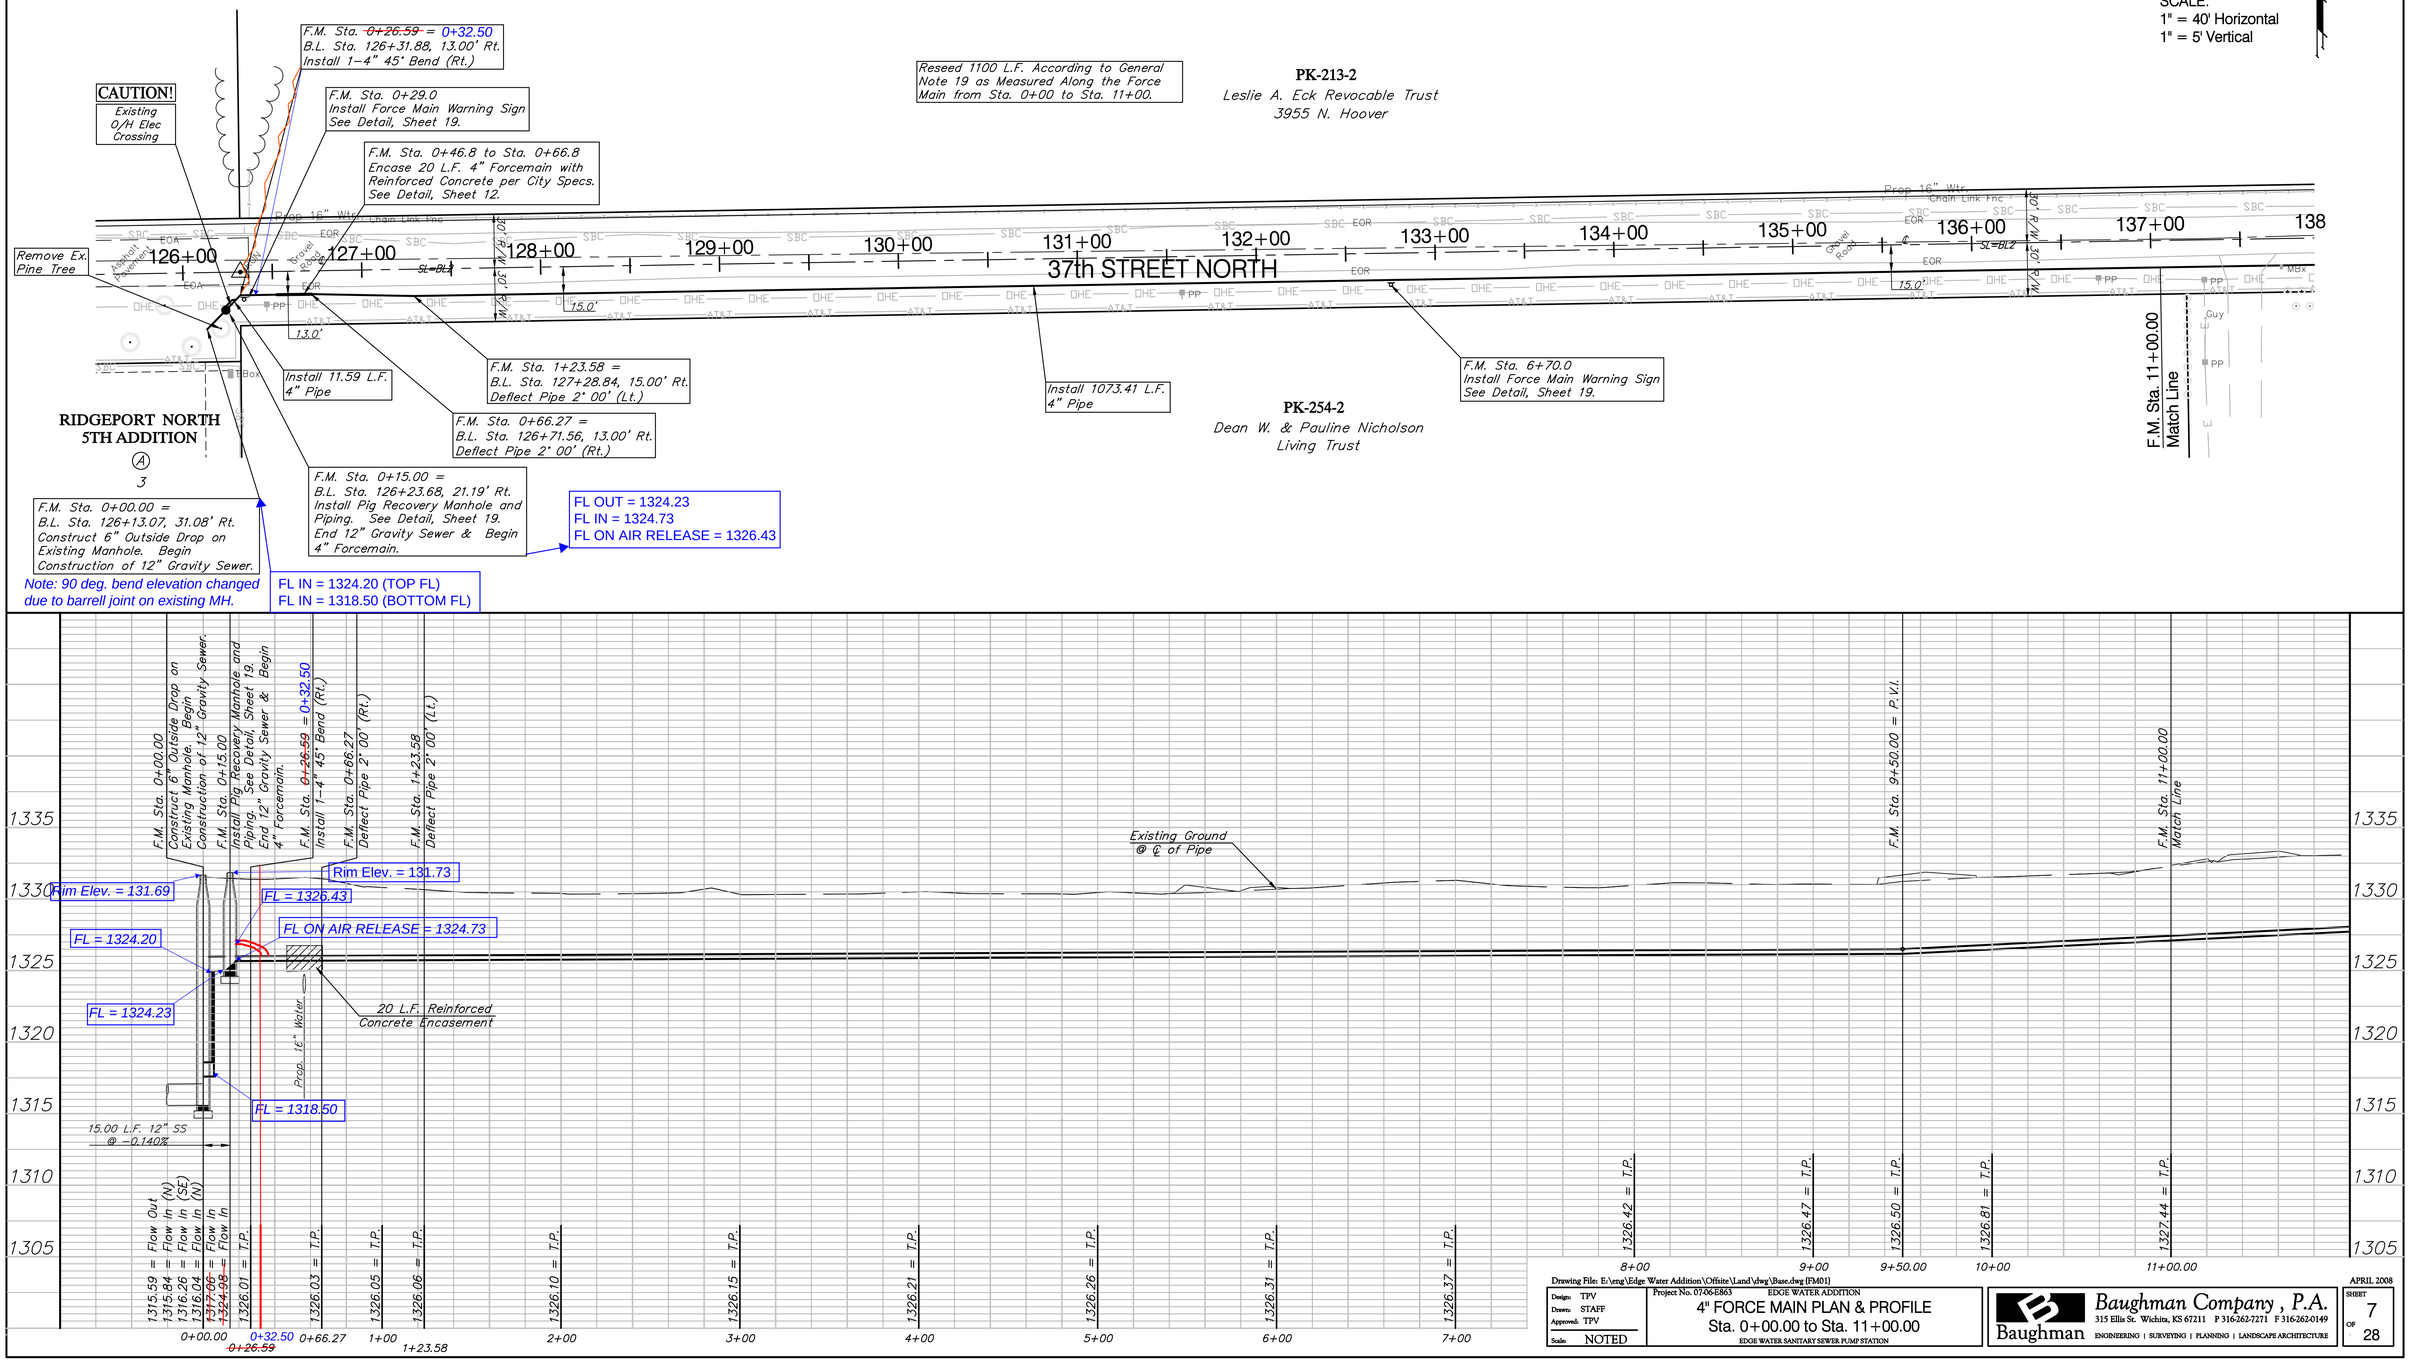

Drawing File: E:\eng\Edge Water Addition\Offsite\Land\dwg\Base.dwg [FM01]

Design: TPV	Project No. 07-06-E863	EDGE WATER ADDITION
Drawn: STAFF	4" FORCE MAIN PLAN & PROFILE	
Approved: TPV	Sta. 0+00.00 to Sta. 11+00.00	
Scale: NOTED	EDGE WATER SANITARY SEWER PUMP STATION	

Baughman Company, P.A.
315 Ellis St. Wichita, KS 67211 P 316-262-7271 F 316-262-0149
ENGINEERING | SURVEYING | PLANNING | LANDSCAPE ARCHITECTURE

APRIL 2008
SHEET 7 OF 28