




BENCHMARK:
 BM #1 - COW Benchmark 28.5' East and 14.5' North of the Centerlines of Hoover Road and 45th Street North.
 B.L. Sta. 249+18.1, 30.2' Rt.
 Elev. = 1335.29 (MSL)

Reseed 1100 L.F. According to General Note 19 as Measured Along the Force Main from Sta. 86+00 to Sta. 97+00.

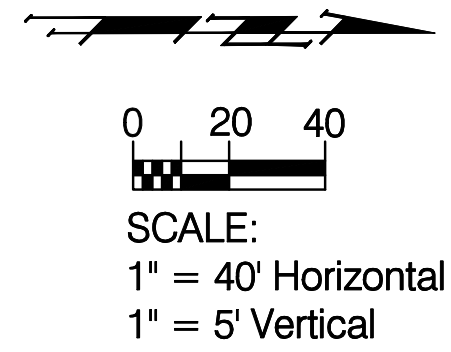

PK-177-2
 R & R Realty, LLC

PK-176-1
 R & R Realty, LLC

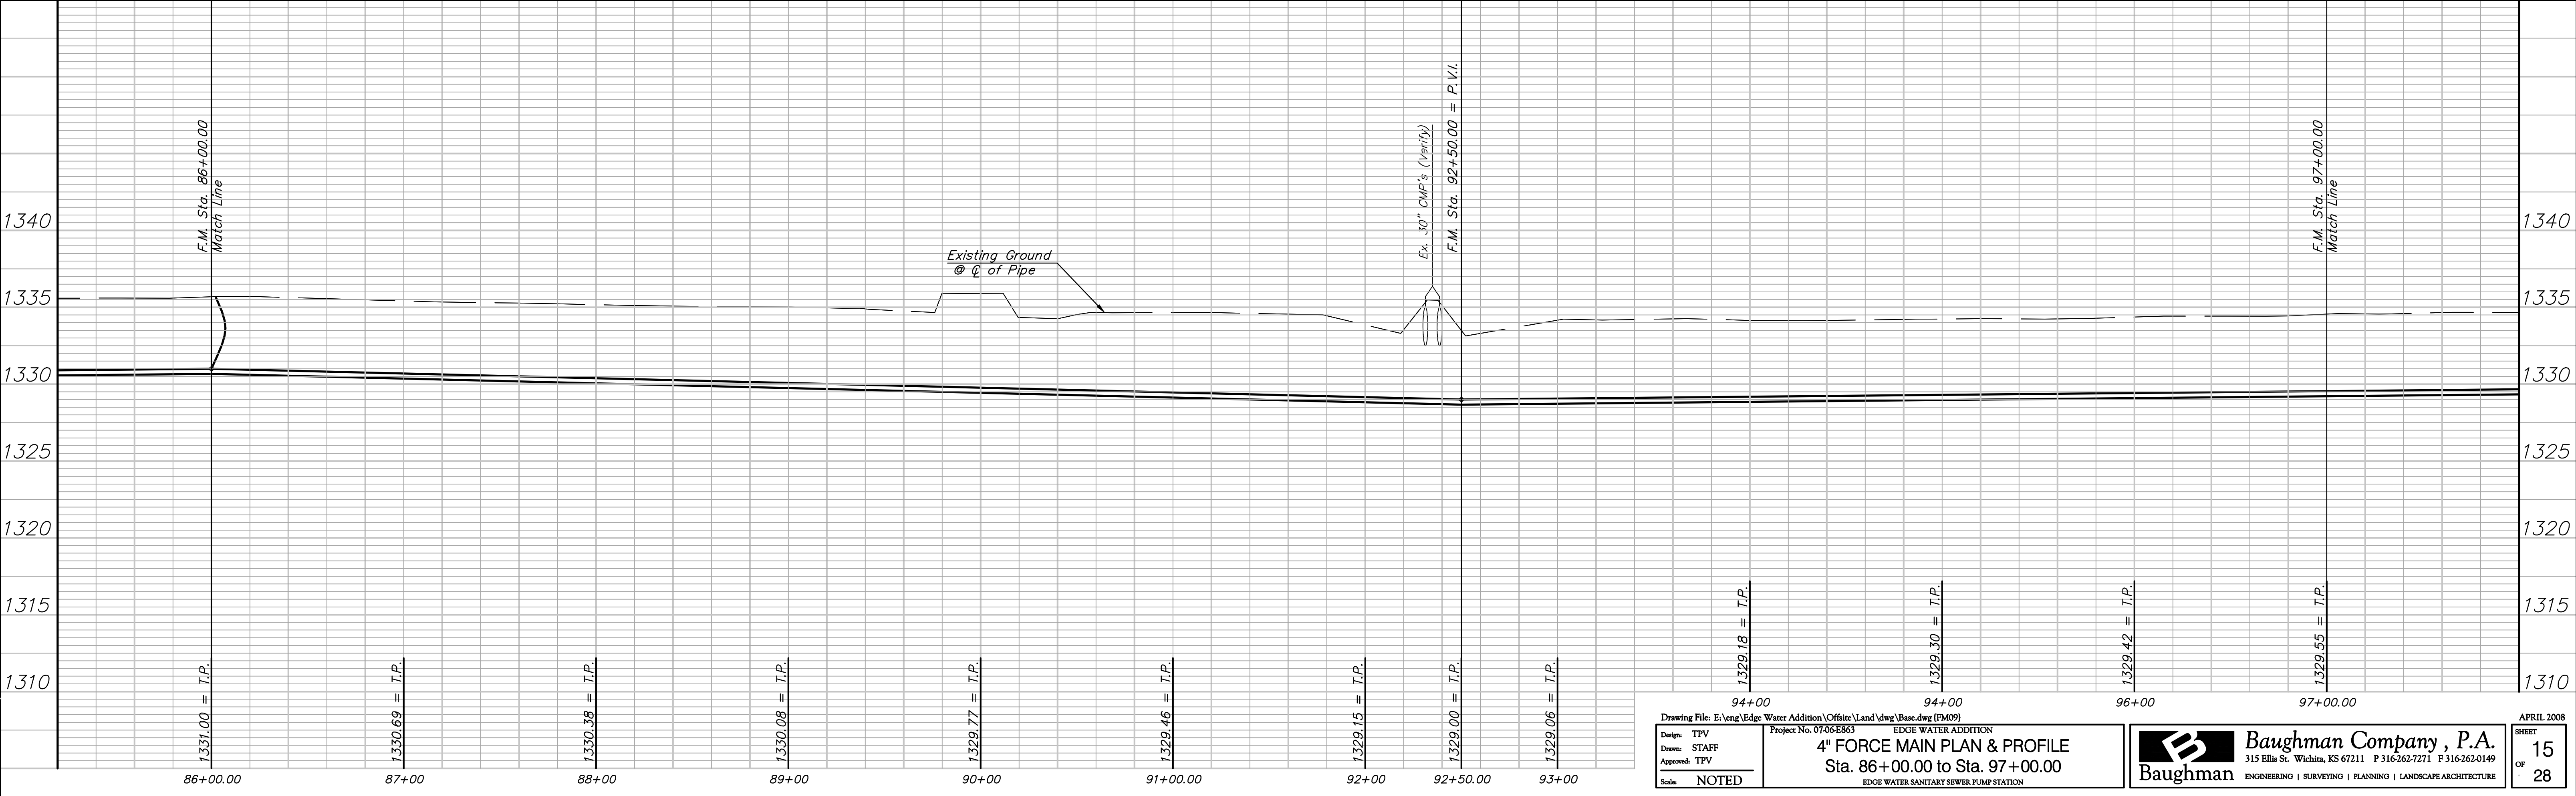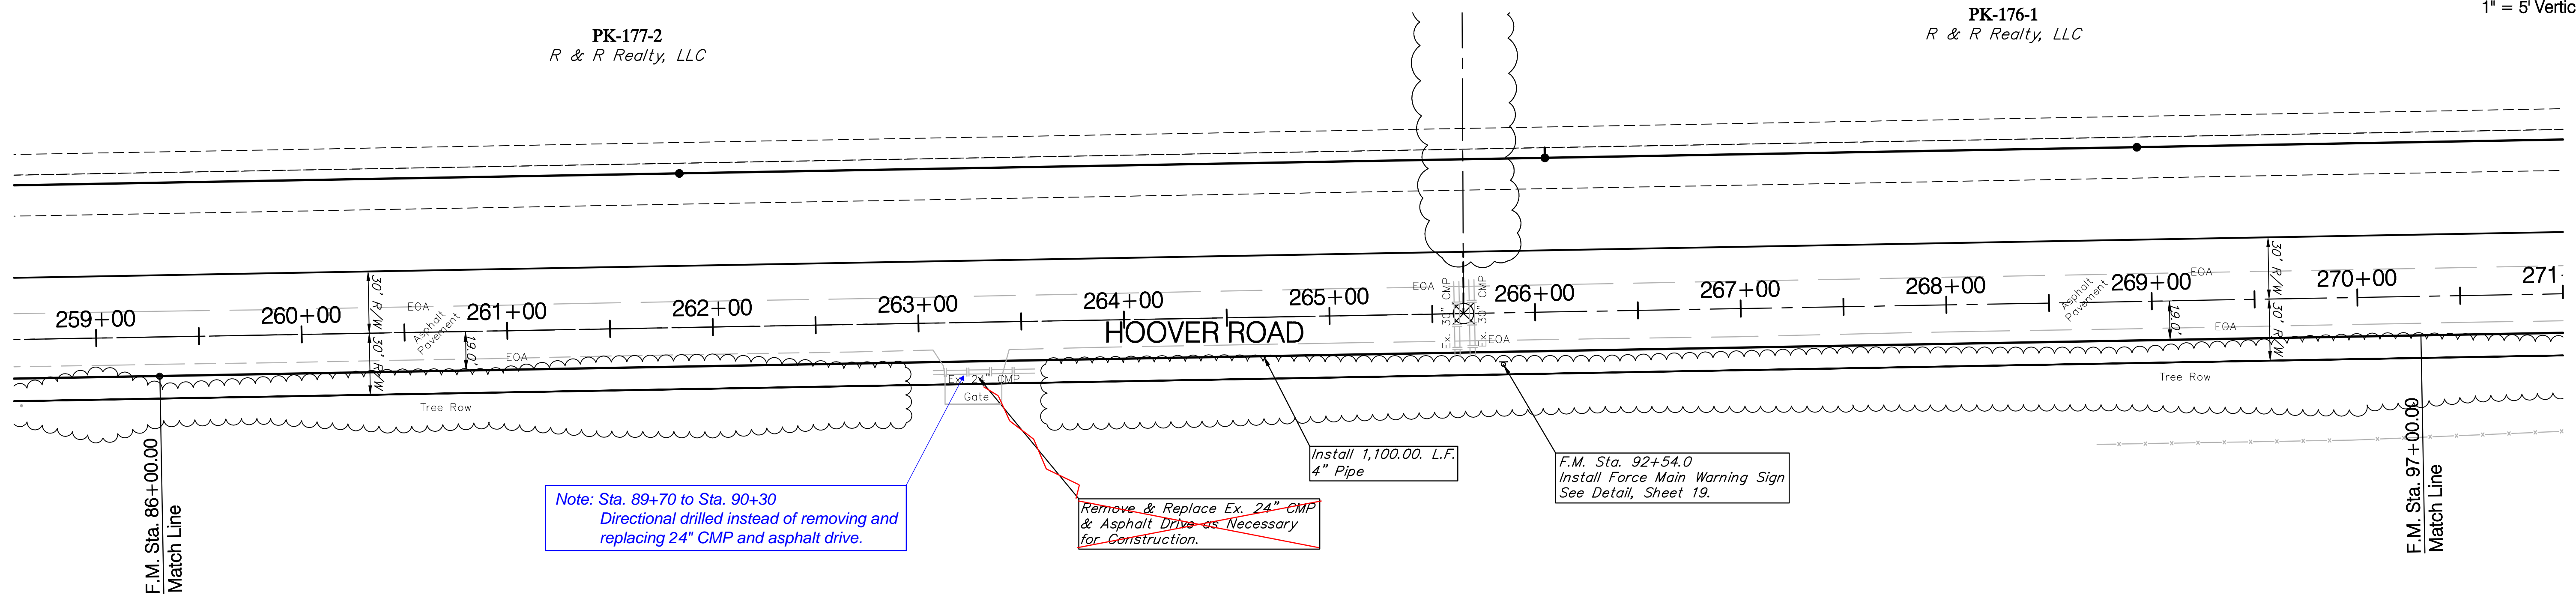

Drawing File: E:\eng\Edge Water Addition\Offsite\Land\dwg\Basc.dwg (FM09) Project No. 07-06-E863 Design: TPV Drawn: STAFF Approved: TPV Scale: NOTED		EDGE WATER ADDITION 4" FORCE MAIN PLAN & PROFILE Sta. 86+00.00 to Sta. 97+00.00 EDGE WATER SANITARY SEWER PUMP STATION		Baughman Company, P.A. 315 Ellis St. Wichita, KS 67211 P 316-262-7271 F 316-262-0149 Baughman ENGINEERING SURVEYING PLANNING LANDSCAPE ARCHITECTURE		APRIL 2008 SHEET 15 OF 28
---	--	--	--	--	--	---