



**WATER DISTRIBUTION SYSTEM
MONARCH LANDING SECOND ADDITION
PHASE 2 PART A**

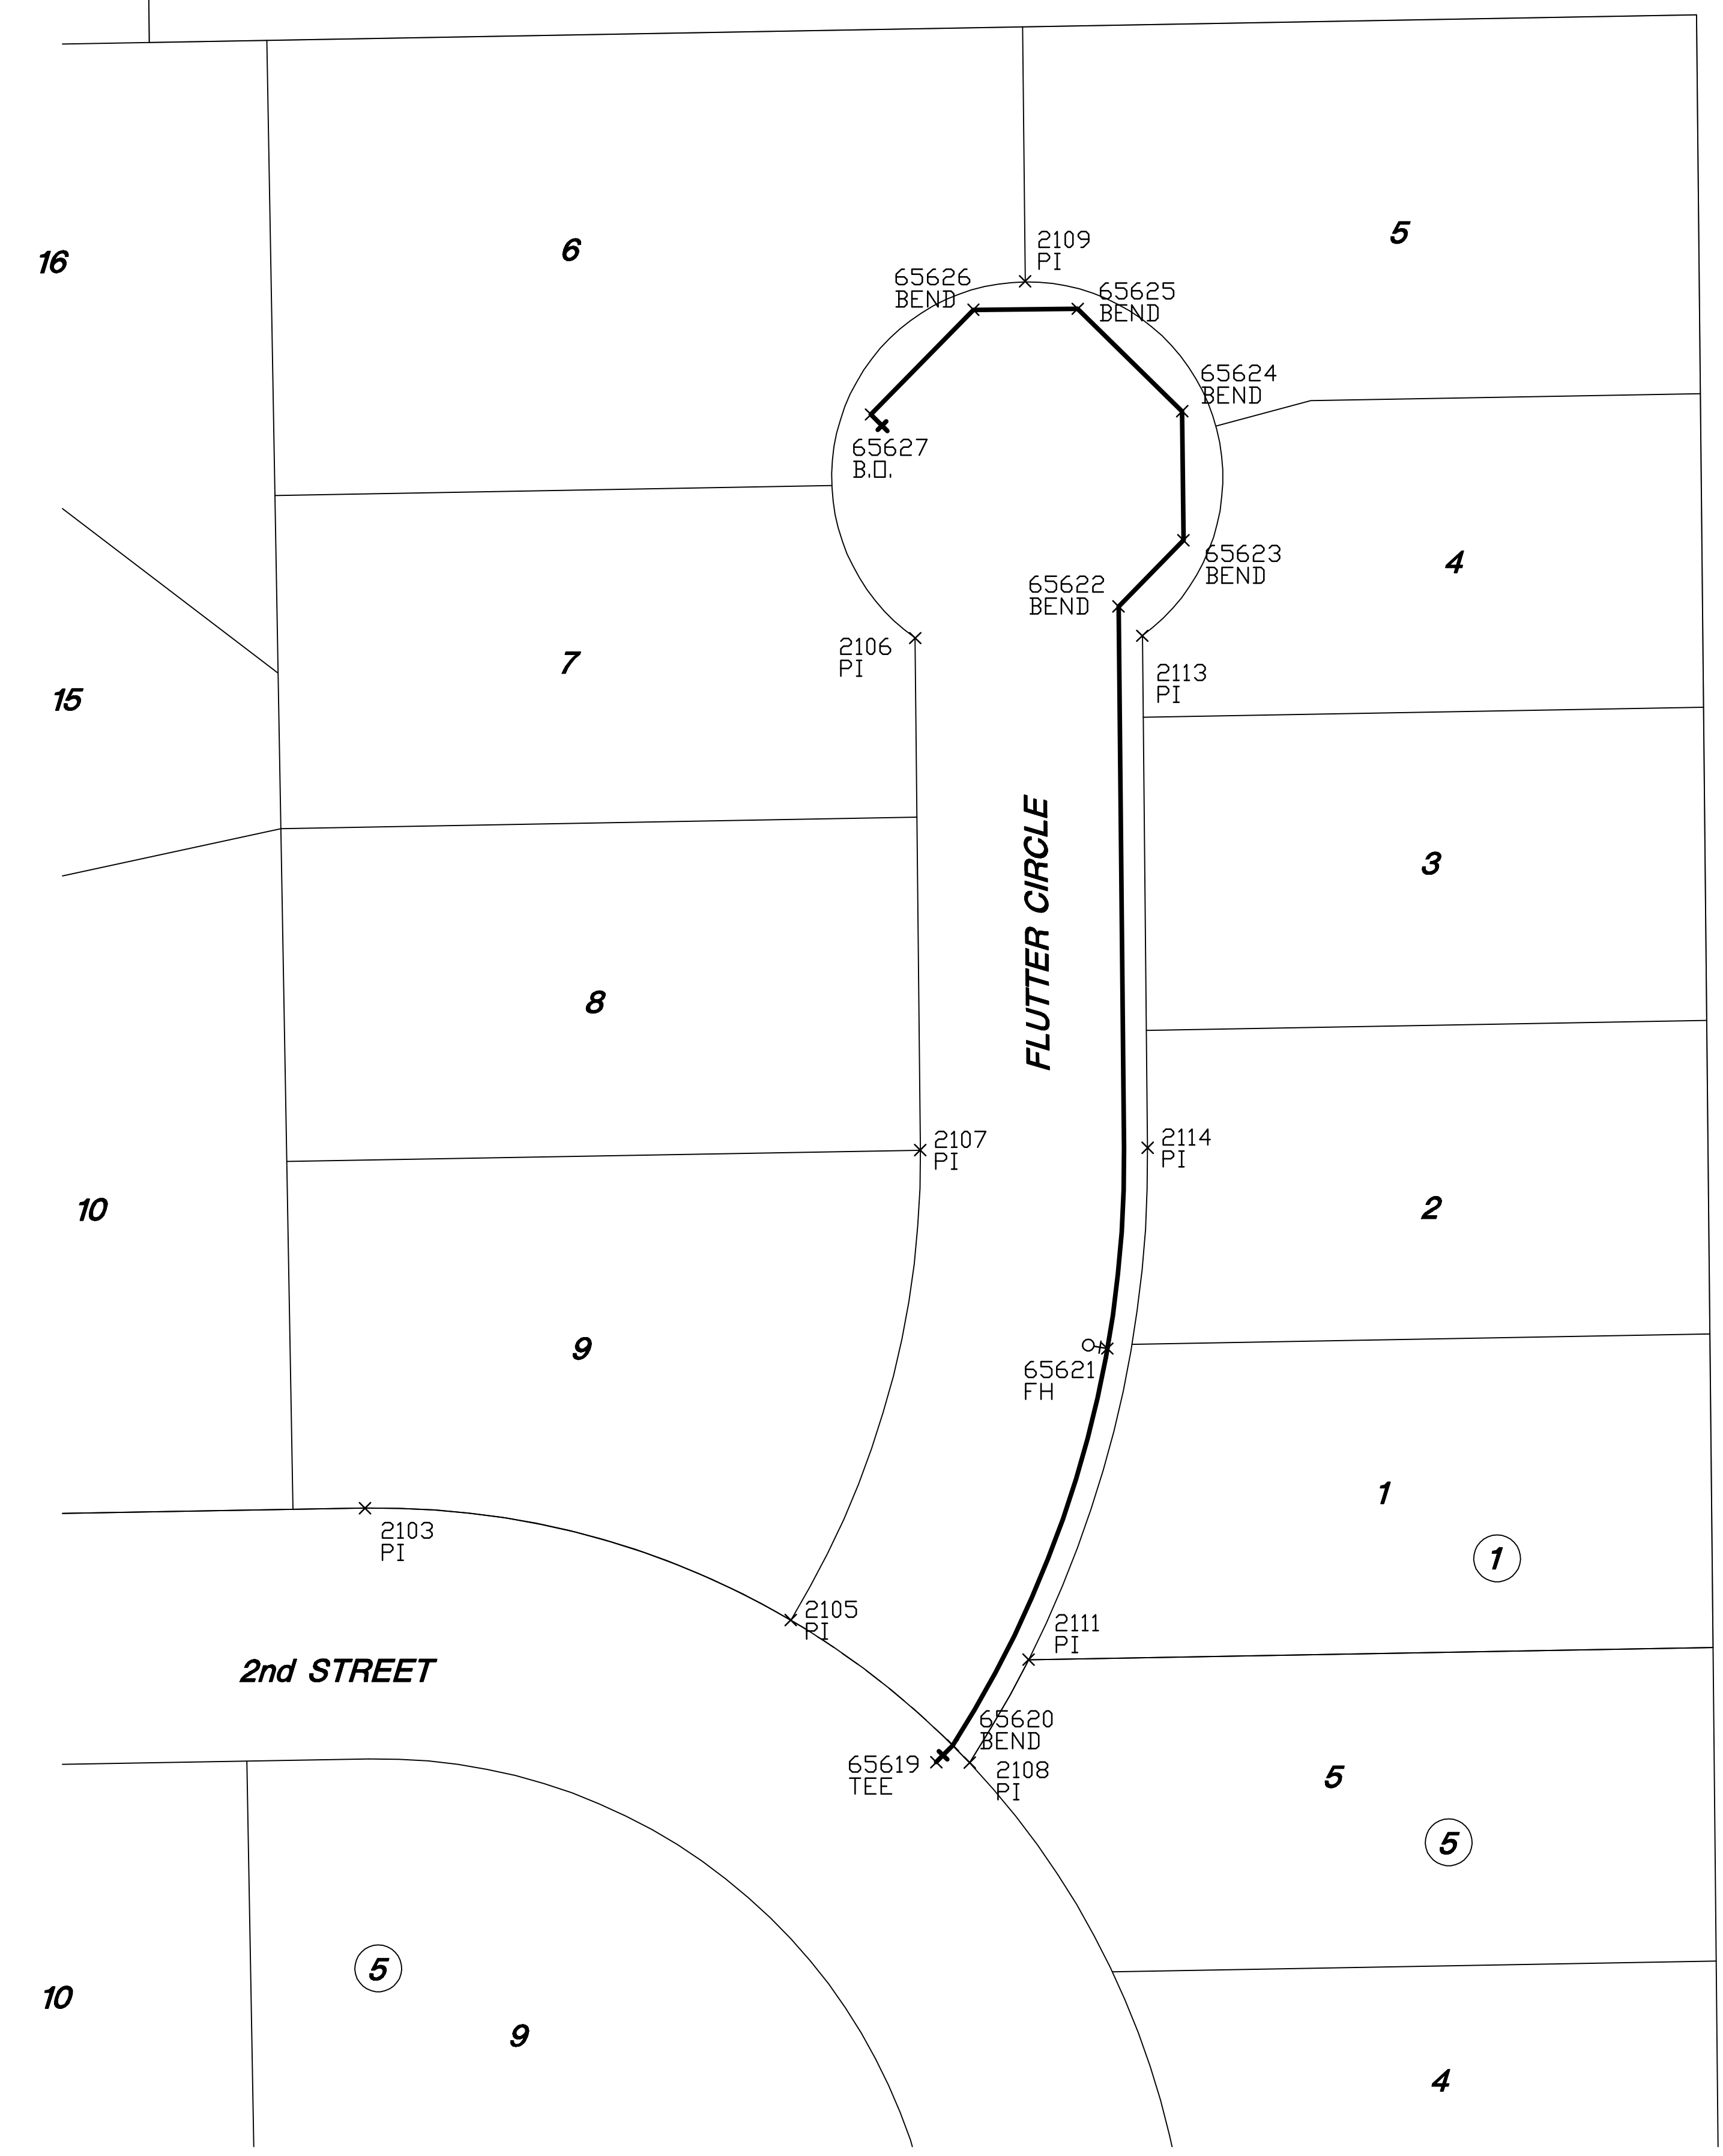

WATER POINTS			
Point #	Northing	Easting	Desc.
65619	1701616.19	1700976.68	TEE
65620	1701620.43	1700980.92	BEND
65621	1701721.71	1701020.39	FH
65622	1701911.09	1701023.23	BEND
65623	1701927.99	1701039.79	BEND
65624	1701960.89	1701039.46	BEND
65625	1701987.06	1701012.77	BEND
65626	1701986.79	1700986.17	BEND
65627	1701960.10	1700960.01	B.O.

PLAT IRONS			
Point #	Northing	Easting	Desc.
2103	1701680.98	1700830.90	PI
2105	1701652.41	1700939.58	PI
2106	1701903.02	1700971.31	PI
2107	1701772.33	1700972.61	PI
2108	1701616.01	1700985.21	PI
2109	1701994.04	1700999.40	PI
2111	1701642.30	1701000.26	PI
2113	1701903.60	1701029.30	PI
2114	1701772.91	1701030.61	PI

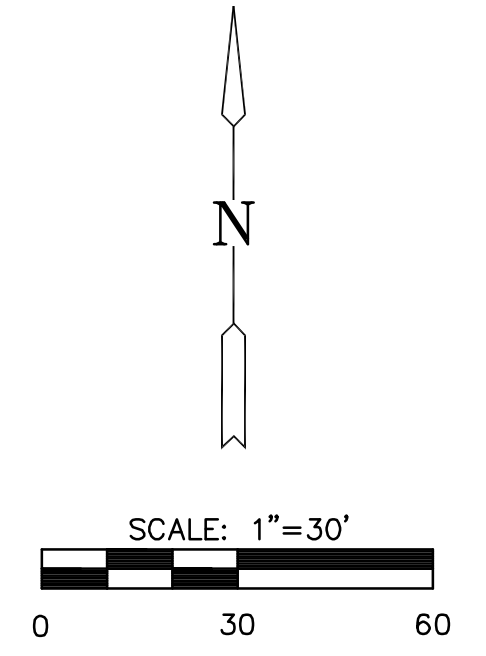

BUBBLE MAP
SHEET TITLE
448-90335
PROJECT NUMBER

DESIGN BY **DFL**
DRAWN BY **KKL**
CHECKED BY **GJA**

ISSUED **June 2009**
REVISED

SHEET NO.
4 of 10