
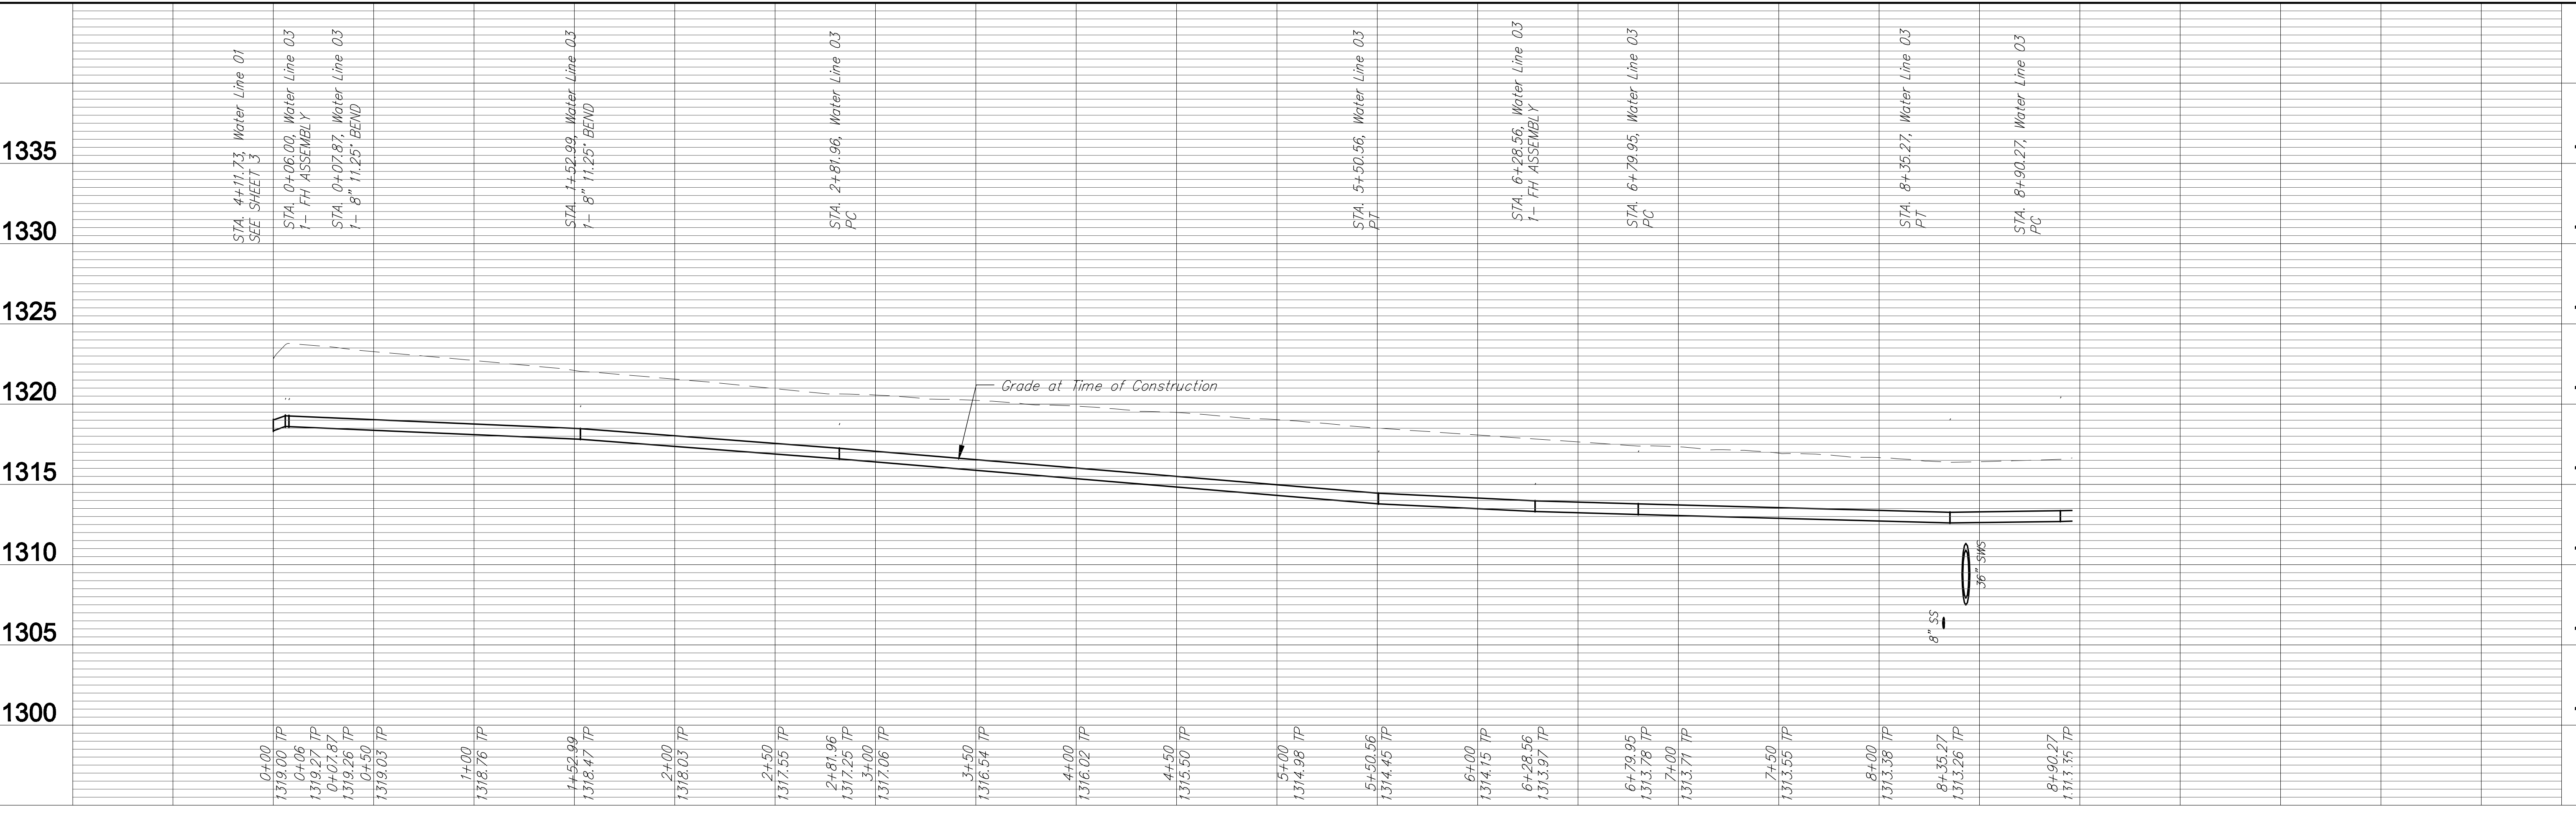
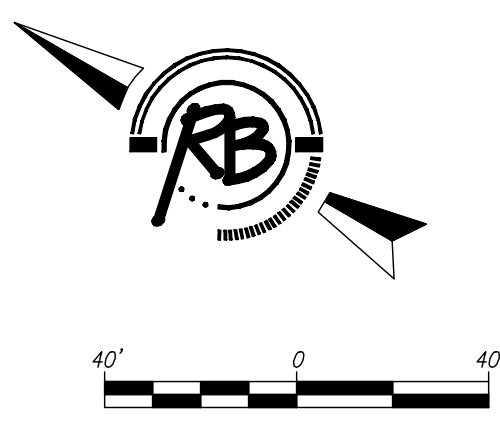


Bellechase 2nd Addition

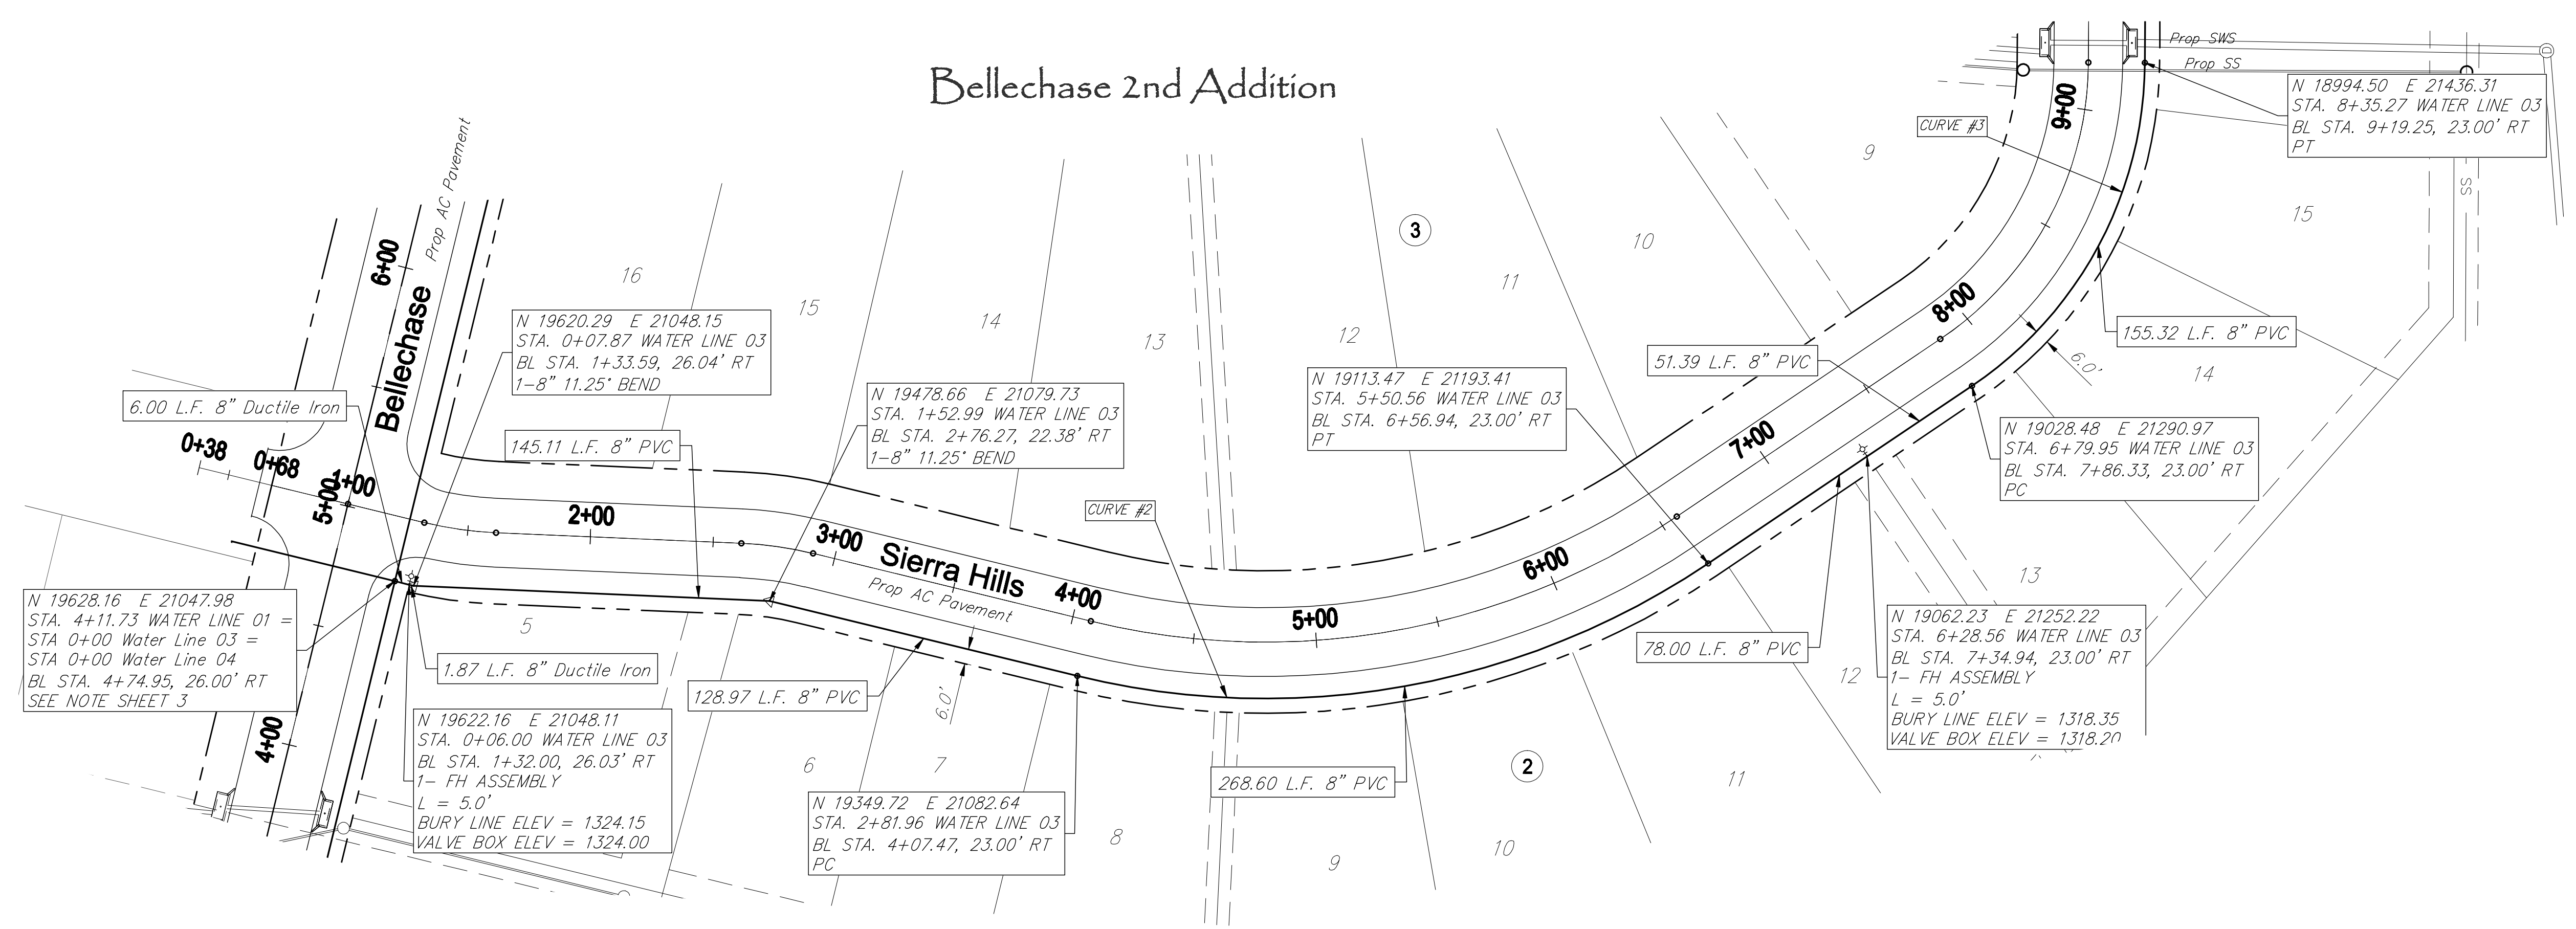

Ruggles & Bohne, P.A.
 Engineering, Surveying, Land Planning

Water Distribution System
Water Line 03
WICHITA, KANSAS

PROJECT NUMBER: 448-90406
 DRAWING FILE: Water {Line 03}

DESIGN: EJC
 CHECKED: EJC
 DATE: Feb. 17, 2009
 REVIEW: Jan. 8, 2009

3342E
 12