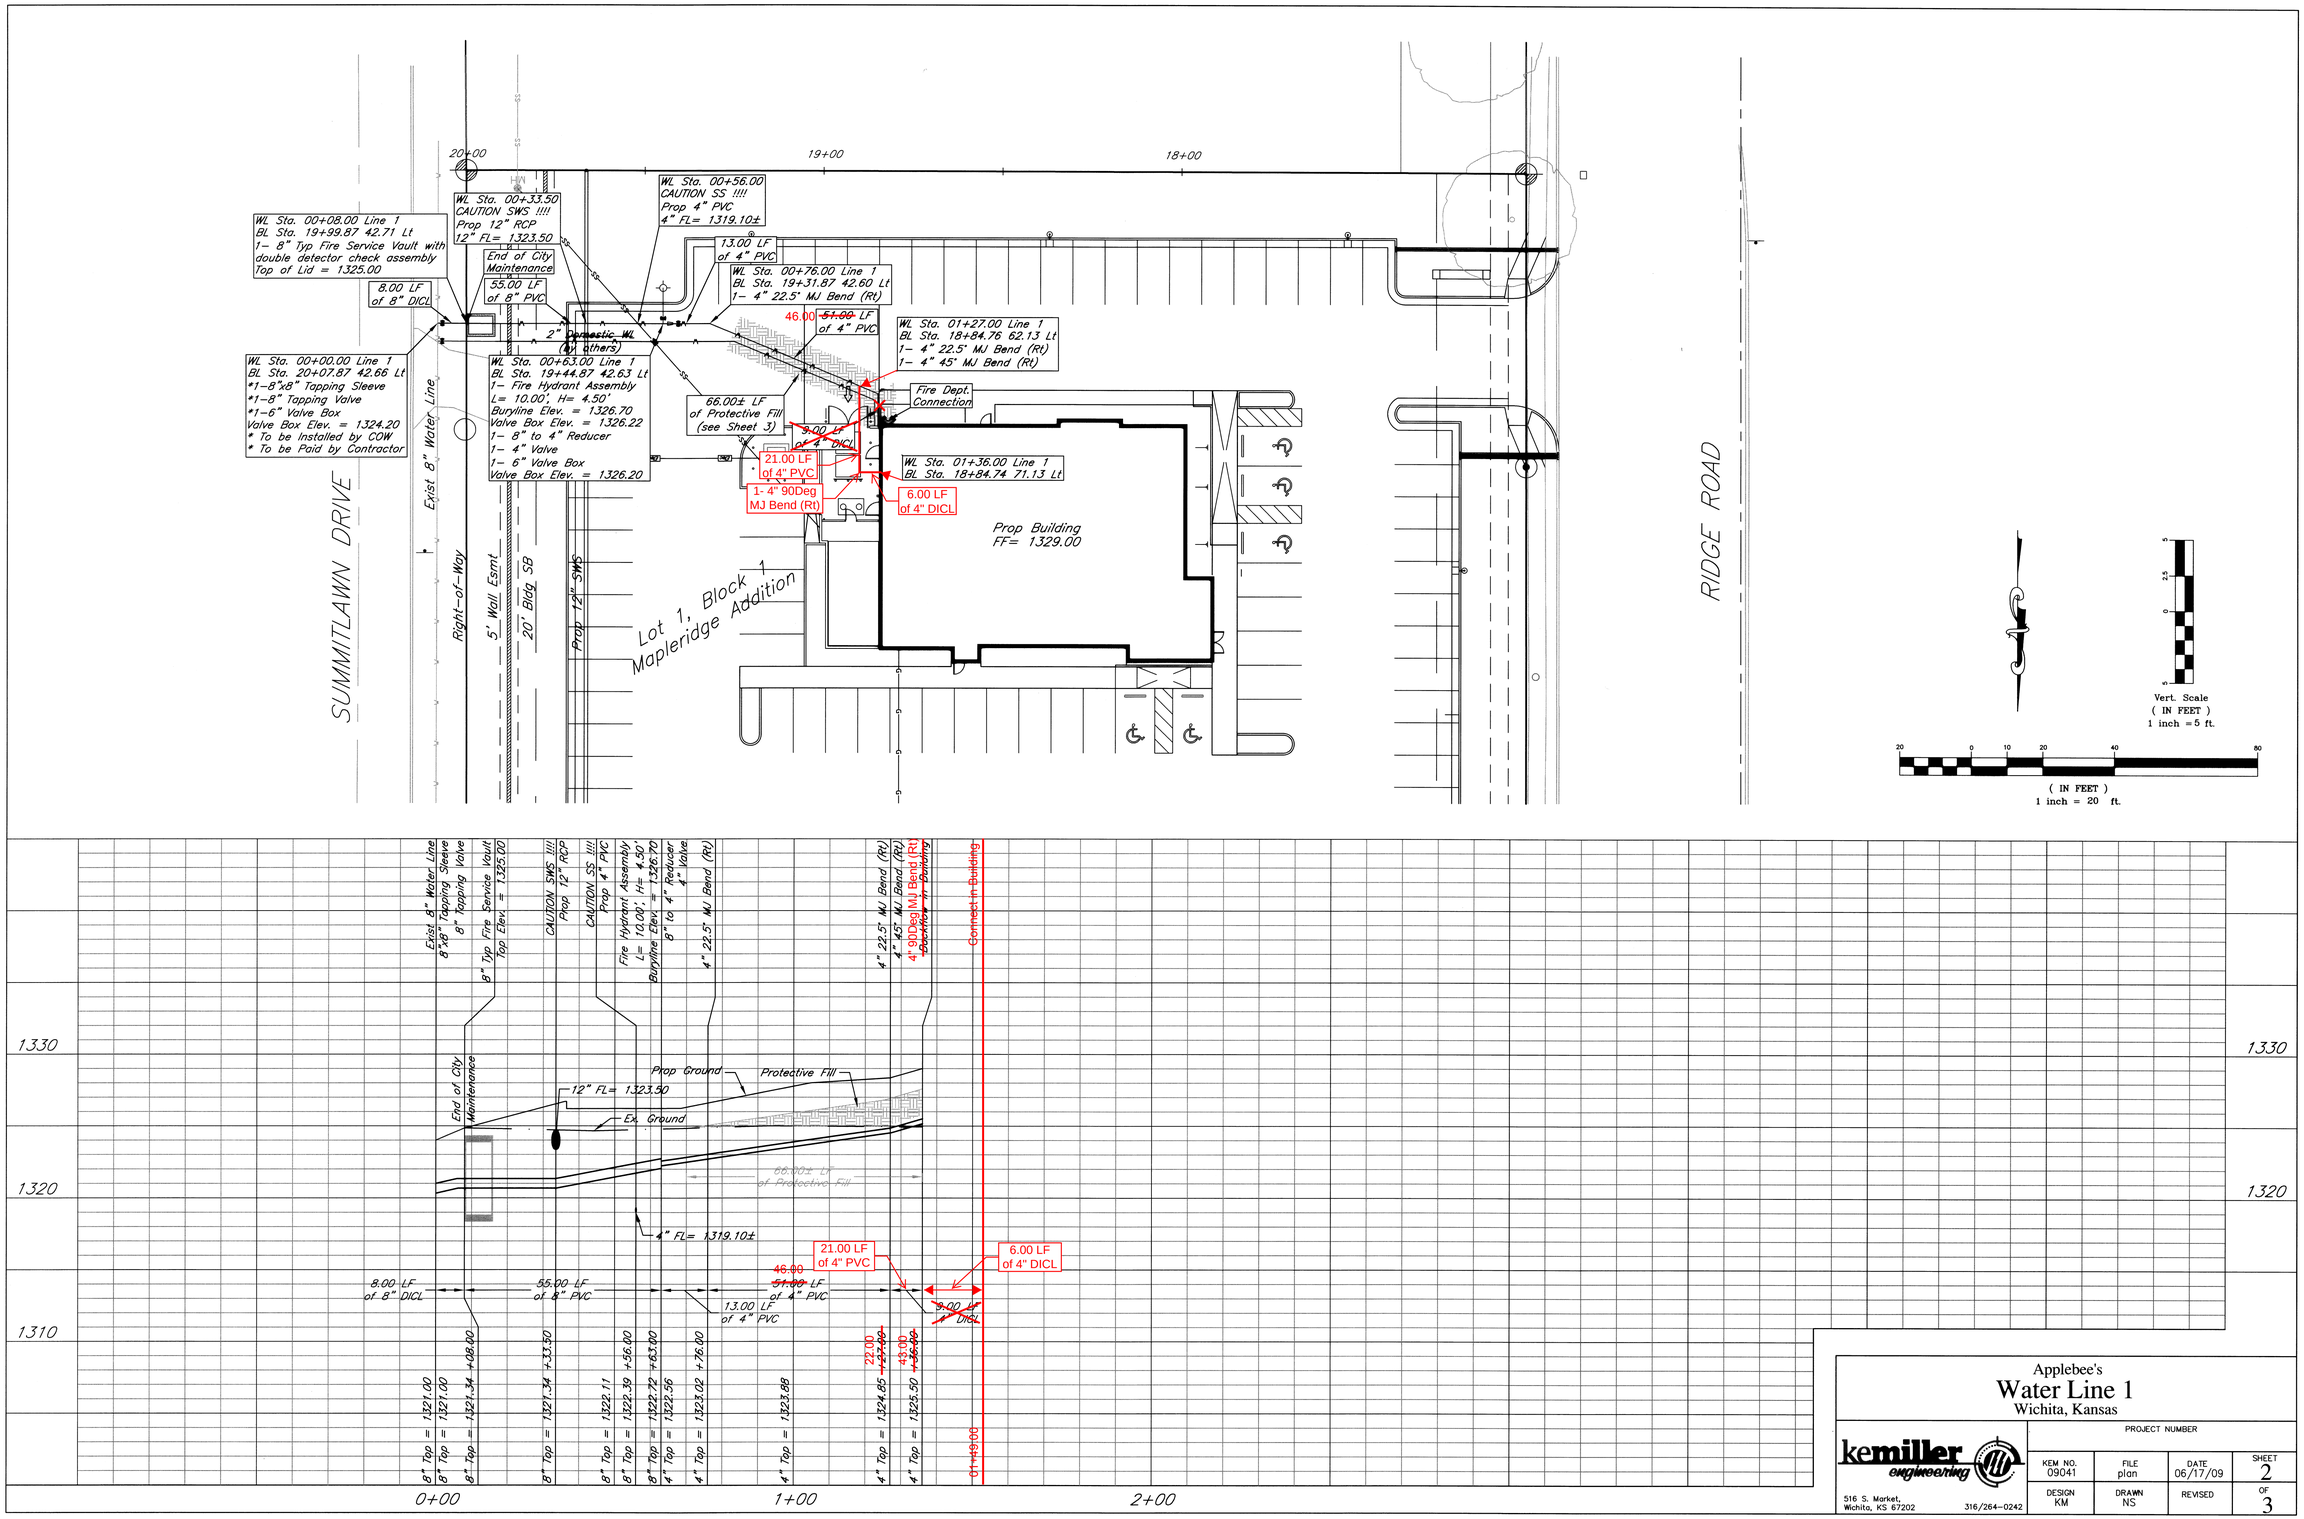

Applebee's

Water Line 1

Wichita, Kansas

kemiller engineering
516 S. Market,
Wichita, KS 67202
316/264–0242

PROJECT NUMBER			
KEM NO. 09041	FILE plan	DATE 06/17/09	SHEET 2
DESIGN KM	DRAWN NS	REVISED	OF 3