F:\Projects\Projects 3300-3399\3337E (FlightSafety Ground Maintenance)\ENGINEERING BASE.dwg, PAVING PLAN, 11/24/2008 4:42:54 PM, Matt_P

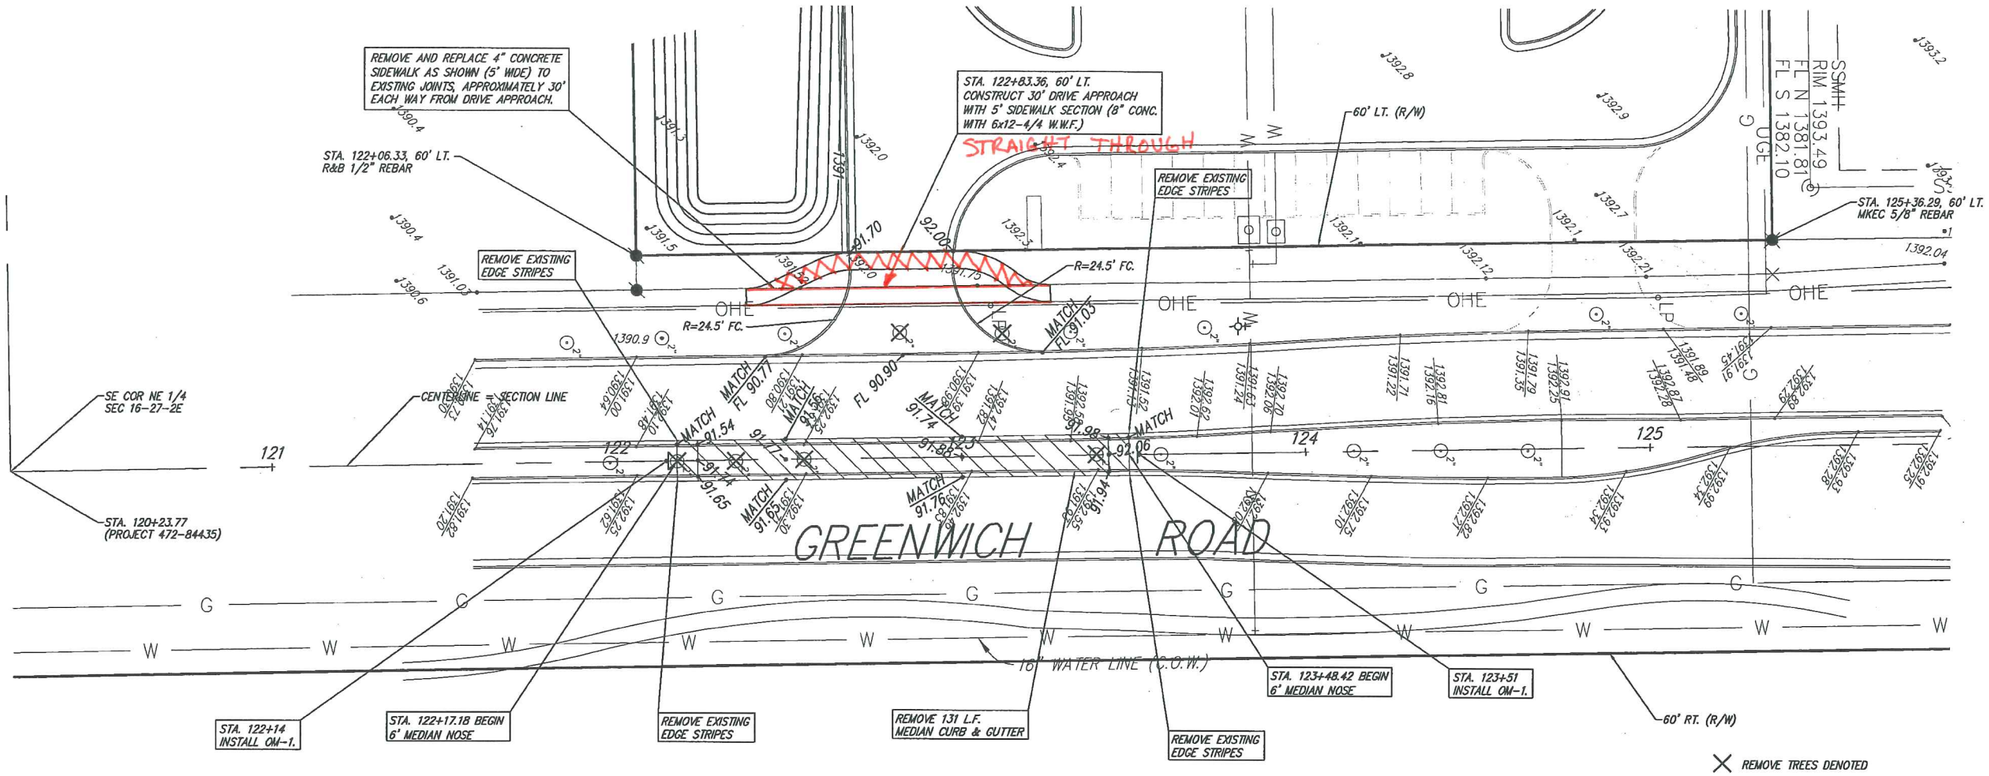

PAVING PLAN

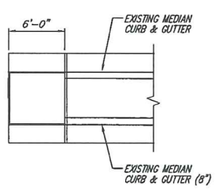

PLAN

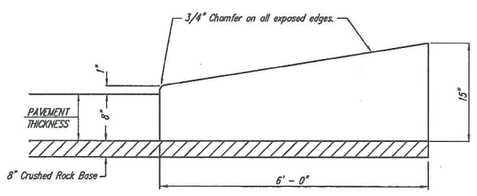

SECTION A – A

CONCRETE MEDIAN NOSE

NOT TO SCALE

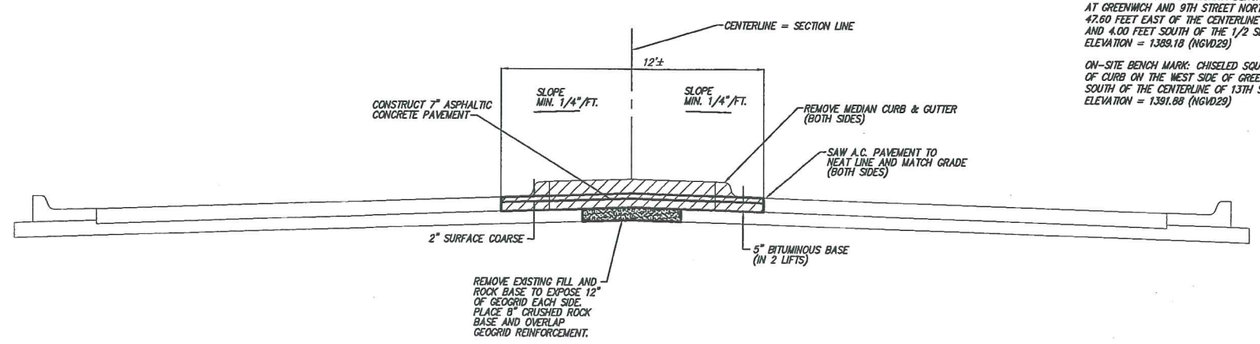

TYPICAL SECTION

20' 0 20'

BENCH MARK: CITY OF WICHITA BENCH MARK AT GREENWICH AND 9TH STREET NORTH 47.60 FEET EAST OF THE CENTERLINE OF GREENWICH AND 4.00 FEET SOUTH OF THE 1/2 SECTION LINE ELEVATION = 1389.18 (NGVD29)

ON-SITE BENCH MARK: CHISELED SQUARE ON THE TOP OF CURB ON THE WEST SIDE OF GREENWICH, 2,145 FEET SOUTH OF THE CENTERLINE OF 13TH STREET NORTH ELEVATION = 1391.88 (NGVD29)

Ruggles & Bohm, P.A.
Engineering, Surveying, Land Planning
924 North Main
Wichita, Kansas 67203
www.rbkansas.com
(316) 264-8008
(316) 264-4621 fax
E-mail: info@rbkansas.com

AS-BUILTS 9-24-09

3337E

CONSULTING ENGINEERS
CIVIL: RUGGLES & BOHM, P.A. 924 NORTH MAIN WICHITA, KANSAS 67203 (316) 264-8008
STRUCTURAL: R. WILLIAM MCNEALY, P.E. 1145 COLE, SEBIN BLDG., STE 300 WICHITA, KANSAS 67203 (316) 264-8008 E: BILL MCNEALY - E-(316) 987-7310
MECHANICAL: MURPHY COMPANY 1733 NORTH PRICE ROAD ST. LOUIS, MISSOURI 63132 E: MATT FOSTER - E-(314) 997-6600
ELECTRICAL: KAISER ELECTRIC 1952 FENDORF DRIVE FENTON, MISSOURI 63026 (636) 343-2121 FAX (636)305-1515 E: BRIAN CLAY - E-(636)
PLUMBING: MURPHY COMPANY 1733 NORTH PRICE ROAD ST. LOUIS, MISSOURI 63132 E: MATT FOSTER - E-(314) 997-6600
FIRE PROTECTION: CENTRAL FIRE PROTECTION CO. 1330 N. WOODLAWN WICHITA, KANSAS 67201 E: BRYAN CONLANSKY - E-(316) 945-0197
CONTRACTOR: ARCO
ARCHITECT: GMA DESIGN GROUP, INC. ARCHITECTURE ENGINEERING ARCHITECTURAL DESIGN SERVICES
A DIVISION OF ARCO NATIONAL CONSTRUCTION
1750 SOUTH BRENTWOOD SUITE 700 ST. LOUIS, MISSOURI 63144 (314) 962-8181 (314) 962-4728 WWW.GMADESIGN.COM

PROPOSED MAINTENANCE FACILITY FOR: FlightSafety International WICHITA, KANSAS

PAVING PLAN

JOB NO : SJ0811

DRAWN BY : MLP

ISSUE DATE : 11-25-08

REVISIONS △
1 REV-1
2 REV-2
3 REV-3
4 REV-4
5 REV-5

THIS DESIGN AND THESE DRAWINGS ARE THE PROPERTY OF GMA DESIGN GROUP. NO PART OF THIS WORK MAY BE REPRODUCED WITHOUT PRIOR WRITTEN PERMISSION FROM GMA DESIGN GROUP.

SHEET NUMBER C3-2