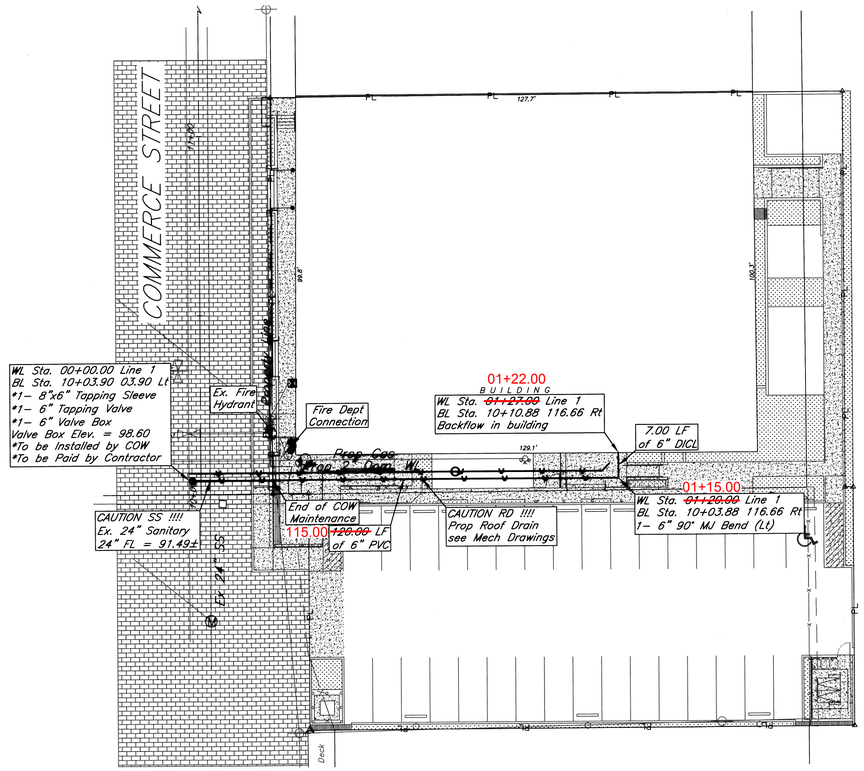

Notes:

1. Contractor is to field verify existing 24" sanitary sewer depth, is shown as approximate depth. Proposed 6" PVC is to be at minimum of 24" clearance above existing sanitary.

Benchmark:

P-K Nail at Southwest corner of Ramp Base.

Elev. = 99.00

Vert. Scale
(IN FEET)
1 inch = 5 ft.

(IN FEET)
1 inch = 20 ft.

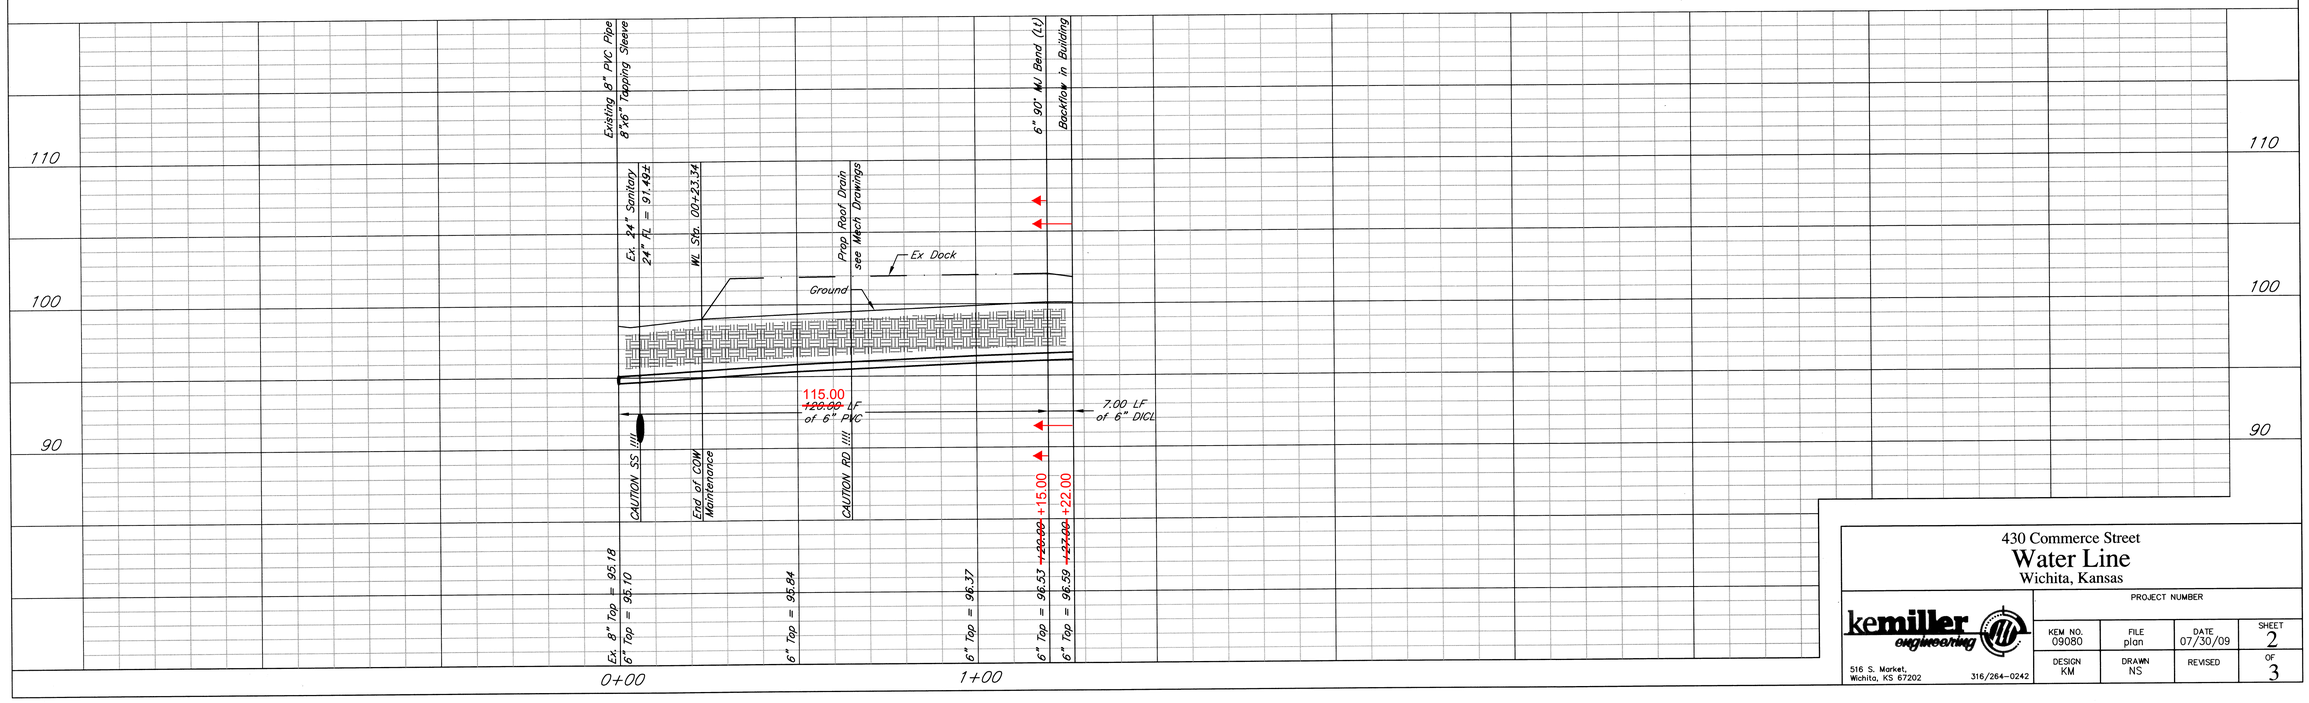

430 Commerce Street
Water Line
Wichita, Kansas

kemiller engineering
516 S. Market,
Wichita, KS 67202
316/264-0242

PROJECT NUMBER			
KEM NO. 09080	FILE plan	DATE 07/30/09	SHEET 2
DESIGN KM	DRAWN NS	REVISED	OF 3