




BENCHMARK:
 "□" Chiseled on Top of Curb
 along East Property line
 extended North.
 Elev. = 1397.57 (NGVD 29)



Install one construction
 entrance onto existing
 paved roadway per detail,
 sheet 6.

CAUTION!
 Ex. OH Elec.
 Crossing

Scale: 1" = 20' Horizontal
 1" = 5' Vertical
 - = Iron

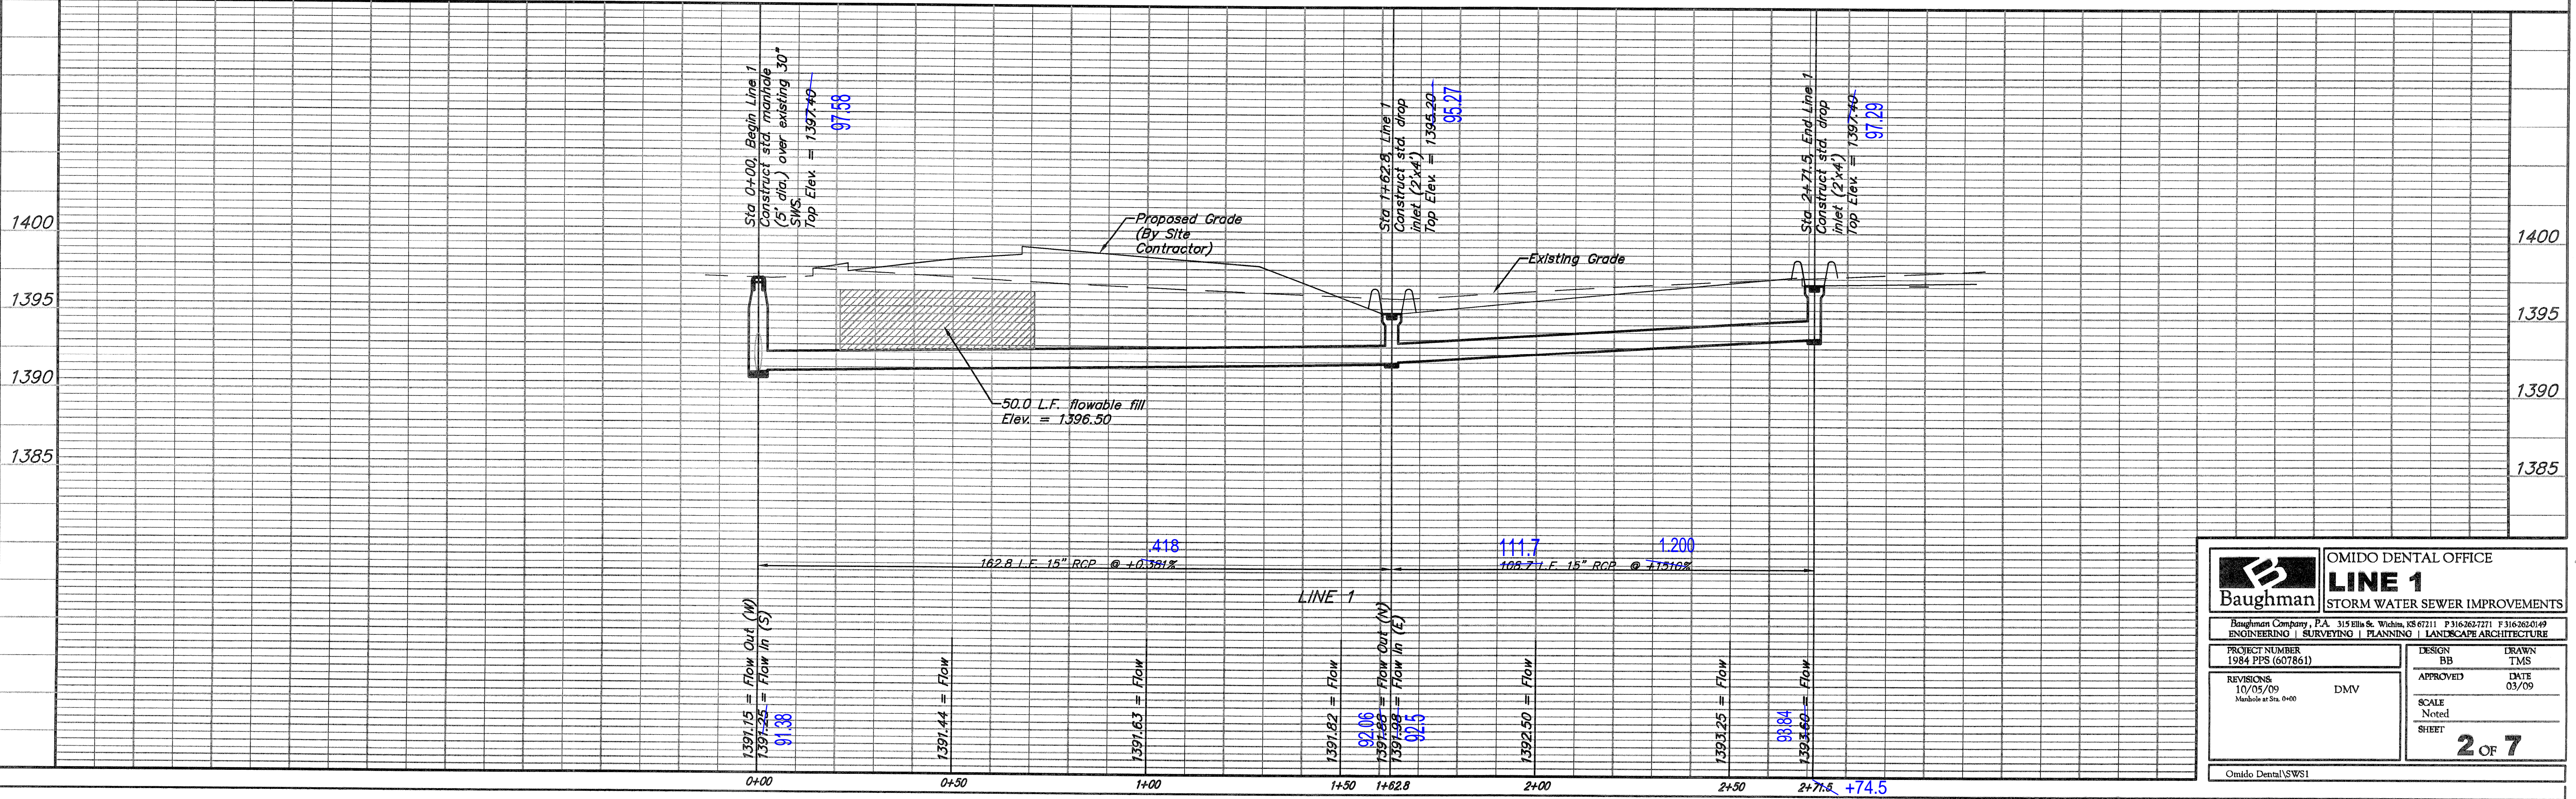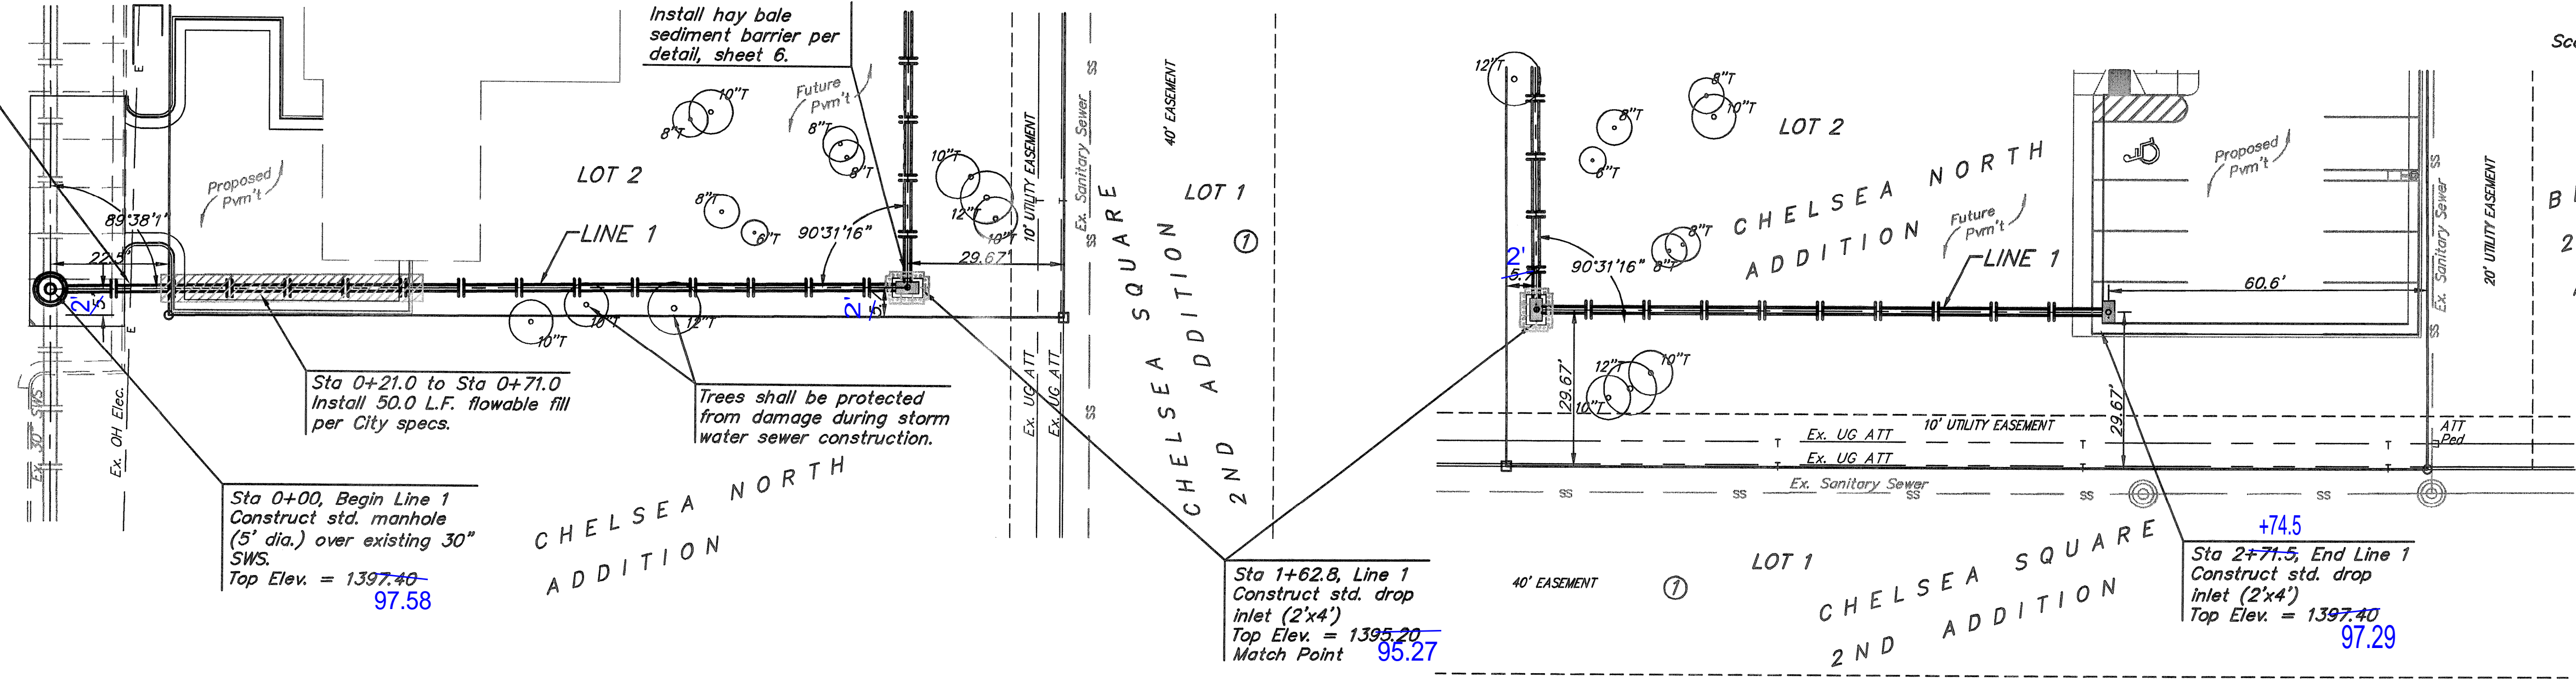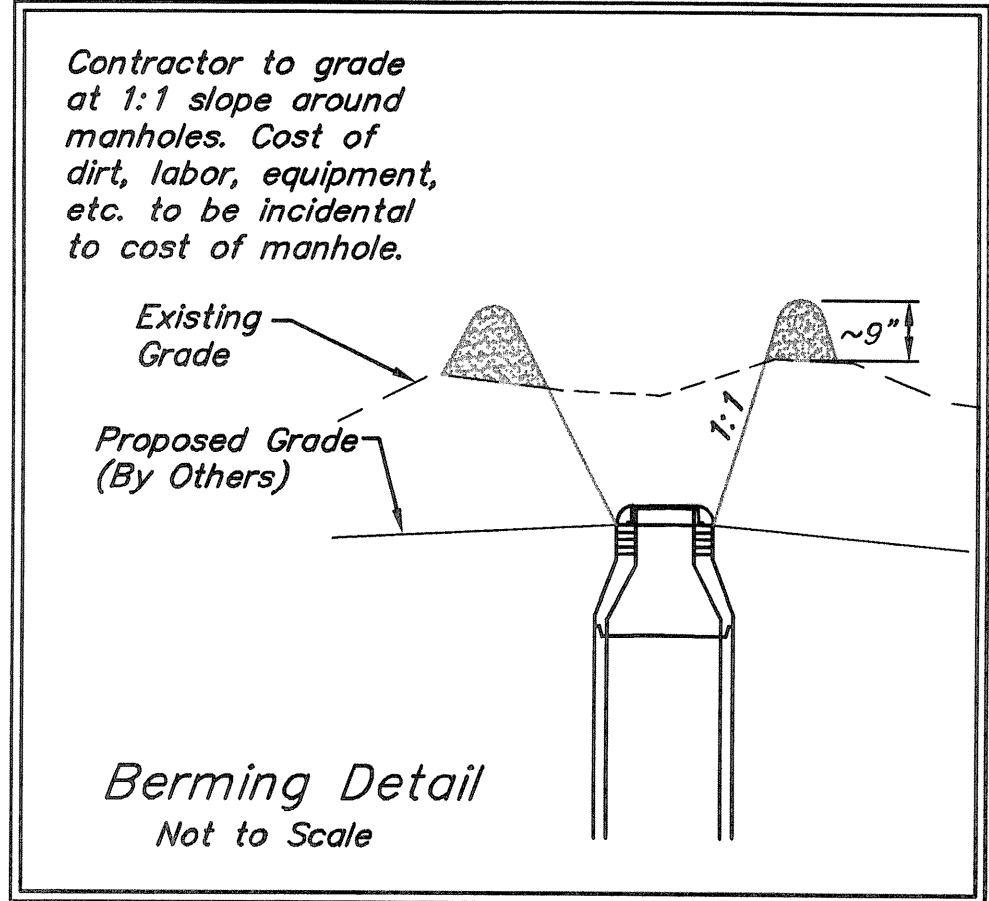

	OMIDO DENTAL OFFICE	
	LINE 1	
STORM WATER SEWER IMPROVEMENTS		
<small>Baughman Company, P.A. 315 Ellis St. Wichita, KS 67211 P 316-263-7271 F 316-263-0149 ENGINEERING SURVEYING PLANNING LANDSCAPE ARCHITECTURE</small>		
PROJECT NUMBER 1984 PPS (607861)	DESIGN BB	DRAWN TMS
REVISIONS 10/05/09 <small>Manhole at Sta. 0+00</small>	APPROVED Noted	DATE 03/09
SCALE Noted	SHEET 2 OF 7	