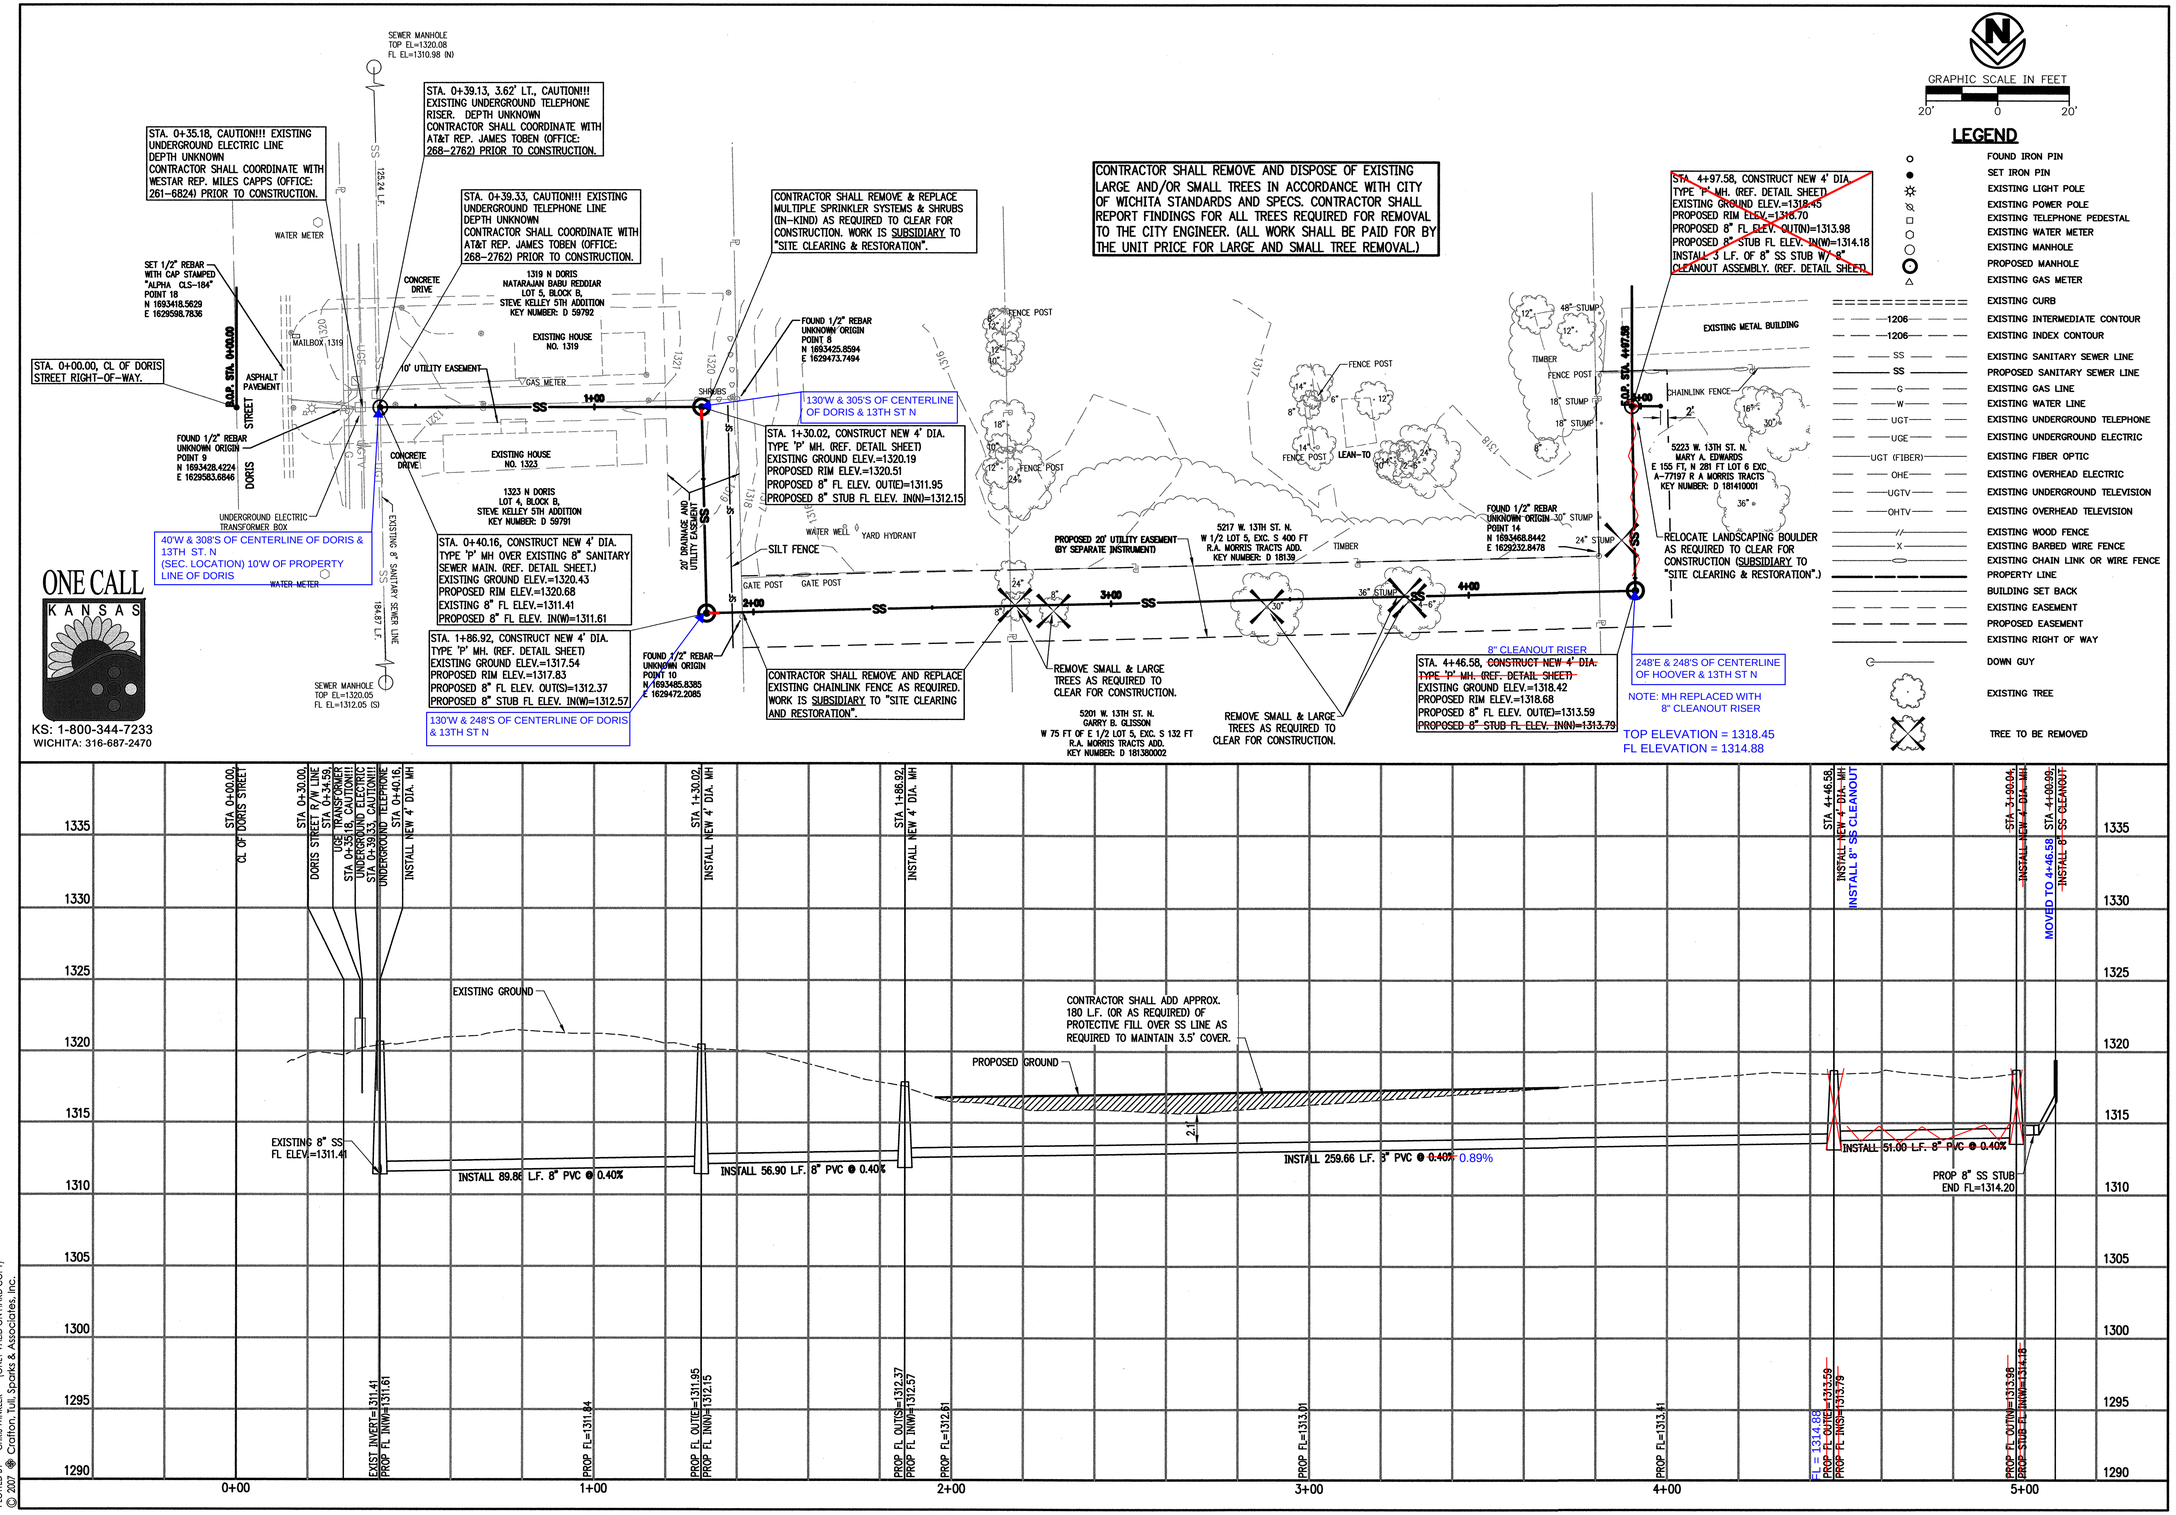

DRAWING FILE NAME AND LOCATION: G:\073004-00\ENG\DWG\SS_P&P.dwg
LAST SAVED BY CW3002 11/14/2008 12:01:13 PM
PLOTTED BY CHRIS WINKLER [DNLT VALID ON HARD COPY]
© 2007 Crafton, Tull, Sparks & Associates, Inc.
LAYOUT TAB: LAYOUT1

JASON C. MOHLER LICENSED 18722 C. KANSAS PROFESSIONAL ENGINEER
11/14/08

Crafton Tull Sparks
8200 E. 34th Street North, Bldg. 1600
Suite 1603, Wichita, KS 67226
316.634.6776 FAX: 316.634.6777
www.craftontullsparks.com
architecture | engineering

SANITARY SEWER IMPROVEMENTS
WICHITA, KANSAS
C.O.W. PROJ. NO.: 468 84016
ISSUED FOR CONSTRUCTION

Revisions

SS PLAN & PROFILE

Drawn by	Job Number
CKW	073004-00
Checked by: JCM	Contact Person: J. MOHLER
Date: 11/14/08	Sheet Number: 3