BENCHMARKS:

BM #1: RR Spike in west face of 2nd power pole north of 29th St. N., east side of Greenwich Road.
Elev. = 1388.93

BM #2: RR Spike in west side power pole, east side of Greenwich Road, north side of drive to House #3150.
Elev. = 1398.38

NORTHEAST BASEBALL COMPLEX ADDITION

Scale: 1" = 40' Horizontal
1" = 5' Vertical
• = Iron

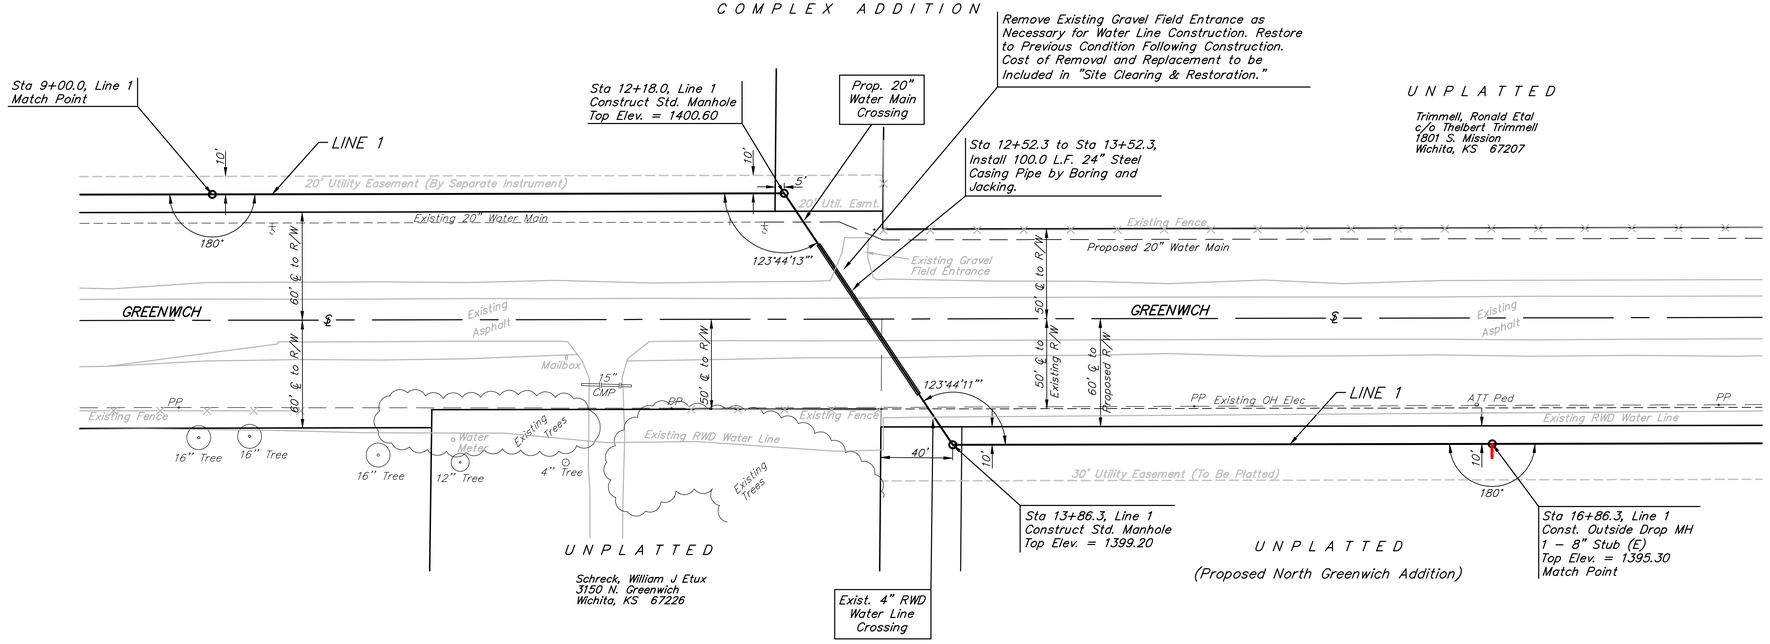

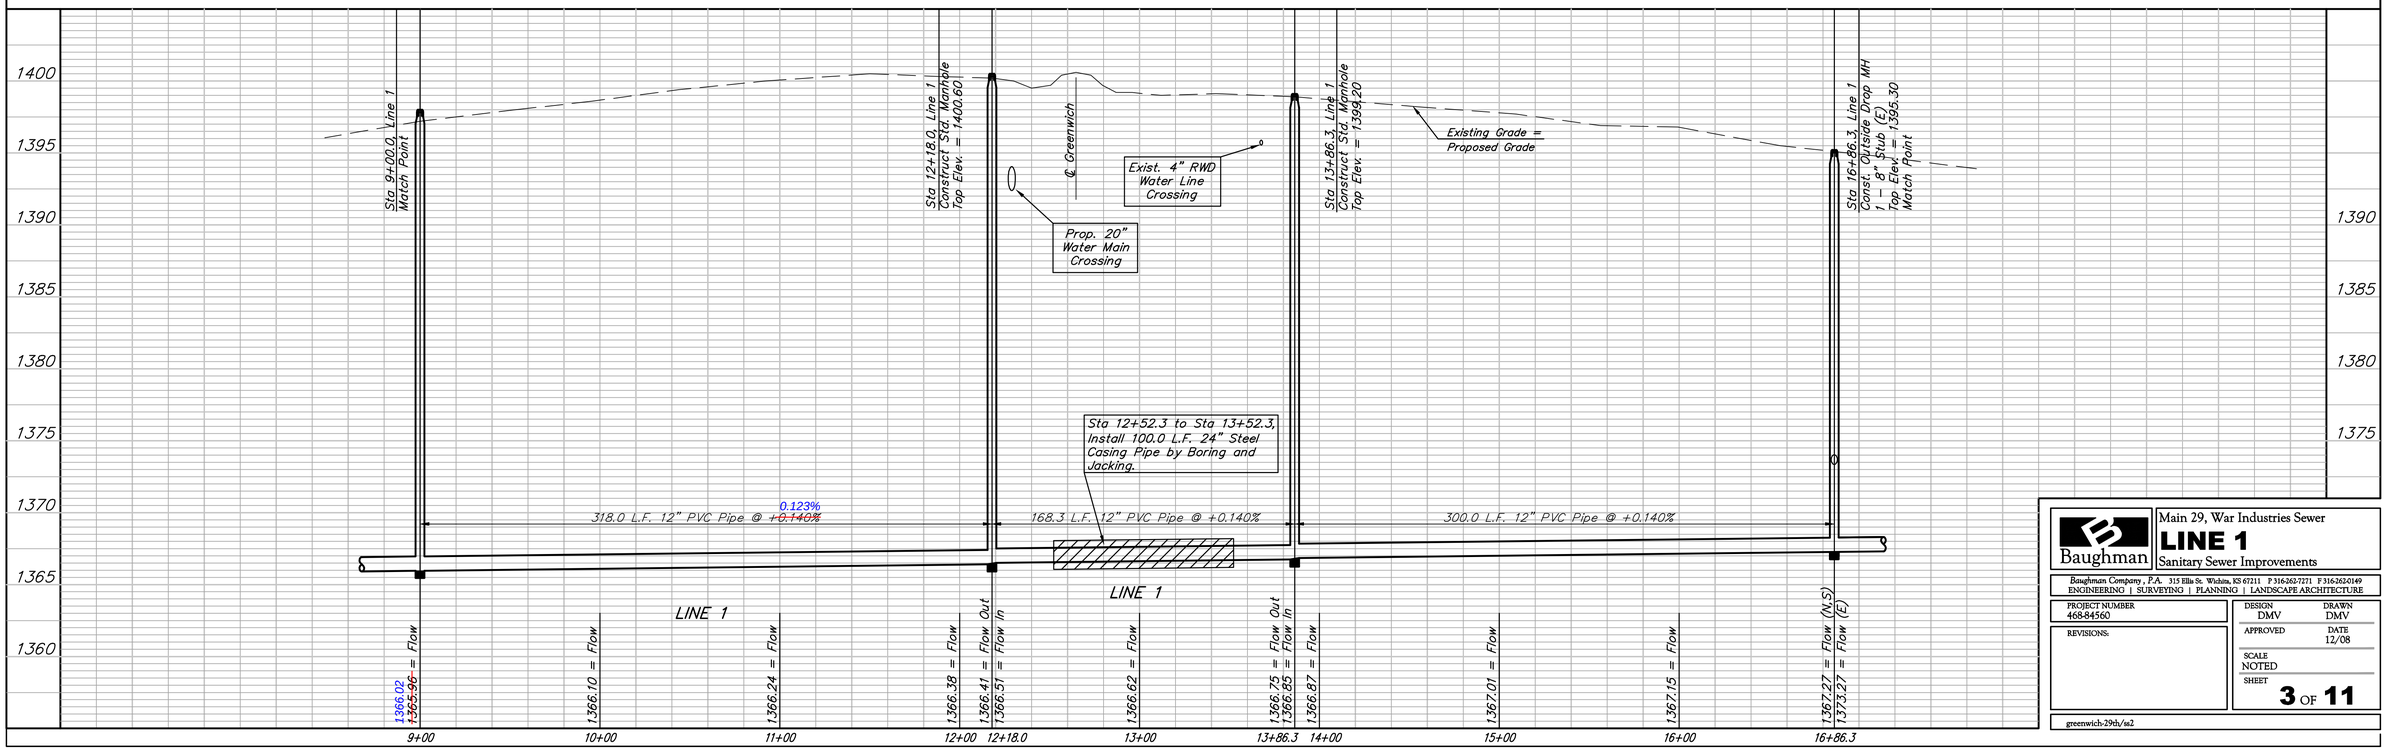

Baughman

Main 29, War Industries Sewer

LINE 1

Sanitary Sewer Improvements

Baughman Company, P.A. 315 Ellis St. Wichita, KS 67211 P 316-263-7271 F 316-262-0149
ENGINEERING | SURVEYING | PLANNING | LANDSCAPE ARCHITECTURE

PROJECT NUMBER 468-84560	DESIGN DMV / DRAWN DMV
REVISIONS:	APPROVED / DATE 12/08
	SCALE NOTED
	SHEET 3 OF 11

greenwich-29th/ss2