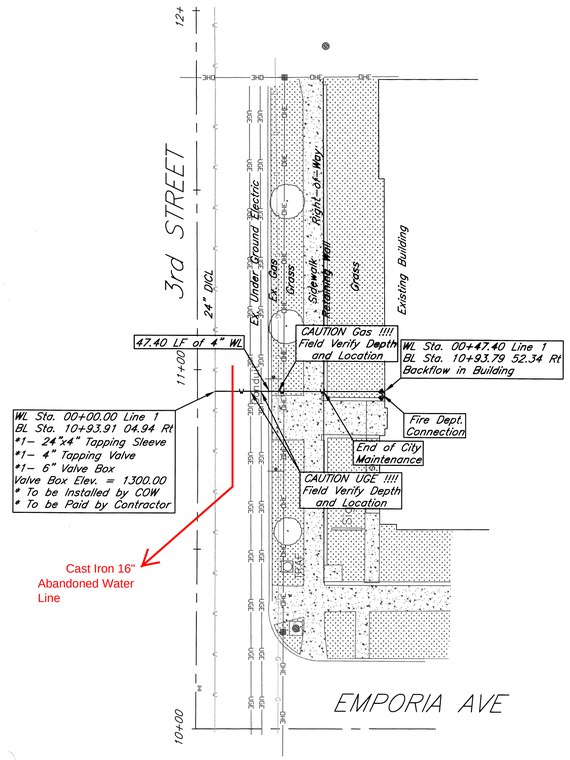

Notes:

All joints between tapping valve and end of city maintenance need to be restrained joint fittings as well as thrust blocked.

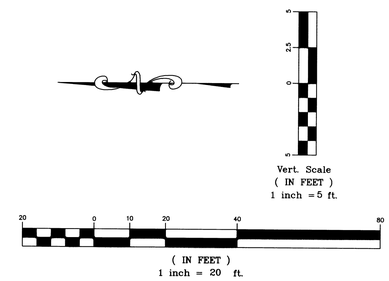

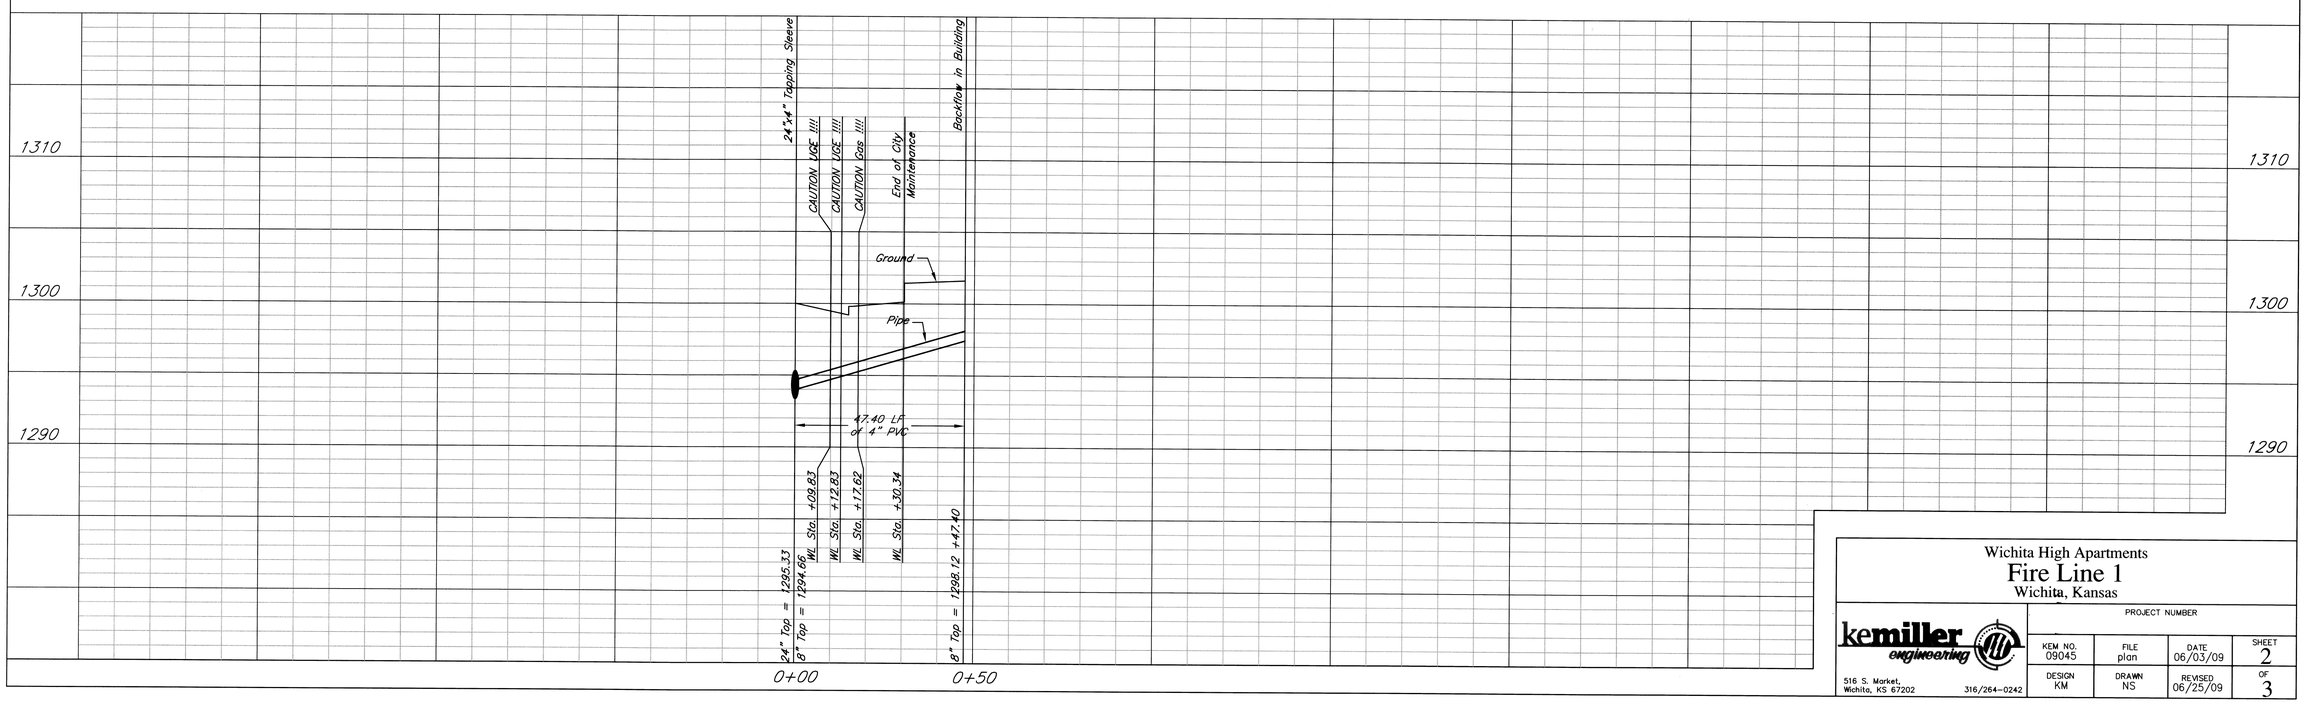

Wichita High Apartments

Fire Line 1

Wichita, Kansas

kemiller engineering

516 S. Market,
Wichita, KS 67202
316/264-0242

PROJECT NUMBER			
KEM NO. 09045	FILE plan	DATE 06/03/09	SHEET 2
DESIGN KM	DRAWN NS	REVISED 06/25/09	OF 3