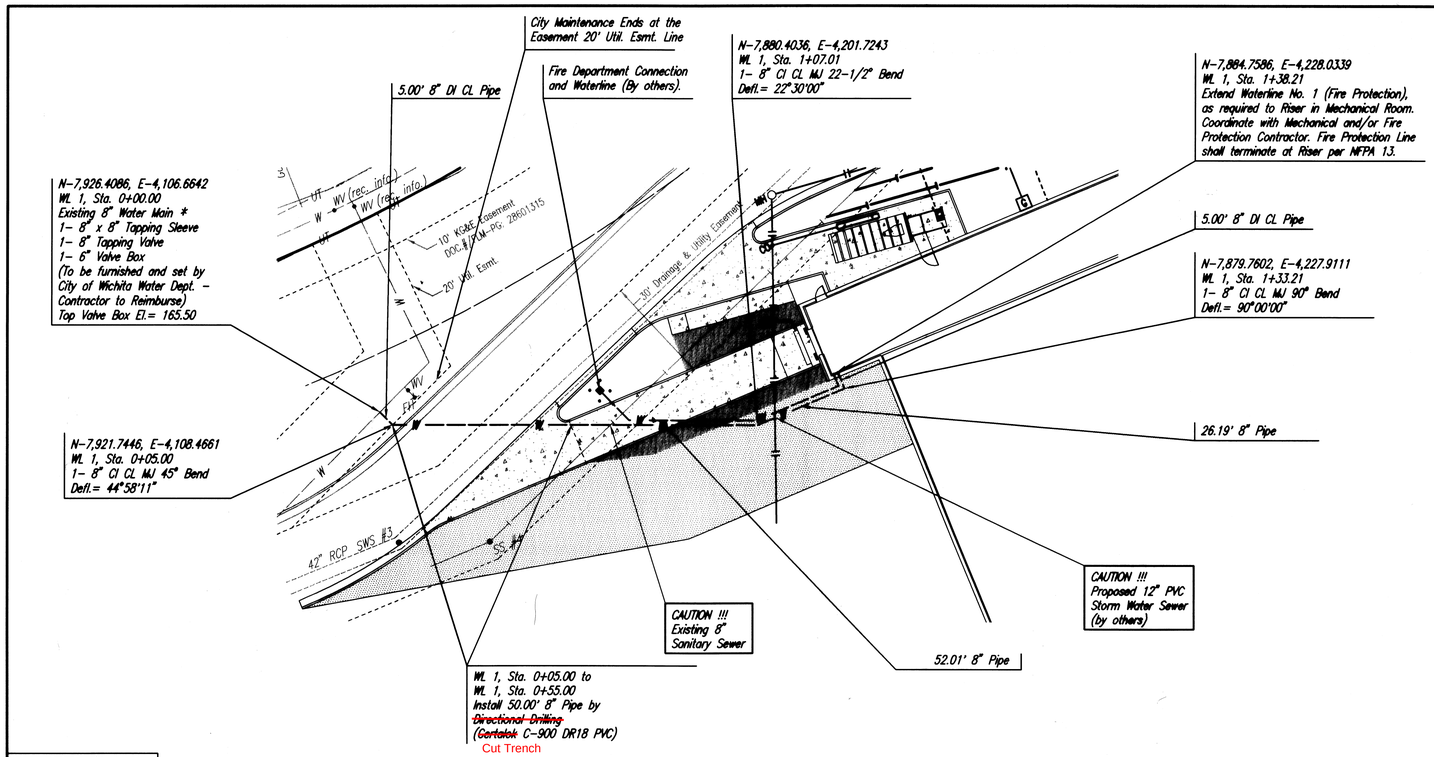

SCALE: 1" = 20'

PLAN: LAT. & LONG. 0 20 40

PROFILE: HORIZ. SAME AS ABOVE

VERT. 0 5

NOTE: SEE SHEET C4.3 FOR WATERLINE DETAILS.

* PRIOR TO BEGINNING CONSTRUCTION, THE CONTRACTOR SHALL EXCAVATE THE EXISTING WATERLINE AT STATION 0+00.00 TO VERIFY PIPE SIZE, TYPE, FITTINGS, AND HORIZONTAL AND VERTICAL LOCATION. THE CONTRACTOR SHALL REPORT HIS FINDINGS TO THE ENGINEER SO THAT ANY NECESSARY PLAN MODIFICATIONS MAY BE MADE. ANY ADDITIONAL LABOR OR MATERIALS NECESSARY TO COMPLETE THE CONNECTION SHALL BE CONSIDERED SUBSIDIARY TO THE PROJECT.

Unless noted otherwise, elevations shown are top of pipe

WATERLINE LINE NO. 1

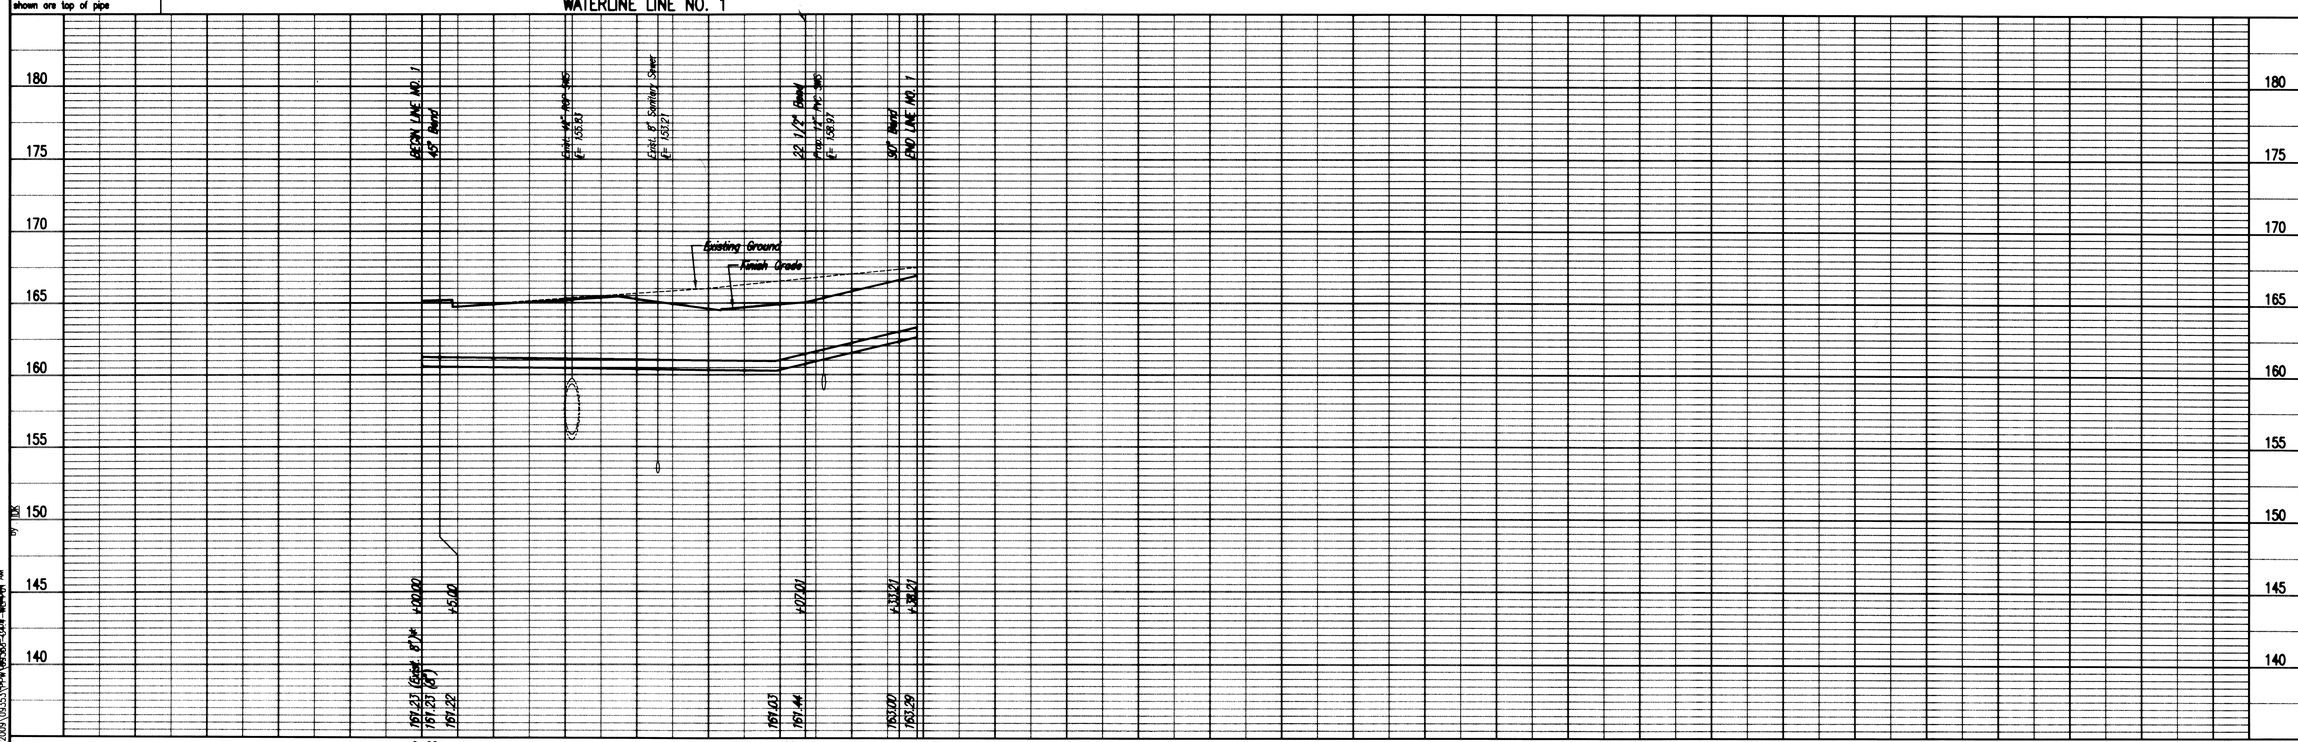

PLAN CHECKED CHECKED BY DATE

PROFILE CHECKED CHECKED BY DATE

NEWMARKET SQUARE BLDG. 22 AND 23
WATER DISTRIBUTION SYSTEM IMPROVEMENTS

WATERLINE LINE NO. 1

JAMES L. ARMOUR, P.E. - CITY ENGINEER
CITY OF WICHITA PRIVATE PROJECT NO. 1492 PPS (607853)

Professional Engineering Consultants, P.A.
303 S. TOPEKA • WICHITA, KANSAS 67202
316-262-2691 • FAX 316-262-3003

Designed By IDK
Drawn By AEE
Job No. 36-09353-3104
Date AUGUST 2009

Sheet 4.4

Saved 08-20-2009 9:43:26 AM by IDK
Plot Scale 1:20
Q:\2009\09353\PPW\09-08-2009 9:44:01 AM