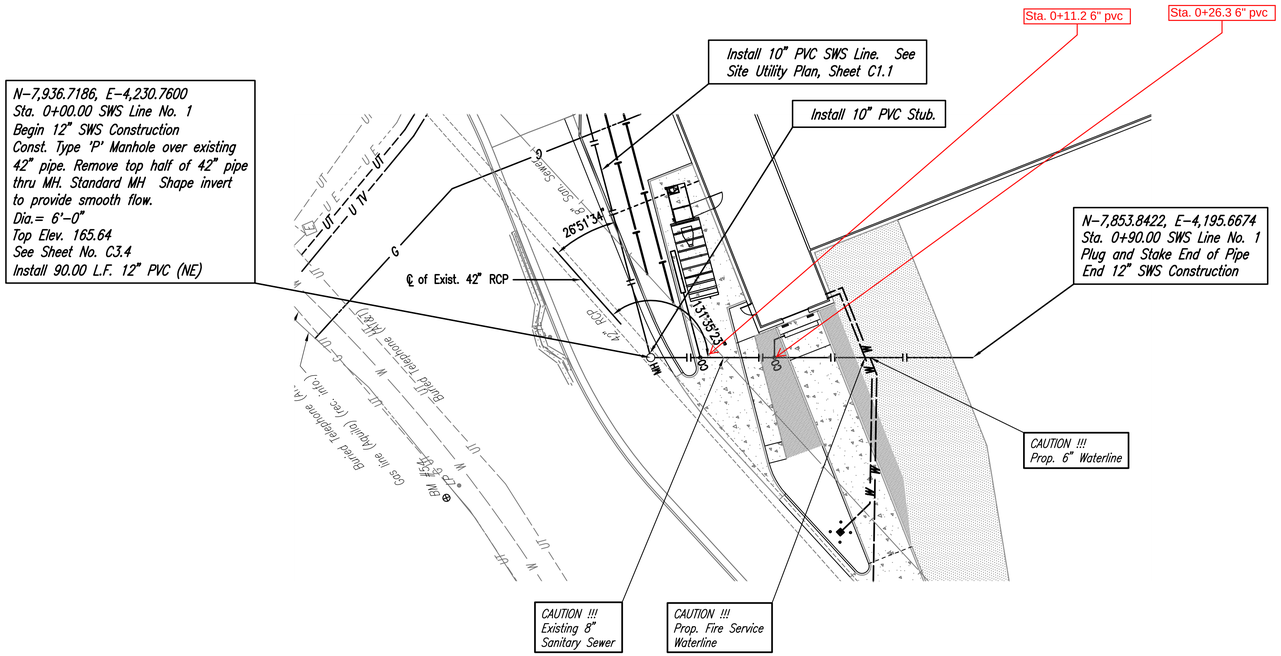

SCALE: 1" = 20'

PLAN: LAT. & LONG. 0 20 40

PROFILE: HORIZ. SAME AS ABOVE

VERT. 0 5

SWS LINE NO. 1

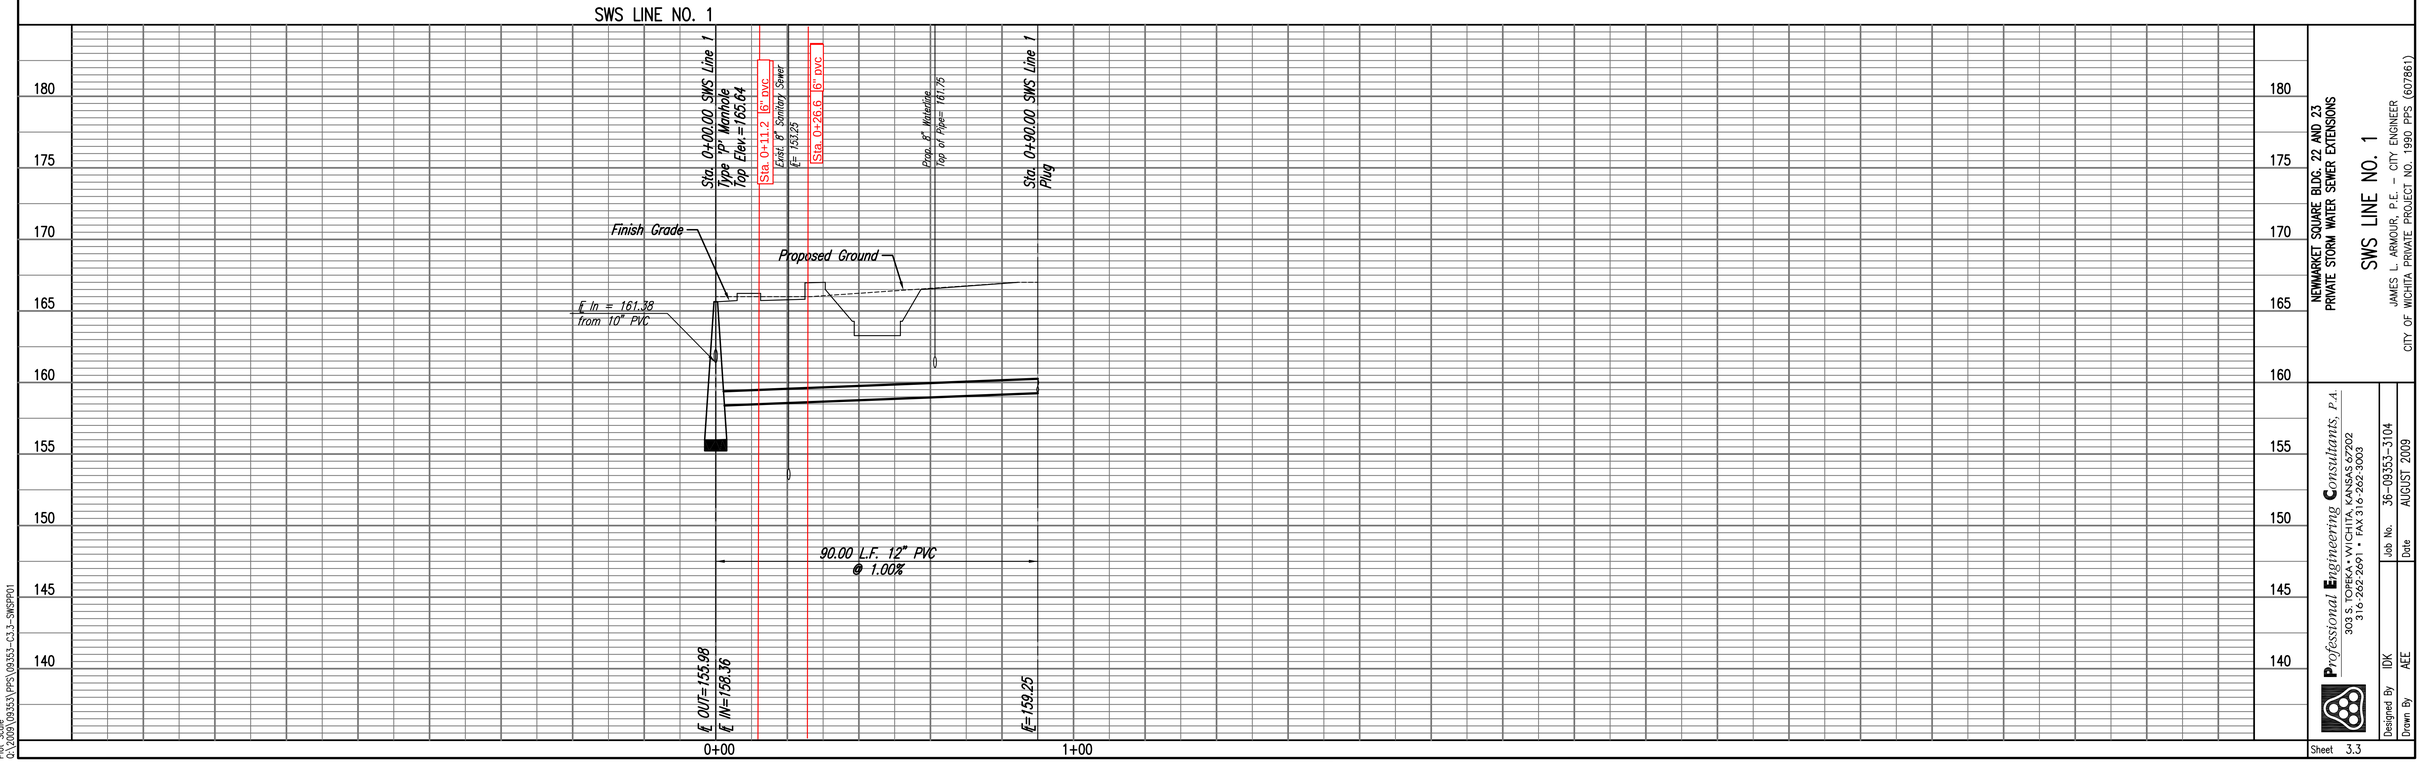

NEWMARKET SQUARE BLDG. 22 AND 23
PRIVATE STORM WATER SEWER EXTENSIONS

SWS LINE NO. 1

JAMES L. ARMOUR, P.E. – CITY ENGINEER
CITY OF WICHITA, PRIVATE PROJECT NO. 1990, PPS (607861)

Professional Engineering Consultants, P.A.
303 S. TOPEKA • WICHITA, KANSAS 67202
316-262-2691 • FAX 316-262-3003

Designed By IDK
Drawn By AEE
Job No. 36-09353-3104
Date AUGUST 2009

Sheet 3.3

PLAN	CHECKED	BY	DATE
	CHECKED		

PROFILE	CHECKED	BY	DATE
	CHECKED		

Saved 08-20-2009 10:26:46 AM by IDK
Plot Scale 1:1
Q:\2009\09353\PPS\09353-C3.3-SWSPP01