
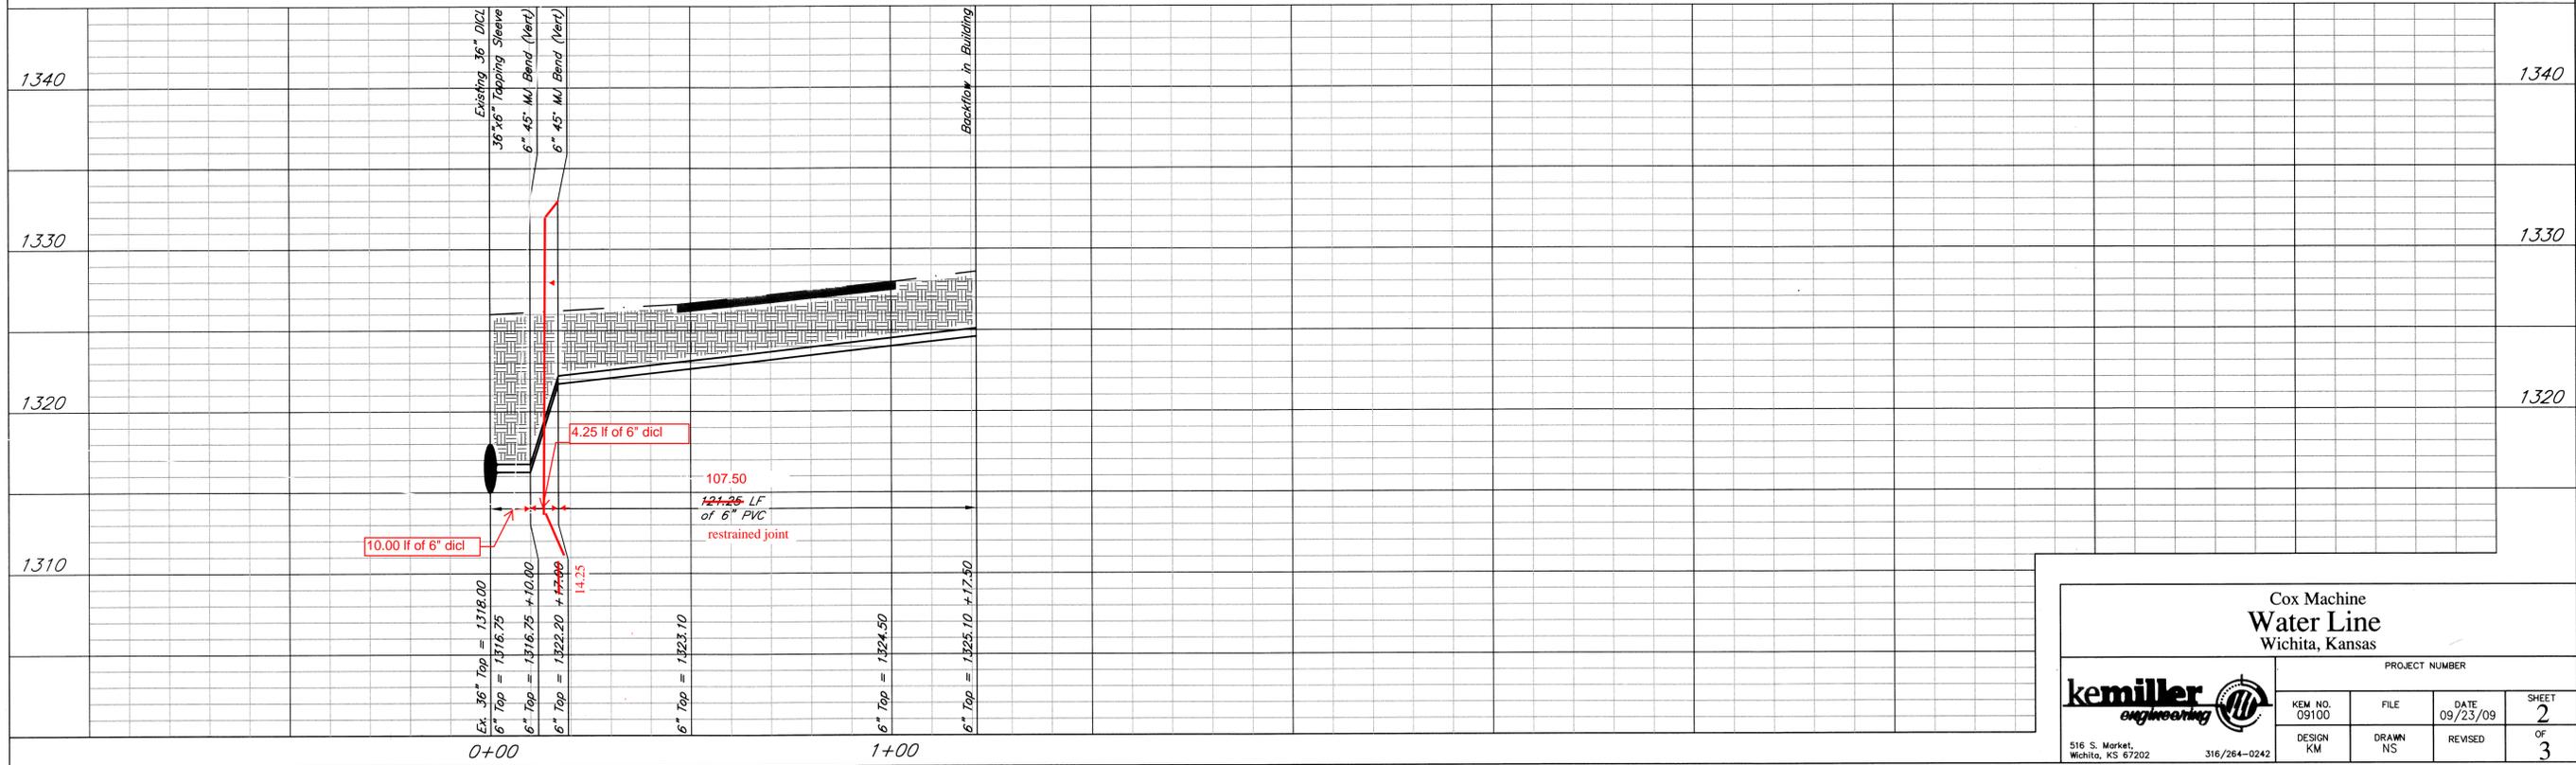
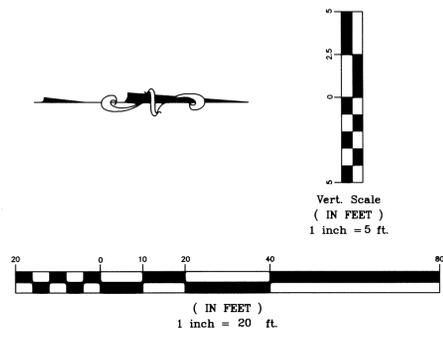


21st STREET NORTH

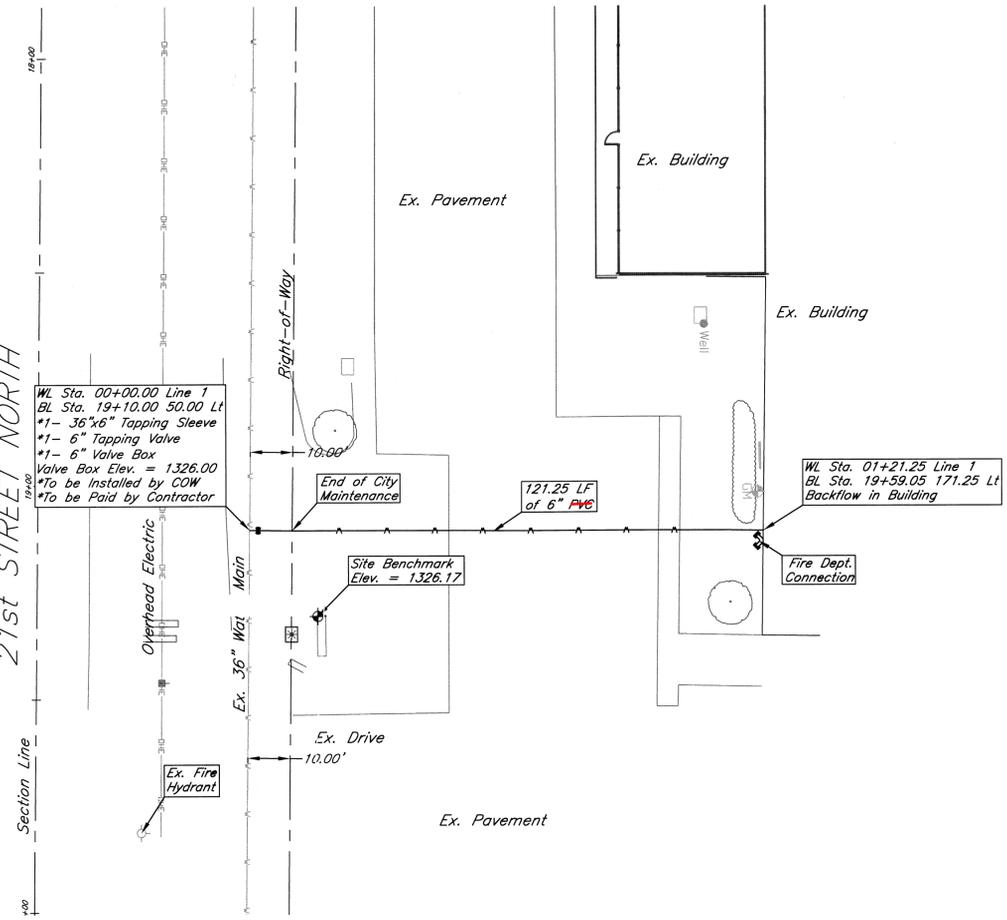

**Cox Machine
Water Line
Wichita, Kansas**

PROJECT NUMBER			
KEM NO. 09100	FILE	DATE 09/23/09	SHEET 2
DESIGN KM	DRAWN NS	REVISED	OF 3

516 S. Market, Wichita, KS 67202 316/264-0242