COUNTY	STATE	PROJECT NO.	YEAR	SHEET NO.	TOTAL SHEETS
SEDGWICK	KANSAS	87 N-0386-01	2009	6R	255

⚠ Revised 12/30/2009

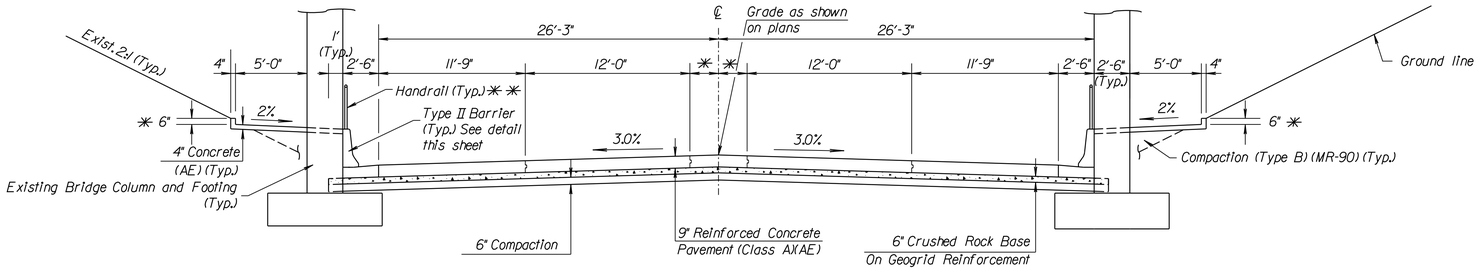

GREENWICH ROAD SECTION

Sta.137+54.10 to Sta.139+12.11

✳ See plans and cross sections for variations

✳✳ Handrail shall conform to the handrail details as shown in these plans. Contractor to submit shop drawings prior to fabrication.

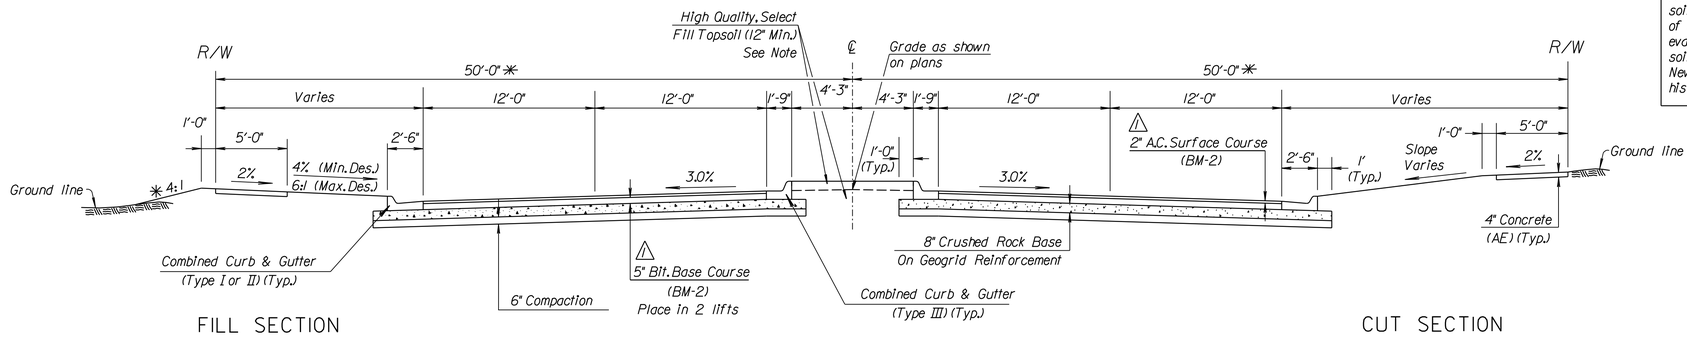

FILL SECTION

CUT SECTION

GREENWICH ROAD SECTION

Sta.108+21.05 to Sta.110+89.27
Sta.121+54.42 to Sta.122+89.07
Sta.129+04.45 to Sta.130+93.55

Topsoil in the Landscaped Medians shall be friable, dark, and loamy in nature, and free of gravel and/or rock material. New soil shall also be free of organic material, and shall be capable of sustaining plant growth. Contractor shall be responsible for evaluating existing soil conditions prior to bidding, as onsite soils may not be suitable for required Top Soil applications. New soil shall be inspected and approved by the Engineer or his designated representative prior to installation.

CITY OF WICHITA
JAMES ARMOUR, P.E., CITY ENGINEER

TYPICAL SECTIONS GREENWICH ROAD

PB PARSONS BRINCKERHOFF
122. Wichita, Kansas

SCALE	DATE	DWG. NO.
N.T.S.	11/23/2009	35751A

6R

SURV.	PLOT	CADD	DES.	RAN	DR.	JR	TR.	CKD.	JJR	APP.
-	-									-

K:\35751A\CADD\SHEETS\ROADWAY\TYP\GRNWH-TYP03.dgn