



COUNTY	STATE	PROJECT NO.	YEAR	SHEET NO.	TOTAL SHEETS
SEDGWICK	KANSAS	87 N-0386-01	2009	7R	255

Revised 12/30/2009

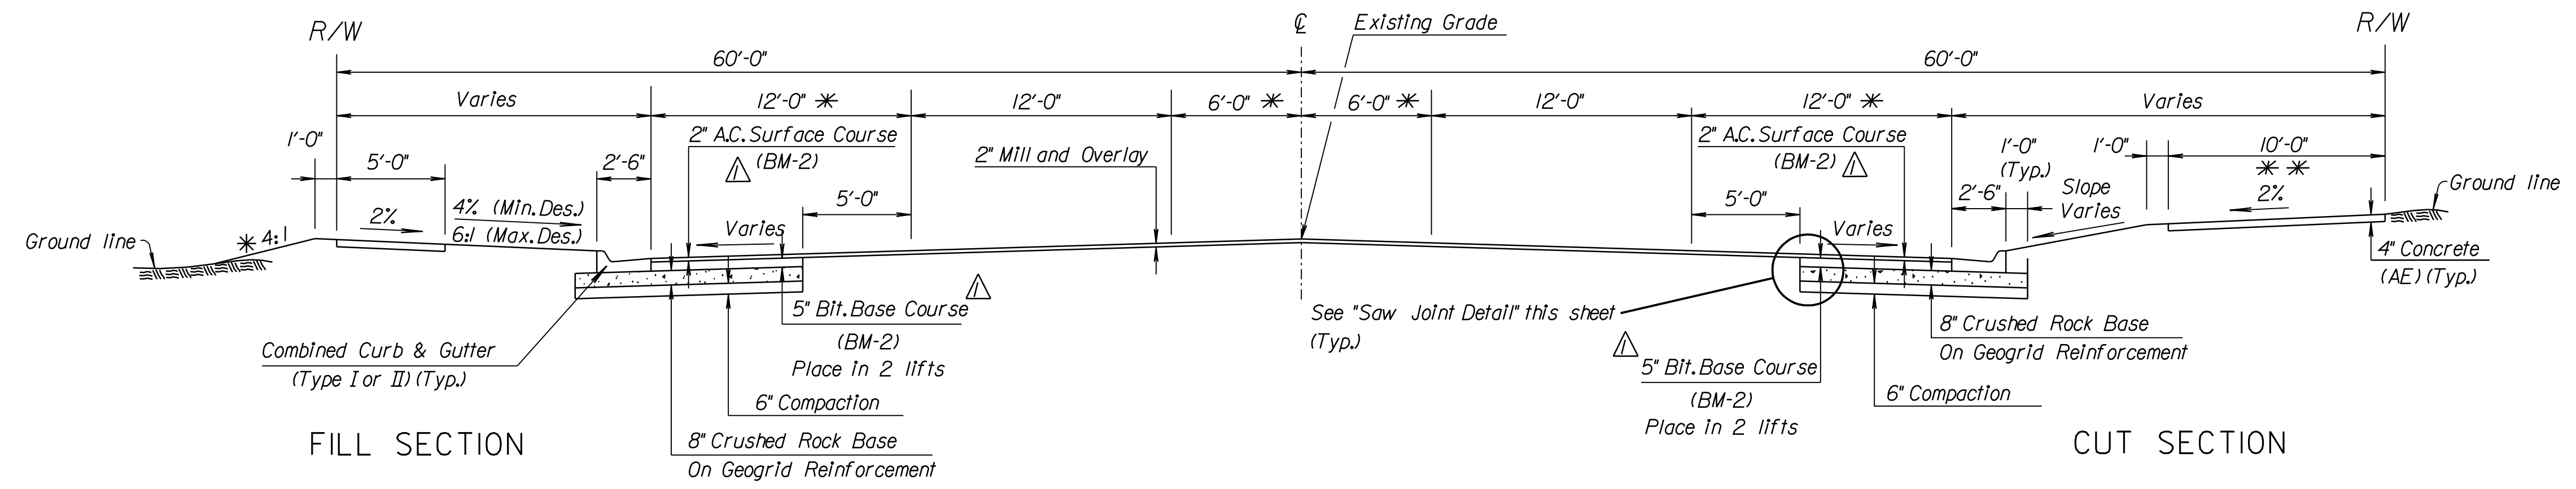


HARRY STREET SECTION

Sta. 38+86.08 to Sta. 44+28.14

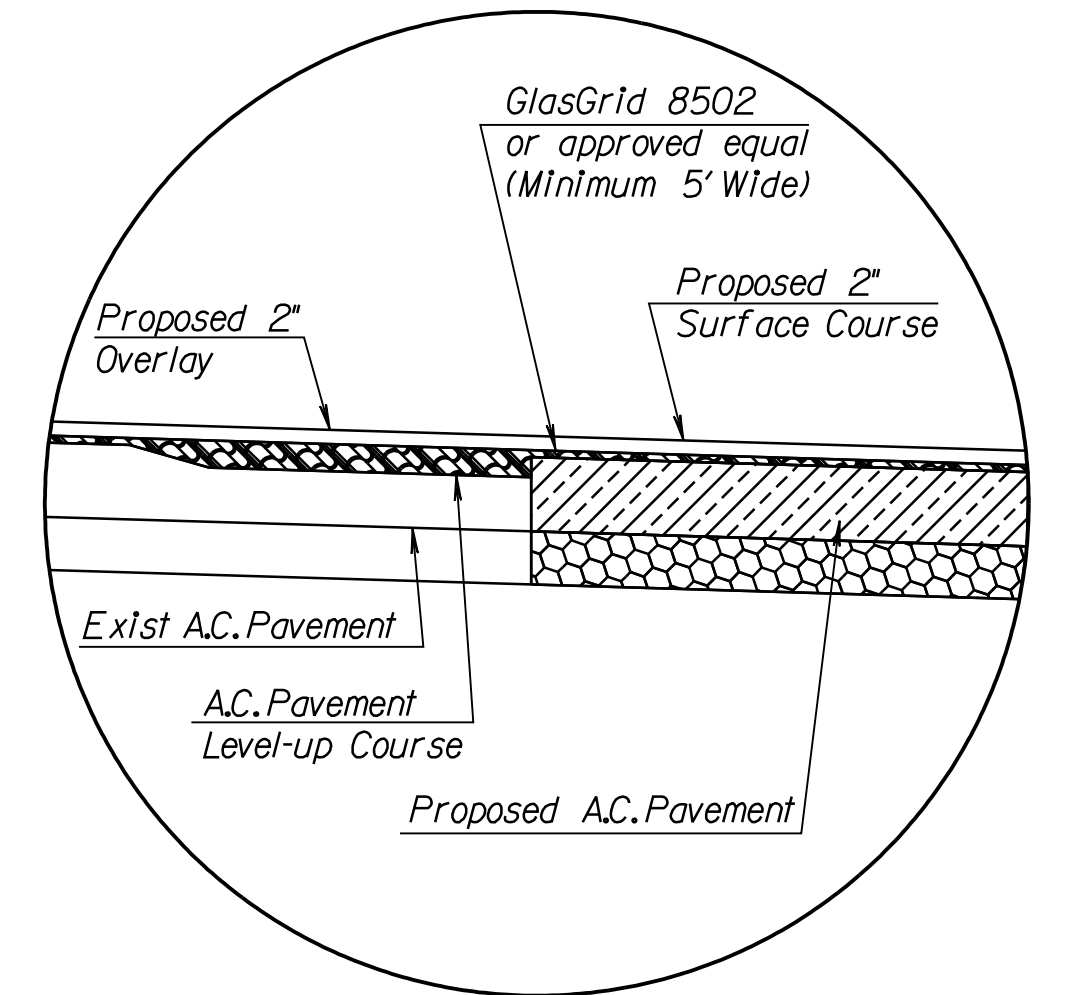


Contractor to mill the existing AC pavement an extra 2" deeper (30" wide minimum) adjacent to saw line. A 2" AC pavement level-up course & GlasGrid 8502, or approved equal, will then be installed prior to surface overlay. Cost for this work to be Subsidiary to the bid item "2" Mill and Overlay"

SAW JOINT DETAIL

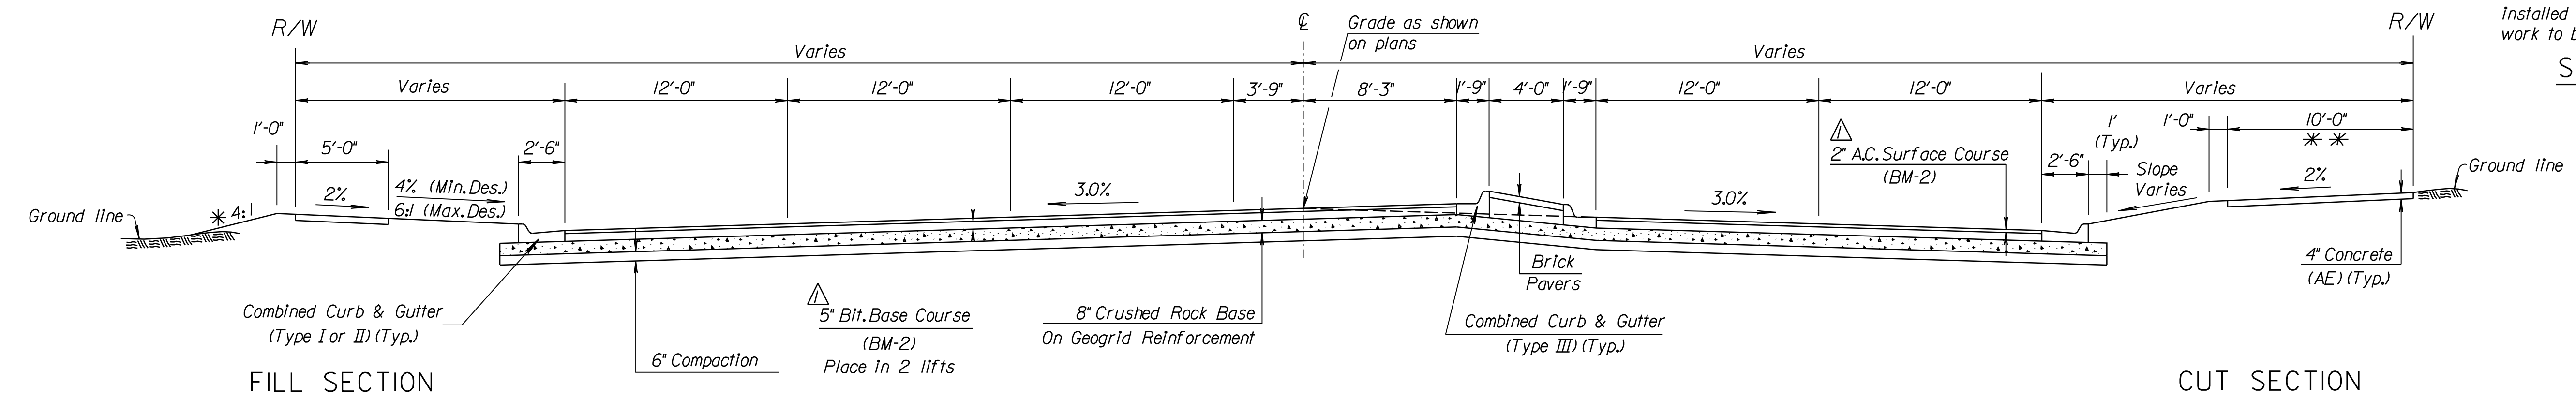

HARRY STREET SECTION

Sta. 50+96.34 to Sta. 51+86.98

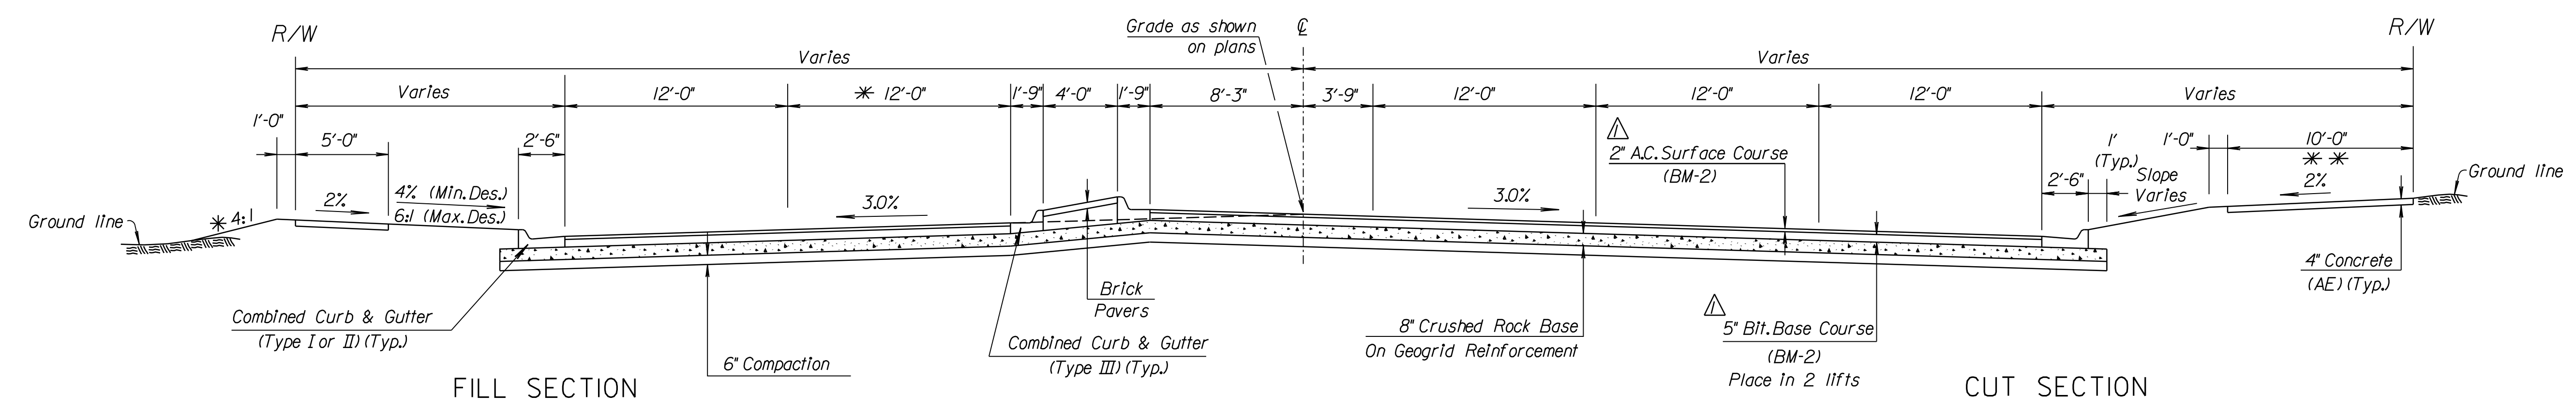

HARRY STREET SECTION

Sta. 45+96.10 to Sta. 48+92.35

- \* See plans and cross sections for variations
- \* \* Bike Path - 10'x10' panels with 1/2" expansion joint every 100'.

CITY OF WICHITA  
 JAMES ARMOUR, P.E., CITY ENGINEER

TYPICAL SECTIONS  
 HARRY STREET

**PB** PARSONS  
 BRINCKERHOFF  
 Wichita, Kansas

SCALE N.T.S. DATE 11/23/2009 DWG. NO. 35751A

K:\35751A\CADD\SHEETS\ROADWAY\TYP\GRNWH-HYTYPOI.dgn  
 SURV. PLOT CADD DES. RAN DR. JRI TR. CKD. JRI APP.