
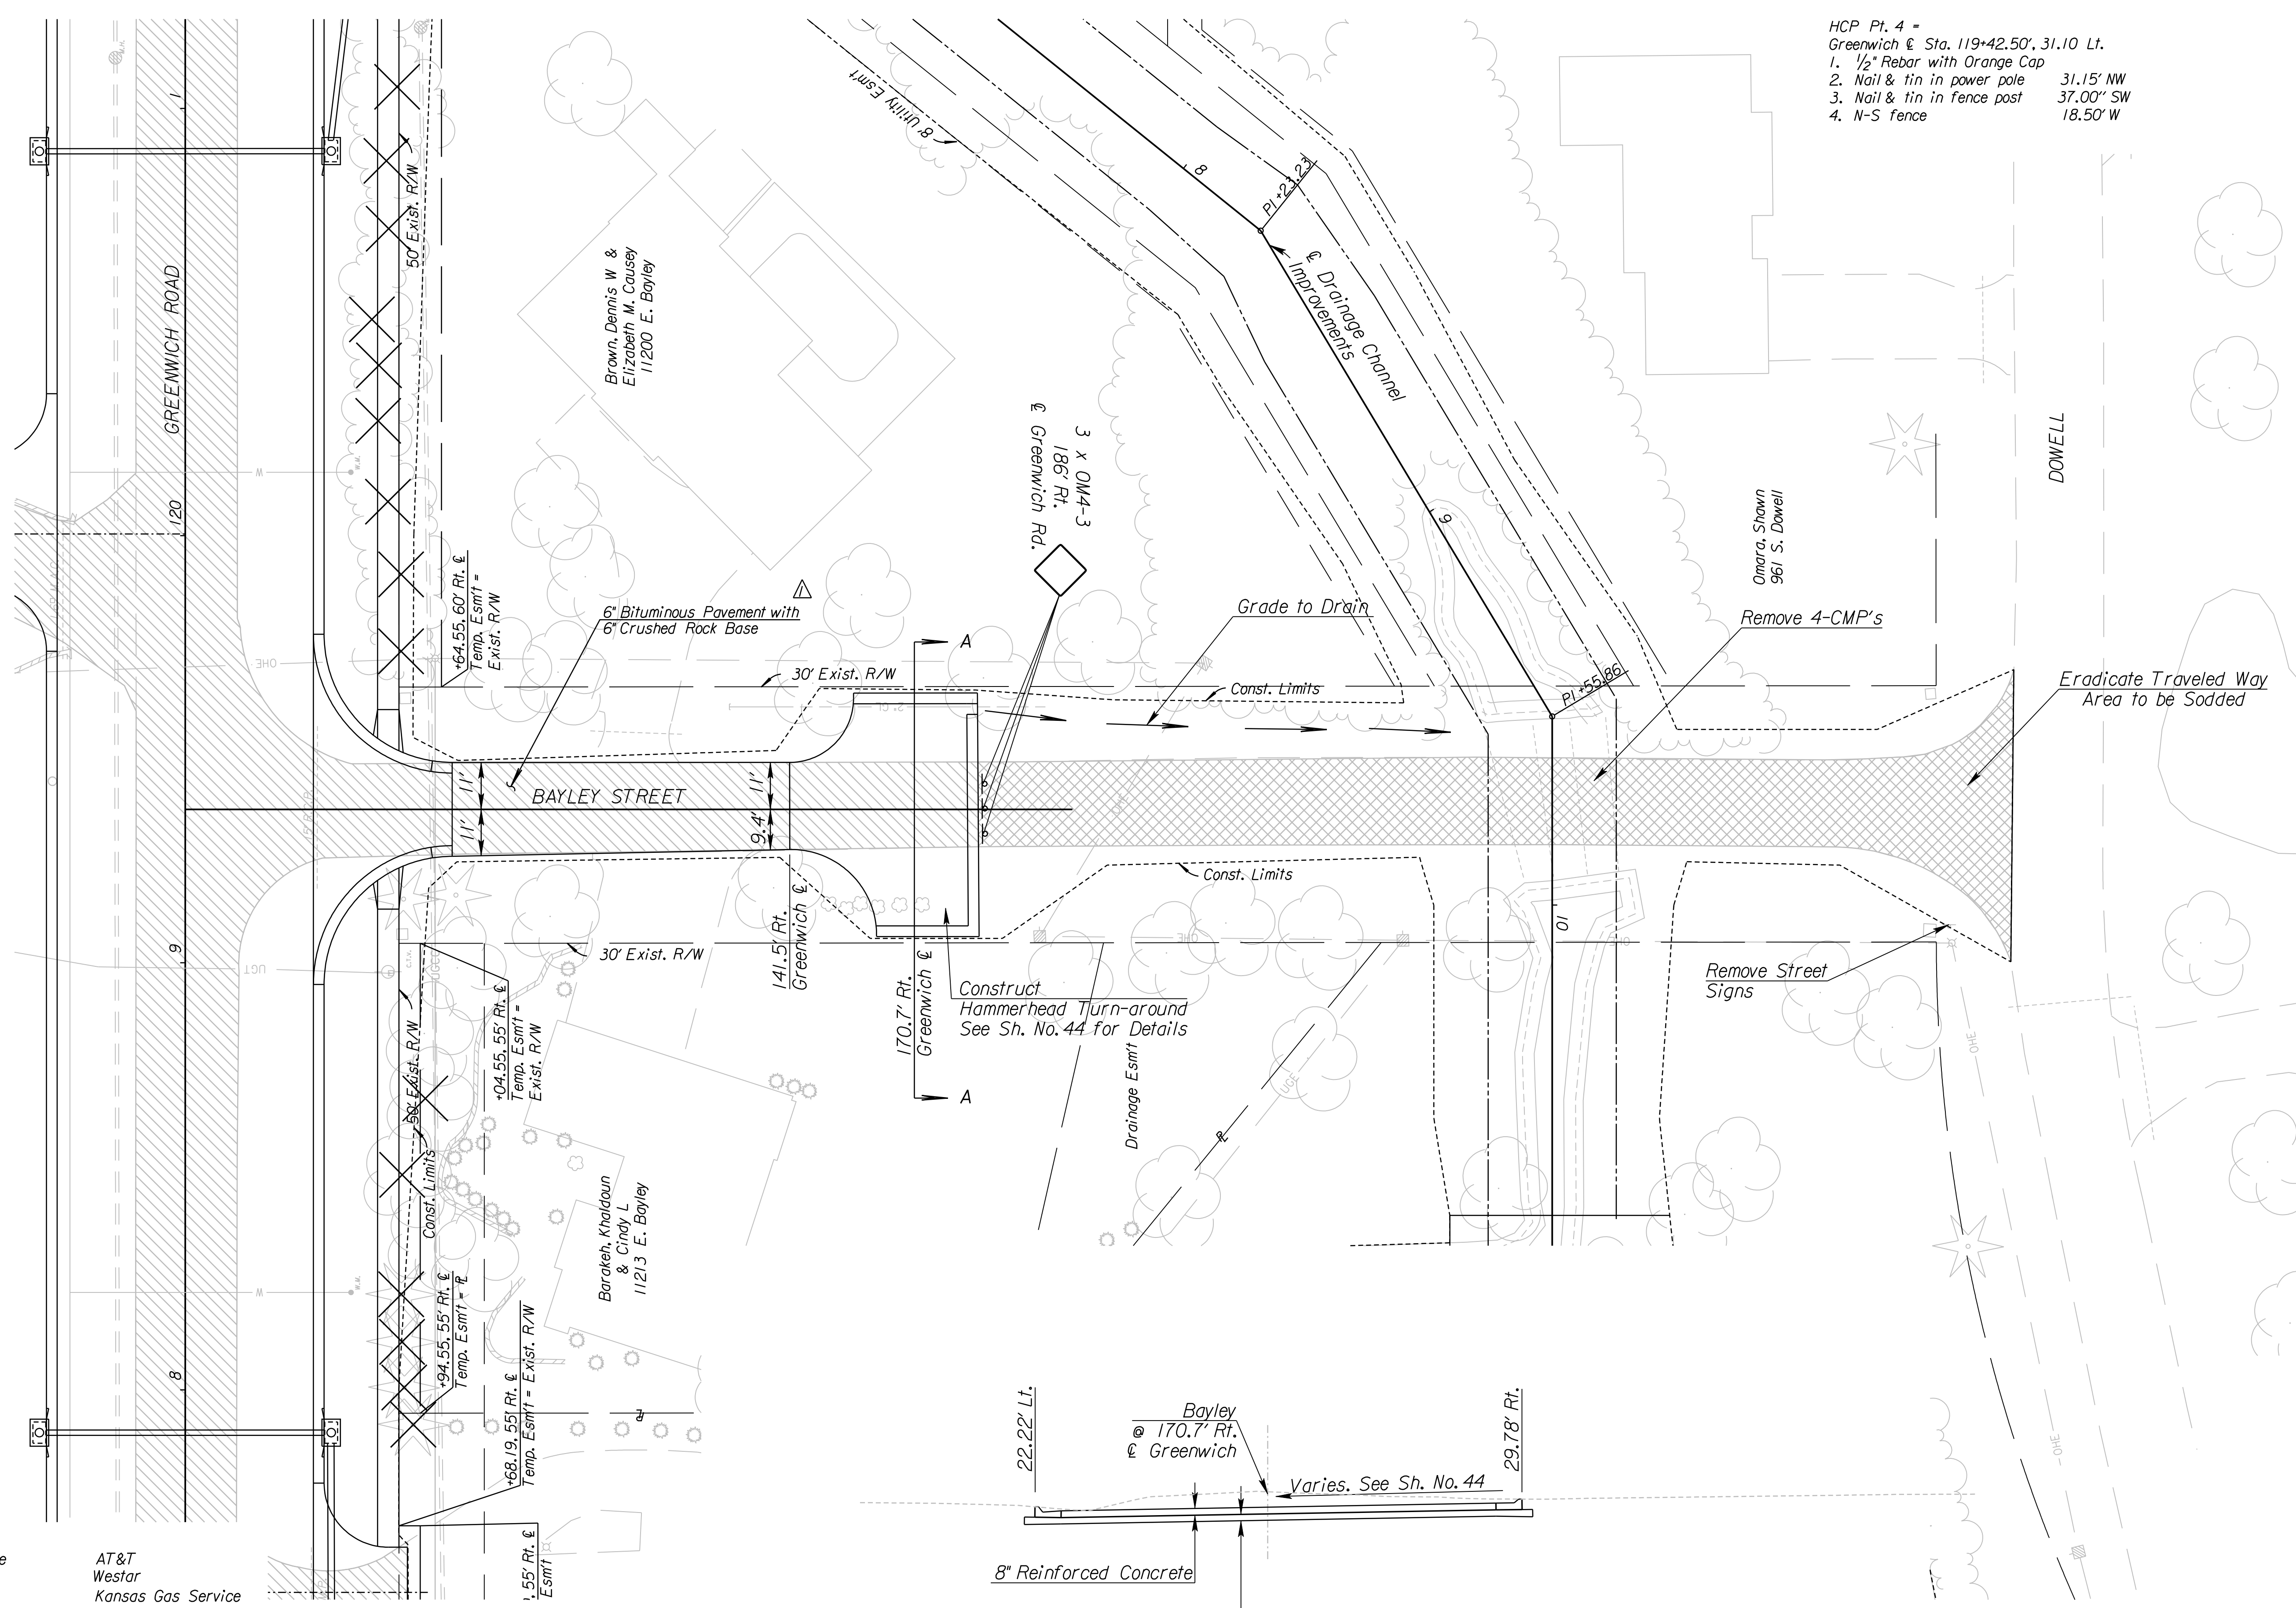


COUNTY	STATE	PROJECT NO.	YEAR	SHEET NO.	TOTAL SHEETS
SEDGWICK	KANSAS	87 N-0386-01	2009	41R	255


Revised 12/30/2009

- HCP Pt. 4 =
 Greenwich & Sta. 119+42.50', 31.10 Lt.
 1. 1/2" Rebar with Orange Cap
 2. Nail & tin in power pole 31.15' NW
 3. Nail & tin in fence post 37.00" SW
 4. N-S fence 18.50' W

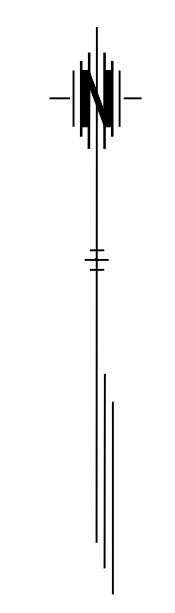

LEGEND

	Pavement to be Removed
	Traveled Way to be Eradicated

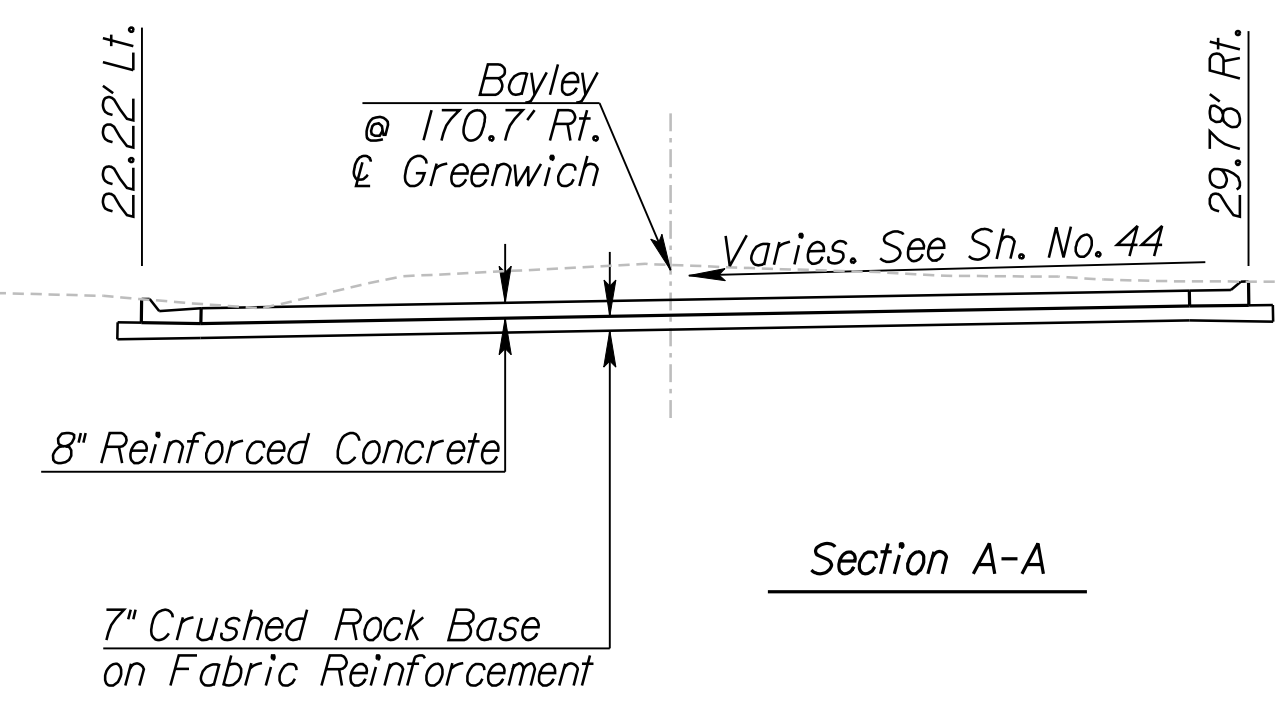

K:\35751A\CADD\SHEETS\ROADWAY\BAYLEY\PL.dgn
 SURV. - PLOT CADD DES. RAN DR. JR TR. CKD. JUR APP.

Telephone
 Electric
 Gas
 Water
 Sanitary Sewer
 Cable TV

AT&T
 Westar
 Kansas Gas Service
 City of Wichita
 City of Wichita
 Cox Communications

CITY OF WICHITA
 JAMES ARMOUR, P.E., CITY ENGINEER
 BAYLEY STREET
 PLAN

PB PARSONS BRINCKERHOFF
 122. Wichita, Kansas

SCALE 1"=20' DATE 11/23/2009 DWG. NO. 35751A