



COUNTY	STATE	PROJECT NO.	YEAR	SHEET NO.	TOTAL SHEETS
SEDGWICK	KANSAS	87 N-0386-01	2009	88R	255

Revised 12/30/2009

Scale
Horizontal: 1" = 20'
Vertical: 1" = 2'

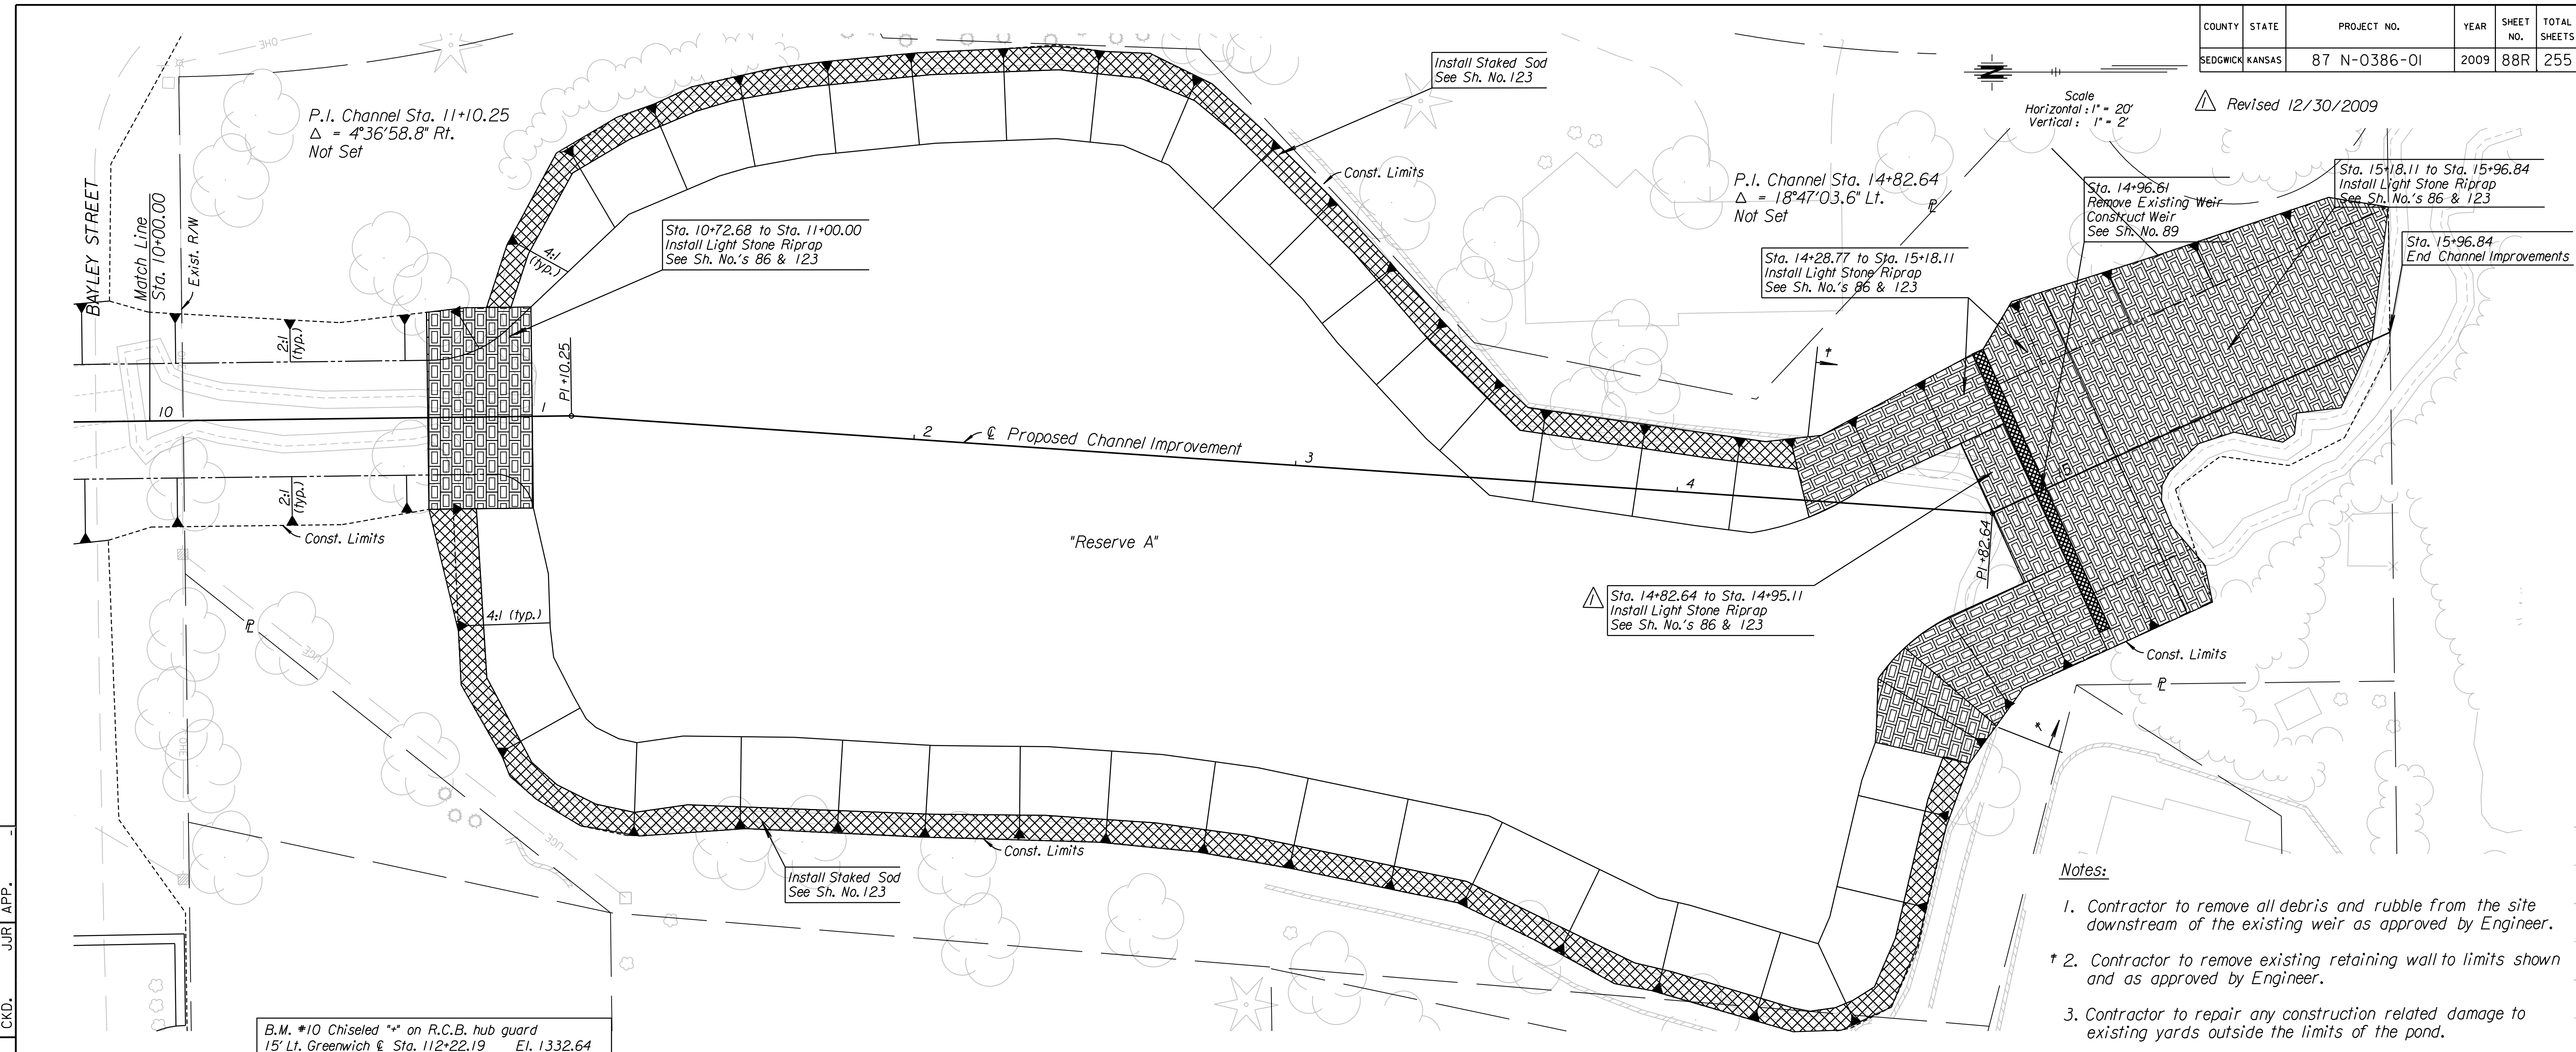

- Notes:
1. Contractor to remove all debris and rubble from the site downstream of the existing weir as approved by Engineer.
 - † 2. Contractor to remove existing retaining wall to limits shown and as approved by Engineer.
 3. Contractor to repair any construction related damage to existing yards outside the limits of the pond.

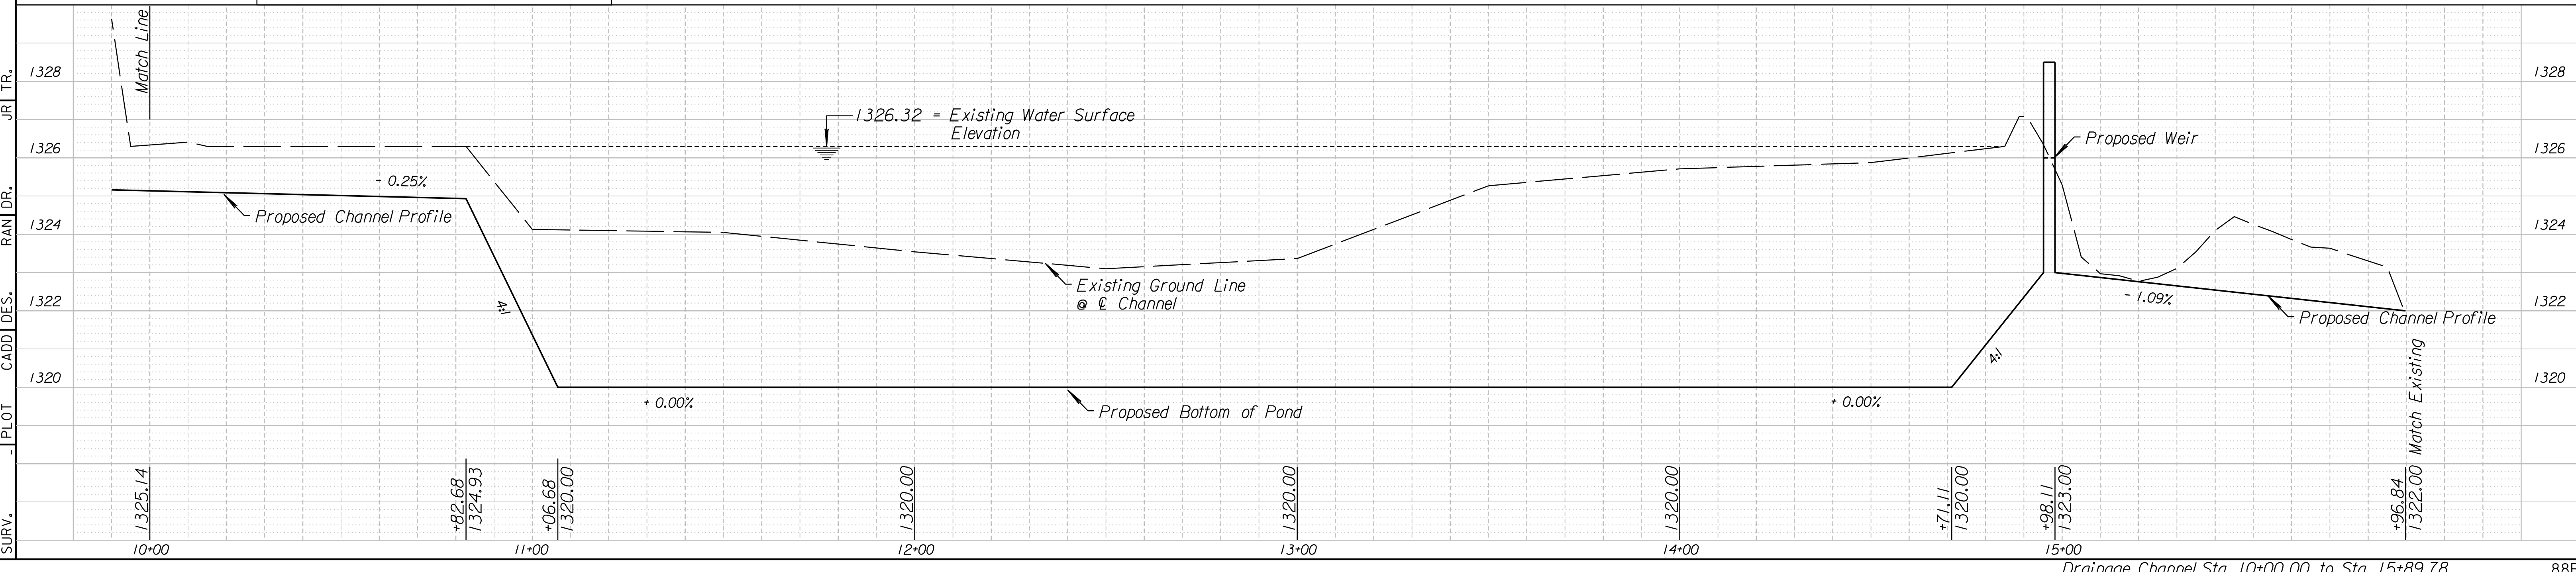

SURV. PLOT CADD DES. RAN DR. JR TR. CKD. JUR APP.