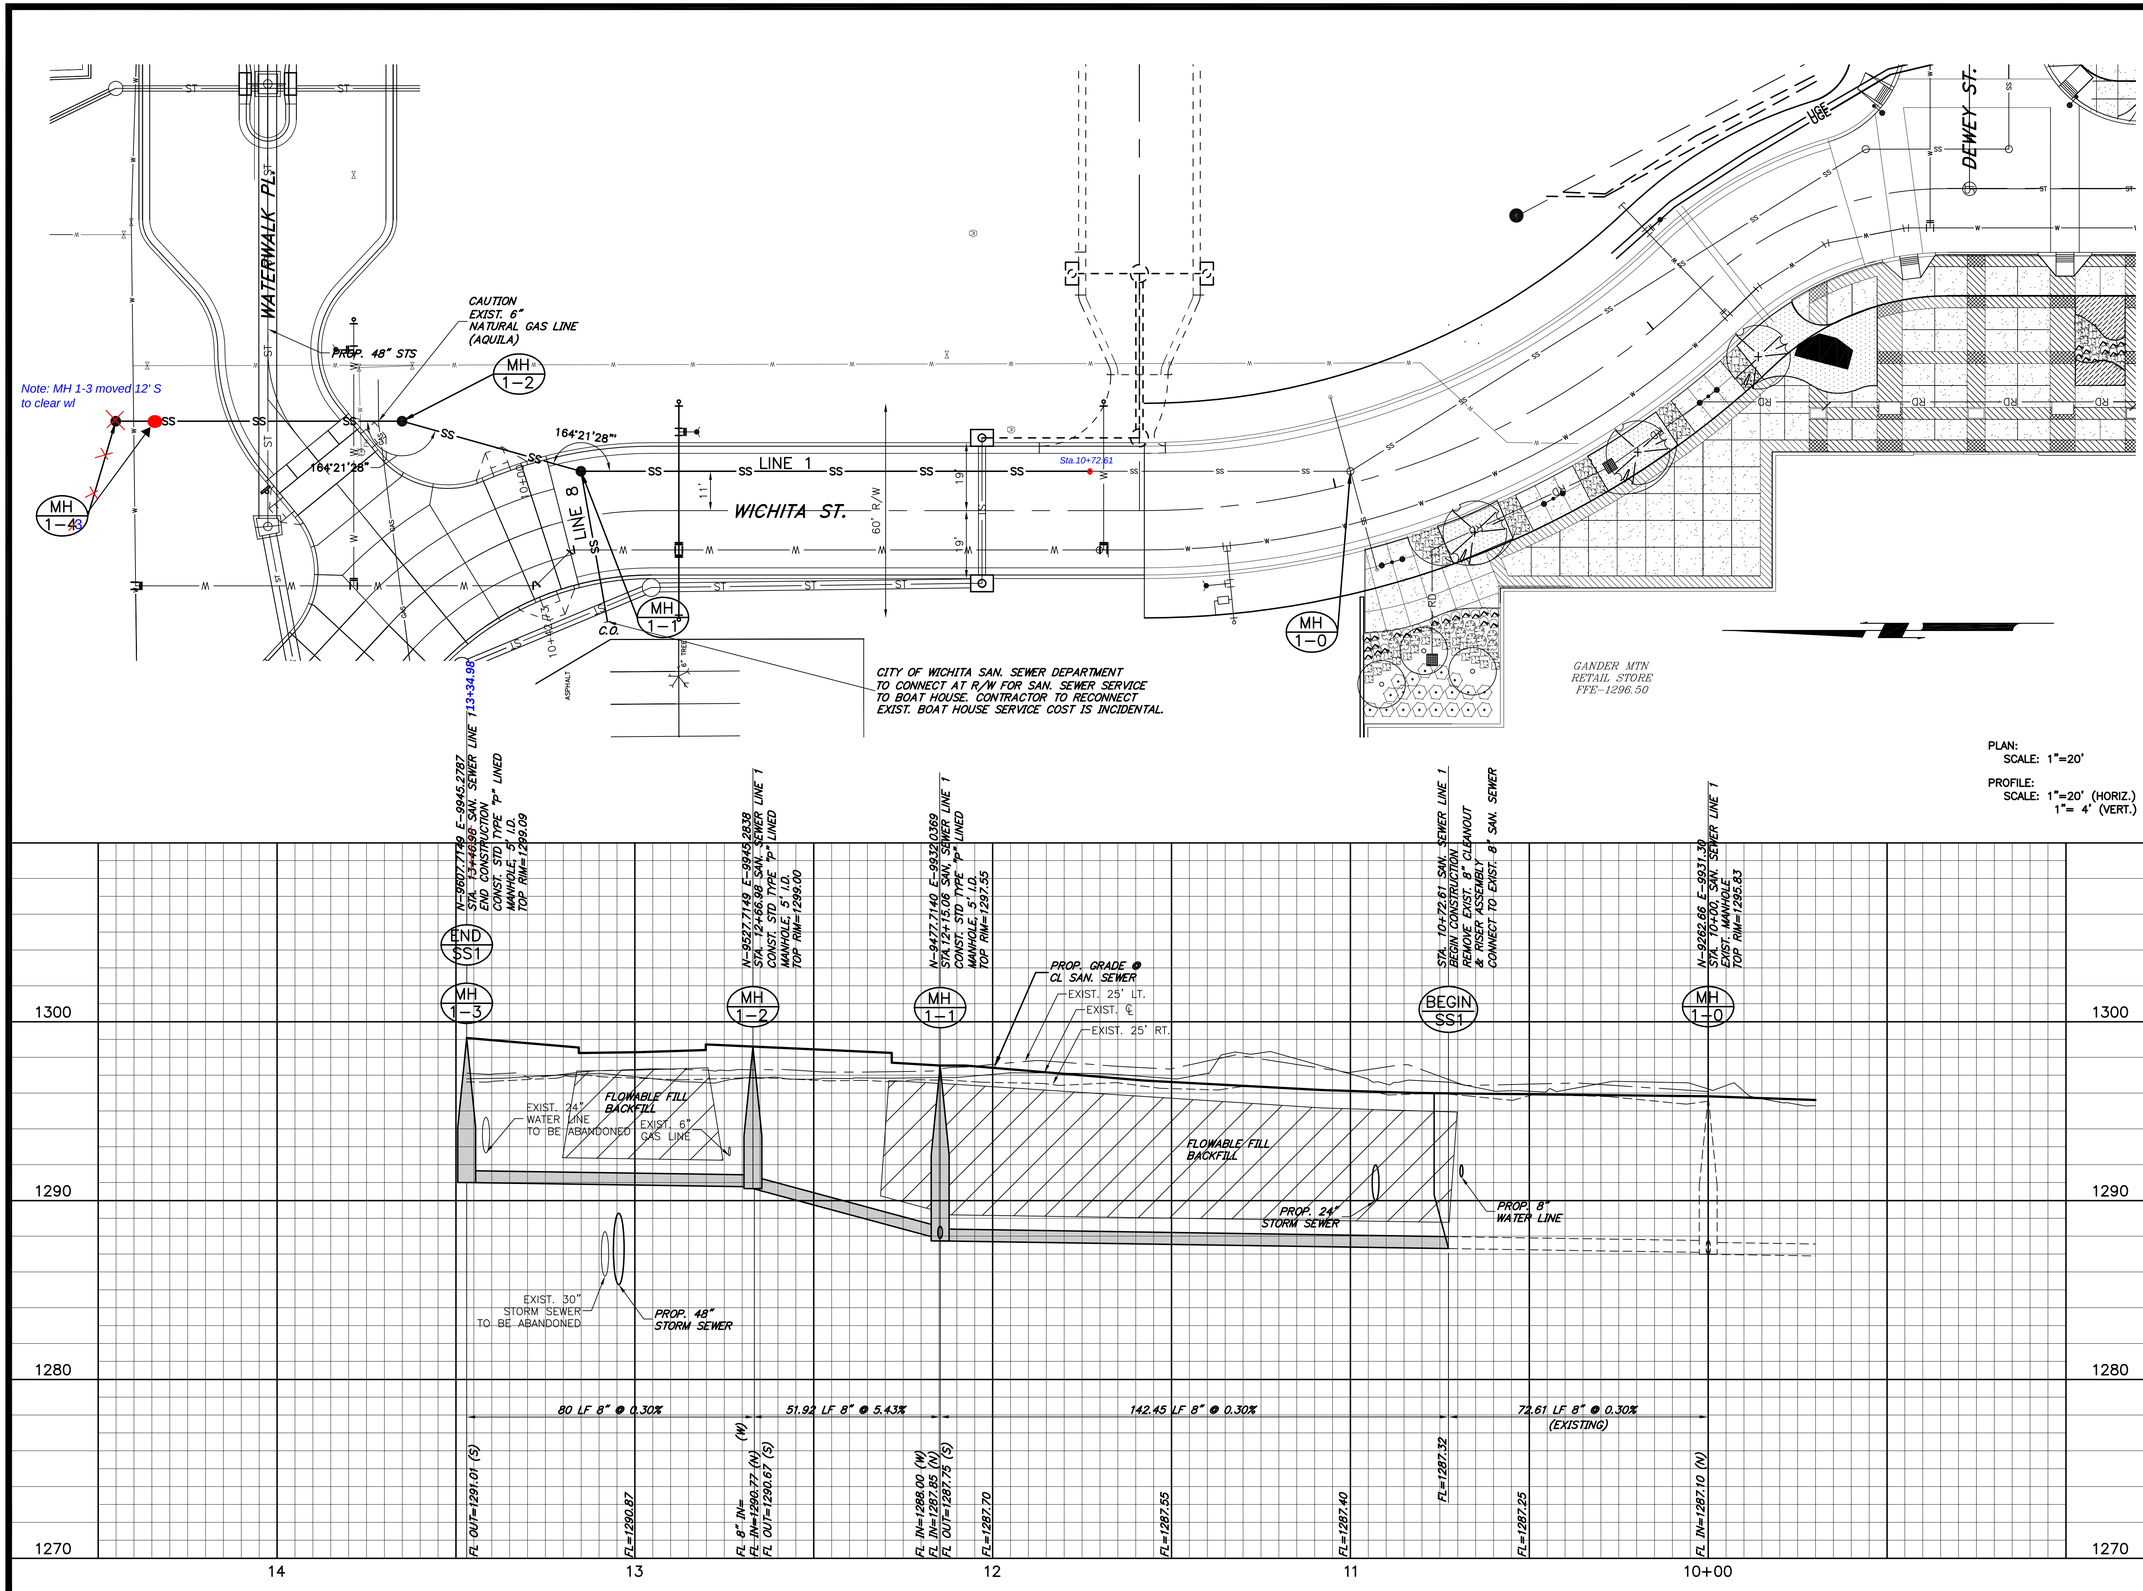

GossenLivingston
Architecture
420 South Emporia
Wichita, KS 67202
Tel: (316) 265-9367
Fax: (316) 265-5646
Email: architects@glal.com

© 2006 Gossen Livingston Associates, Inc.
The drawing and all information herein is the exclusive property of Gossen Livingston Associates, Inc. and is not to be copied or used in any way without the express written consent of Gossen Livingston Associates, Inc. All drawings, specification, ideas, designs and arrangements appearing herein constitute the original and unpublished Work of:
Gossen Livingston Associates, Inc.

JOHNSON & ASSOCIATES
Johnson & Associates, Inc.
100 E. California Ave. - Third Floor
Oklahoma City, OK 73104
(405) 235-8075 FAX (405) 235-8078
Certificate of Authorization #E-1128 EXP. DATE: 12-31-2006

WICHITA WATERWALK

PUBLIC IMPROVEMENTS PACKAGE 2 PHASE 2

Mark	Date:	Description
	05.30.06	BID SET
1	04.27.06	FIELD CHECK

SANITARY SEWER LINE 1

Job No.
Date 05-30-06
Drawn
Checked

SS1.1
OF
6
Dwg. 66 of 96

CAD FILE: H:\2215\2215 Prv. 2-Street\22151012-SEWER.dwg, 5/30/2006 10:38 AM, Peter Bowell
XREFS: LOADED: