FHWA REGION NO.	STATE	PROJECT NO.	YEAR	SHEET NO.	TOTAL SHEETS
7	KANSAS		2003	26 A	60

DATE	BY

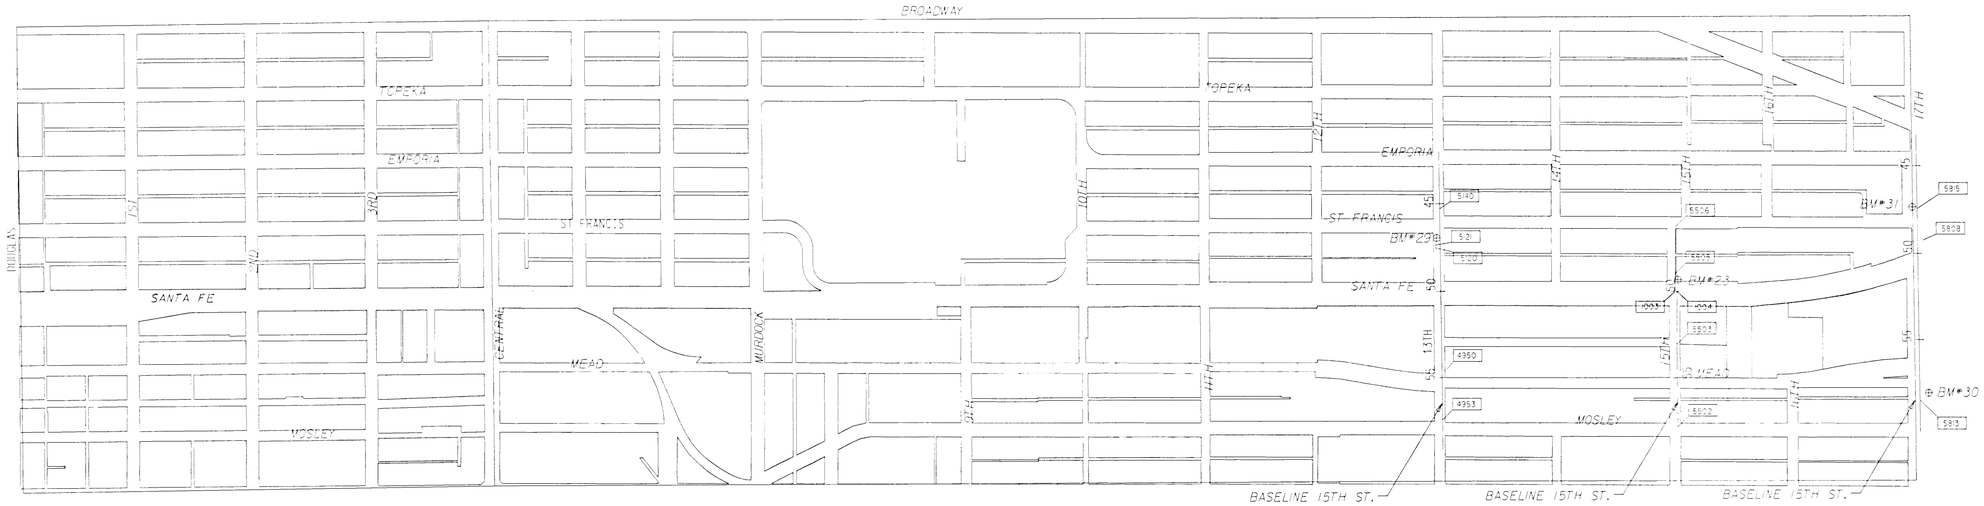

BENCH MARKS

BM #23- Chiseled "□" on Top of Curb, West End of Curb Return, Northwest Corner of Santa Fe Avenue & 15th Street. Elev.= 1306.82

BM #29- Chiseled "□" on Top of South Curb of 13th Street, 120' East of Center Line of St. Francis Avenue Elev.= 1304.71

BM #30- Chiseled "□" on Top of North Curb, South of Fire Hydrant, Northwest Corner of 17th Street & Mead Avenue Elev.= 1309.12

BM #31- Chiseled "□" on Top of Curb, South End of Curb Return, Southwest Corner of 17th Street & St. Francis Avenue Elev.= 1308.19

WATER METER TABLE FOR WATERLINE #5

Meter No.	Street	Baseline Station	Dist. /Direction	Comments
501	Santa Fe	2+83	18.38'/Rt	Connection in roadway (long service)
502	Santa Fe	4+97	6.29'/Rt	Connection in roadway (long service)
503	Santa Fe	5+21	3.58'/Rt	Connection in roadway (long service)
504	Santa Fe	6+14	3.24'/Rt	Connection in roadway (long service)
505	Santa Fe	7+04	10.86'/Rt	Connection in roadway (long service)
506	Santa Fe	9+59	12.12'/Rt	Connection in roadway (long service)
507	Santa Fe	10+24	12.96'/Rt	Connection in roadway (long service)
508	Santa Fe	10+68	8.80'/Rt	Connection in roadway (long service)
509	Santa Fe	14+91	3.02'/Rt	Connection in roadway (long service)
510	Santa Fe	19+60	3.18'/Rt	Connection in roadway (long service)
511	Santa Fe	21+52	7.63'/Rt	Connection in roadway (long service)
512	Santa Fe	23+91	7.79'/Rt	Connection in roadway (long service)

BASELINE 13TH ST.

Pt. No. 5121
Found Bent #4 Bar at Point
N 1693801.8422, E 1650656.4764
Base Line 13th St. - Sta. 47+90.15
1. Near NE Corner of lot 344, East Block, Ferrell's 2nd Addition
2. No other Ties

Pt. No. 4950 □
Found Chiseled " " on Sidewalk at Point
N 1693957.9362, E 1651129.0970
Base Line 13th St. - Sta. 52+52.81
1. SE Corner of Lot 8, Parmenters 2nd Addition
2. No other Ties

Pt. No. 4953
Found Iron Pin & Thimble at Point
N 1693838.2213, E 1651154.5202
Base Line 13th St. - Sta. 52+77.68
1. Center Line of 13th Street
2. Center Line of Barwise Avenue
3. No other Ties
Pt. No. 5120
Found 3/8" Iron Pin at Point
N 1693802.0382, E 1650667.5857
Base Line 13th St. - Sta. 47+79.004
1. NW corner of Lot 343, East Block, Ferrell's 2nd Addition
2. No other Ties

Pt. No. 5140
Found Iron Pin in Thimble at Point
N 1693829.0064, E 1650426.2598
Base Line 13th St. - Sta. 45+49.37
1. Center line 13th Street
2. West R/W of St. Francis Avenue
3. No other Ties

BASELINE 15TH ST.

Pt. No. 5506
N-1,695,139.2009, E-1,650,483.7508
℄ 15th St. - Sta. 46+31.21
Set 60d Nail

1. ℄ 15th Street	E-W
2. ℄ St. Francis Avenue	38.00' E
3. PK Nail	38.36' WSW
4. SW Corner of Block Building	25.00' N
5. Top Center of Fire Hydrant	31.26' NW

Pt. No. 5505
N-1,695,137.8447, E-1,650,750.8428
℄ 15th St. - Sta. 48+98.31
Set 60d Nail

1. ℄ 15th Street	E-W
2. ℄ Santa Fe Avenue	57.50' E
3. Top Center of Fire Hydrant	41.57' SE
4. Ctr. of 3" SN. Cor. Post of Chain Link Fence	37.02' NE

Pt. No. 1002
N-1,695,139.8512, E-1,650,852.5241
℄ 15th St. - Sta. 50+00.00
1. No Ties

Pt. No. 1003
N-1,695,149.7202, E-1,650,852.3213
℄ 15th St. - Sta. 50+00.00
1. No Ties

Pt. No. 5503
N-1,695,152.9043, E-1,651,163.4762
℄ 15th St. - Sta. 53+11.17
Set 60d Nail

1. ℄ 15th Street	E-W
2. ℄ Barwise Avenue South	29.00' W
3. ℄ Concrete Joint on Barwise Avenue South	29.10' W
4. Top Center of Fire Hydrant	37.16' NW
5. Center of 3" Steel Corner Post of Fence	29.35' S

Pt. No. 5502
N-1,695,166.4688, E-1,651,630.2049
℄ 15th St. - Sta. 57+73.10
Found Iron Pin in Thimble
1. Intersection of ℄ 15th Street & ℄ Mosley Avenue
2. No other Ties

BASELINE 17TH ST.

Pt. No. 5808
Found 1/2" Iron Pin with Threaded Cap at Point (Possibly a Lot Corner)
N 1696513.4790, E 1650607.9683
Base Line 17th St. - Sta. 49+45.24
1. Fence Corner
2. No other Ties

Pt. No. 5813
Set PK Nail at Point
N 1696492.7796, E 1651250.5300
Base Line 17th St. - Sta. 55+87.35
1. Intersection of Center Line of 17th Street & Center Line of Mead Avenue
2. Top Center of Fire Hydrant
3. Center of 2" Steel Corner Post of Chainlink Fence
4. Center of West Rail of Railroad Tracks

Pt. No. 5815
Set PK Nail at Point
N 1696472.8047, E 1650407.1138
Base Line 17th St. - Sta. 47+43.82
1. Center Line 17th Street
2. West Back of Curb on St. Francis Avenue
3. Concrete Telephone Marker Post
4. Top Center of Fire Hydrant
5. Top of Telephone Pedestal #550

This sheet designed by:

HNTB
ARCHITECTS ENGINEERS PLANNERS

NO.	DATE	REVISIONS	BY	APP'D
3				
2				
1				

CITY OF WICHITA

WICHITA CENTRAL CORRIDOR
HORIZONTAL & VERTICAL CONTROL MAP

WATER METER TABLE

SHEET NO. OF	SCALE	APP'D	
DESIGNED	DETAILED	QUANTITIES	TRACED
DESIGN CK.	DETAIL CK.	QUAN.CK.	TRACE CK.

26 A

Plotted on: Thursday April 03, 2003 03:00 PM
Alayhoff Plot Queue: \\WPPLOTB\XEROX.QEN
Plot Scale: 400.0000000000000 Pen Tables: \\wpwin00\jobs\29949\highway\Library\plotpen\fulpen
Design Filenames: J\29949\CD\plan\wc_waterControl.dgn