
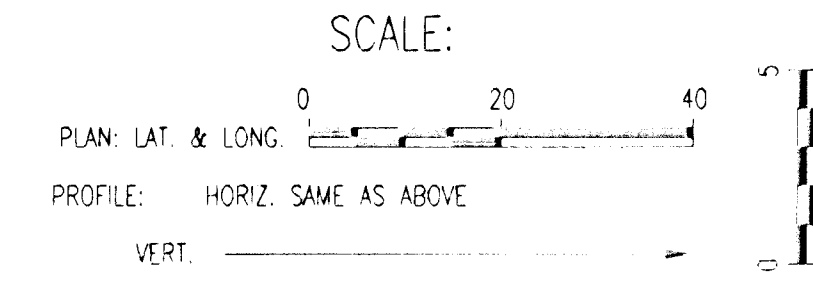


DATE: _____
 BY: _____
 CHECKED: _____
 PLAN

DATE: _____
 BY: _____
 CHECKED: _____
 PROFILE



DSR: MKK OPER: JLM SCALE: 1"=20.00'
 0:\1995\93163\004\sewer\Sanitarysewer_15th_03-26-2003_09:59:44.dwg

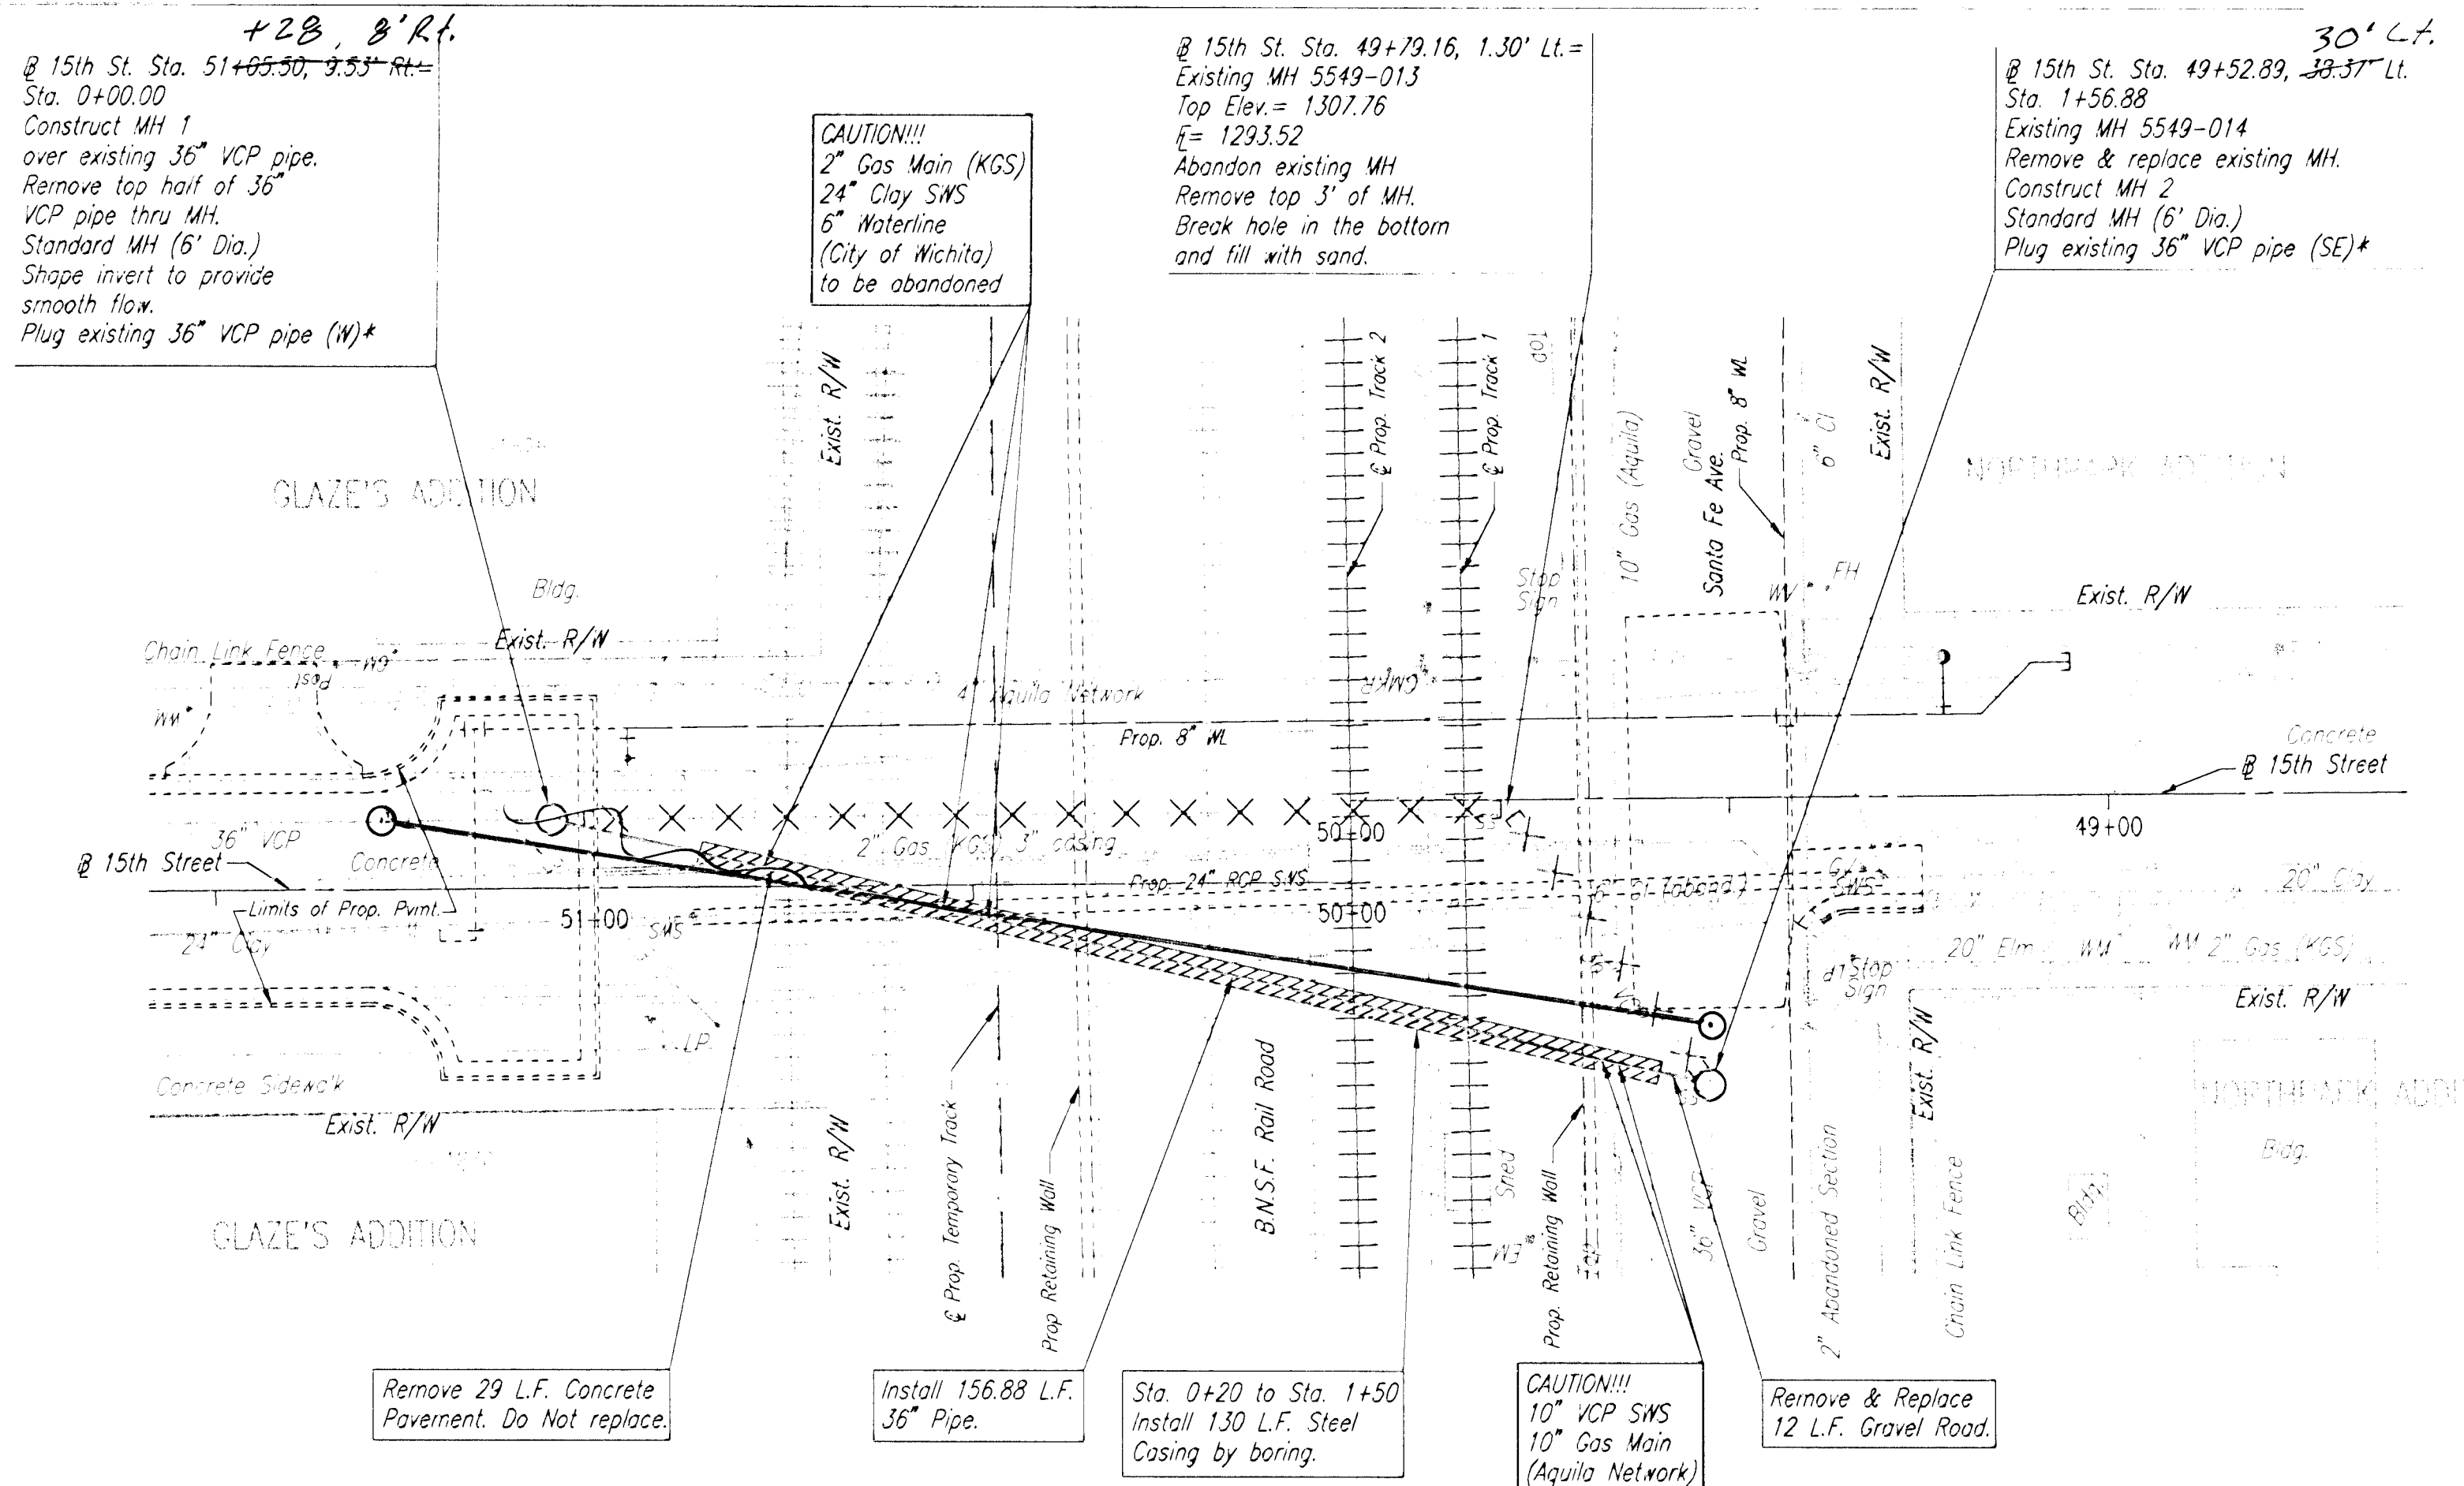

*CONTRACTOR SHALL FILL EXISTING 36" SANITARY SEWER TO BE ABANDONED WITH JETTED SAND OR FLOWABLE FILL TO THE LIMITS SHOWN. PRICE SUBSIDIARY TO PROJECT COSTS.

SANITARY SEWER LINE NO. 1

□ - Denotes Caps or Plugs to be installed
 X - Denotes Sanitary Sewer to be Abandoned.

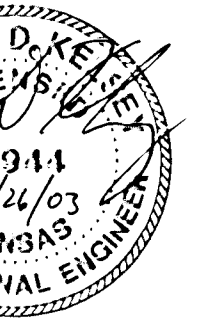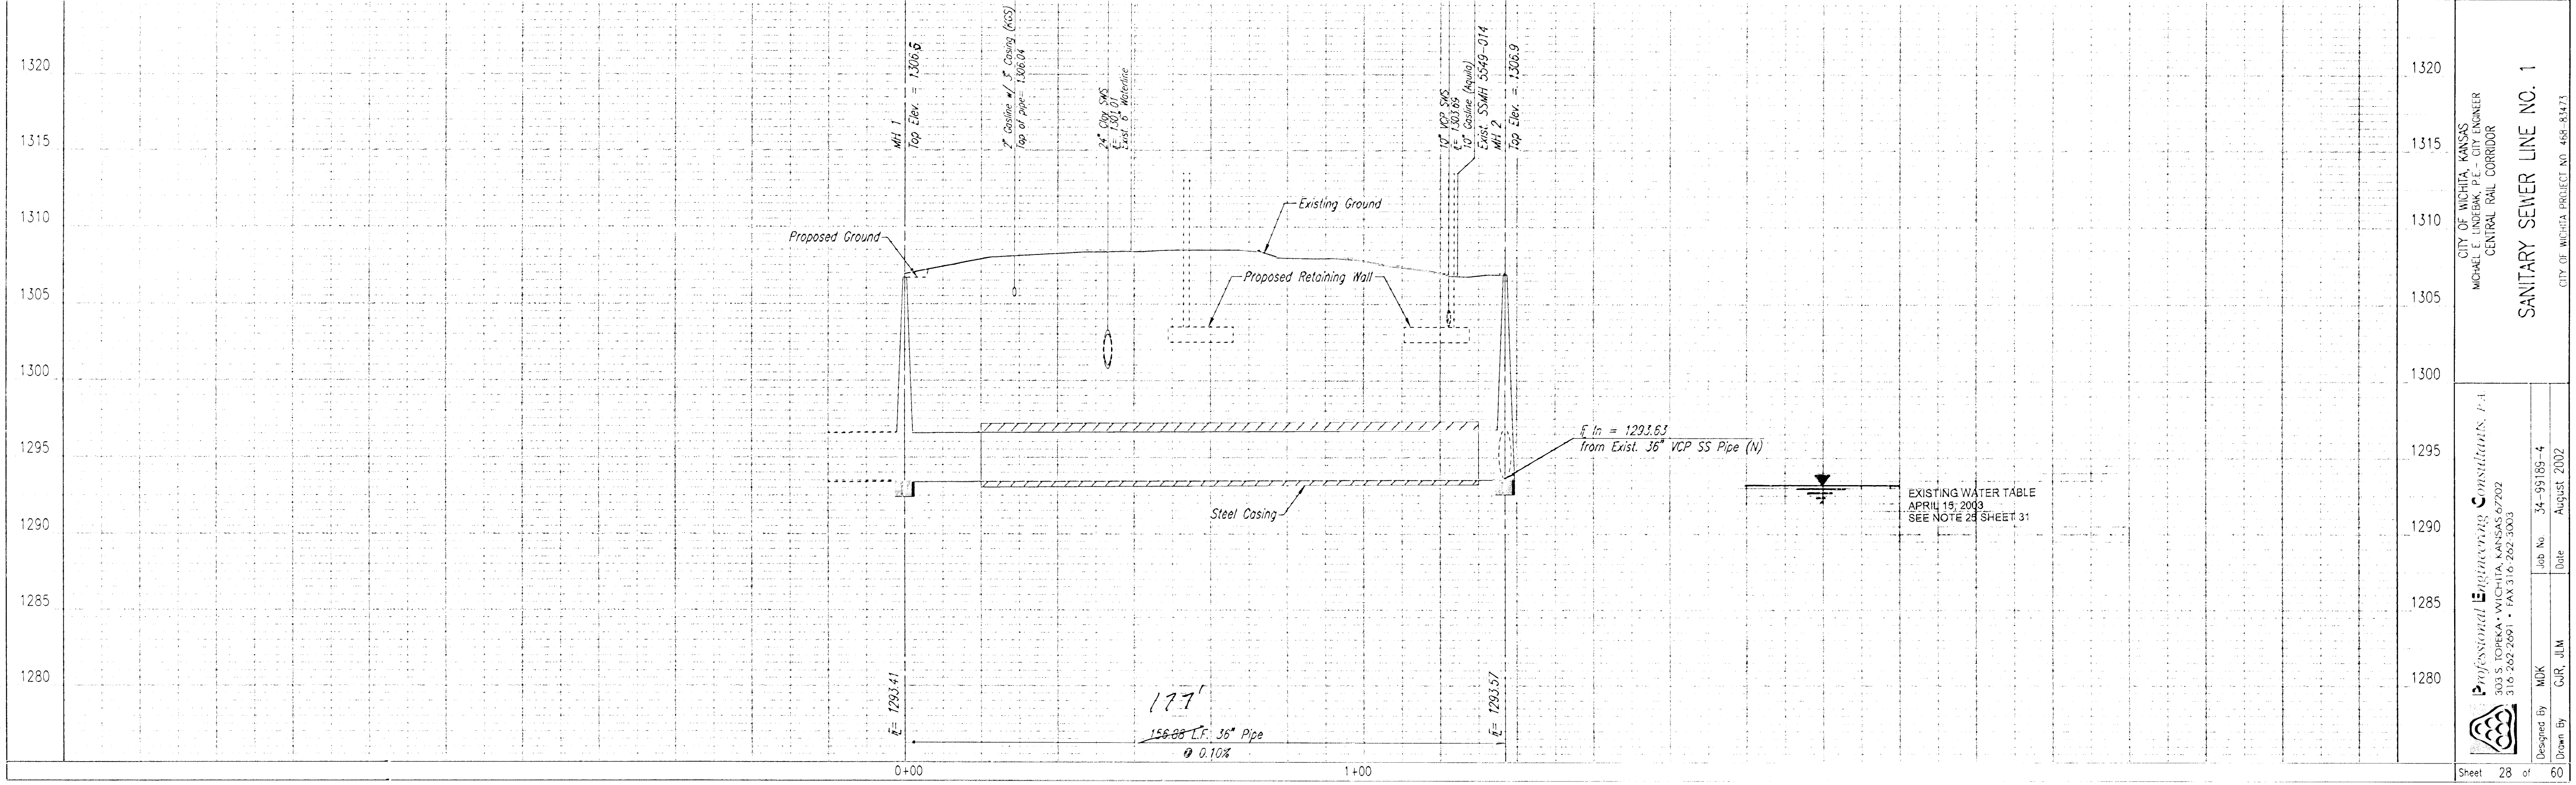

CITY OF WICHITA, KANSAS
 CENTRAL RAIL CORRIDOR

SANITARY SEWER LINE NO. 1

CITY OF WICHITA PROJECT NO. 468-81473

Professional Engineering Consultants, P.A.
 303 S. TOPEKA • WICHITA, KANSAS 67202
 316-262-2691 • FAX 316-262-3003

Designed By: MKK
 Drawn By: GJR, JLM

Job No: 34-99189-4
 Date: August 2002

Sheet 28 of 60