


△ Revised Roadway Base 6/4/09 JCK  
 △ Revised CaCl Application Rate 6/4/09 JCK

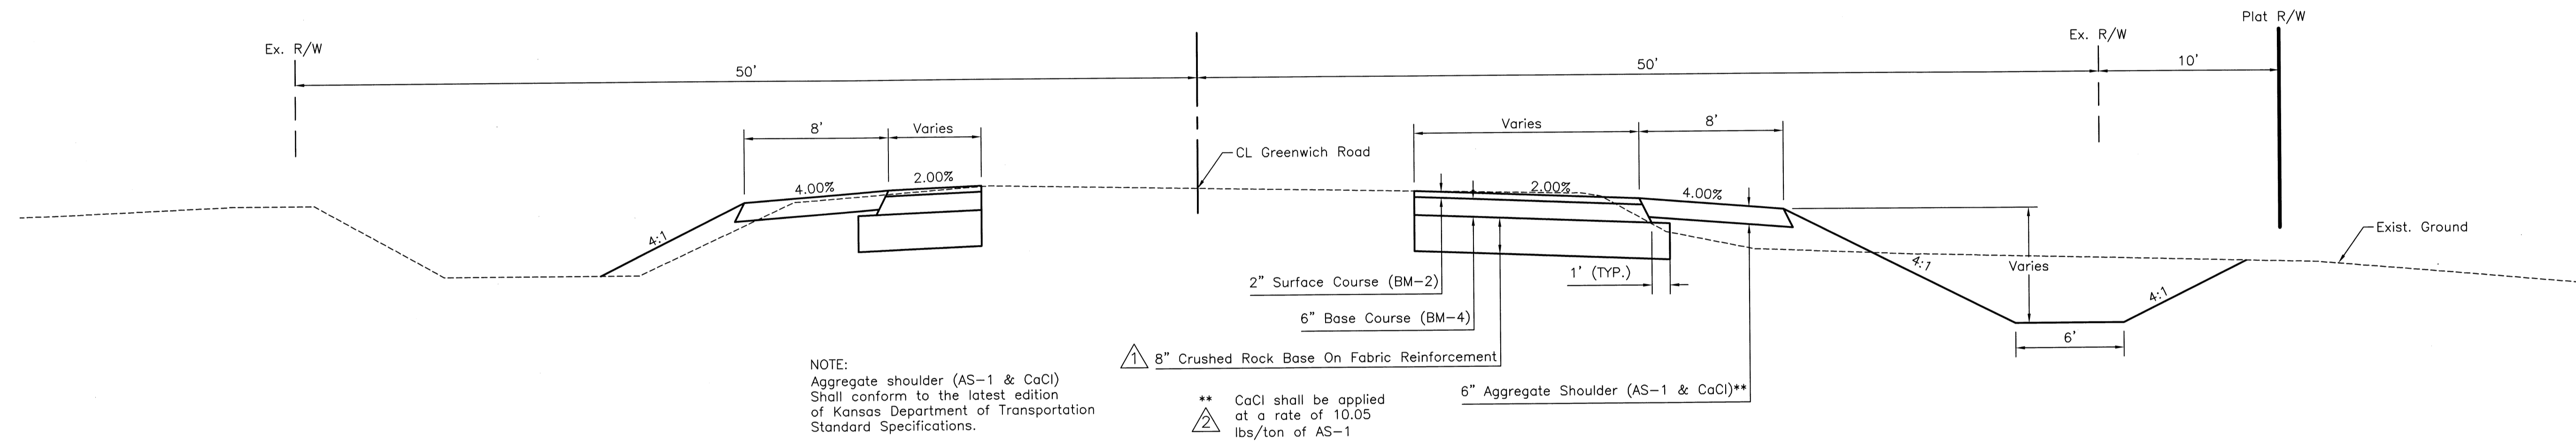

NOTE:  
 Aggregate shoulder (AS-1 & CaCl)  
 Shall conform to the latest edition  
 of Kansas Department of Transportation  
 Standard Specifications.

△ 8" Crushed Rock Base On Fabric Reinforcement  
 △ CaCl shall be applied  
 at a rate of 10.05  
 lbs/ton of AS-1  
 △ 6" Aggregate Shoulder (AS-1 & CaCl)\*\*

**GREENWICH ROAD TYPICAL SECTION**  
 STA. 10+00.00 to STA. 19+27.15  
 NTS

Fabric Base Reinforcement shall be BX1100 Geogrid as manufactured by Tensor Corporation or Approved Equal. Fabric base reinforcement shall be installed in accordance with manufacturer's recommendations. Crushed rock shall be uniformly graded from 1-1/2" maximum size to not more than 10% passing a No. 200 sieve. Rock quality shall be the same as specified for course aggregate for concrete.

Rock base shall be compacted and smoothed with a steel faced roller prior to placement of asphalt. Tack coat will not be applied to rock base.



**WILSON & COMPANY**  
 Engineers & Architects  
 1700 East Iron - Salina, Kansas 67401  
 Tel. 785 - 827-0433 Fax 785 - 827-5949

**FACILITY IMPROVEMENTS**  
**CIRCLE UNIFIED SCHOOL DISTRICT U.S.D. NO 375**  
**GREENWICH ROAD**  
**NEW ELEMENTARY SCHOOL**

DESIGN	JCK
DRAWN	CJT
DATE	06/09
FILE NO.	08-500-037-00

SHEET NO.  
**C2.1**