

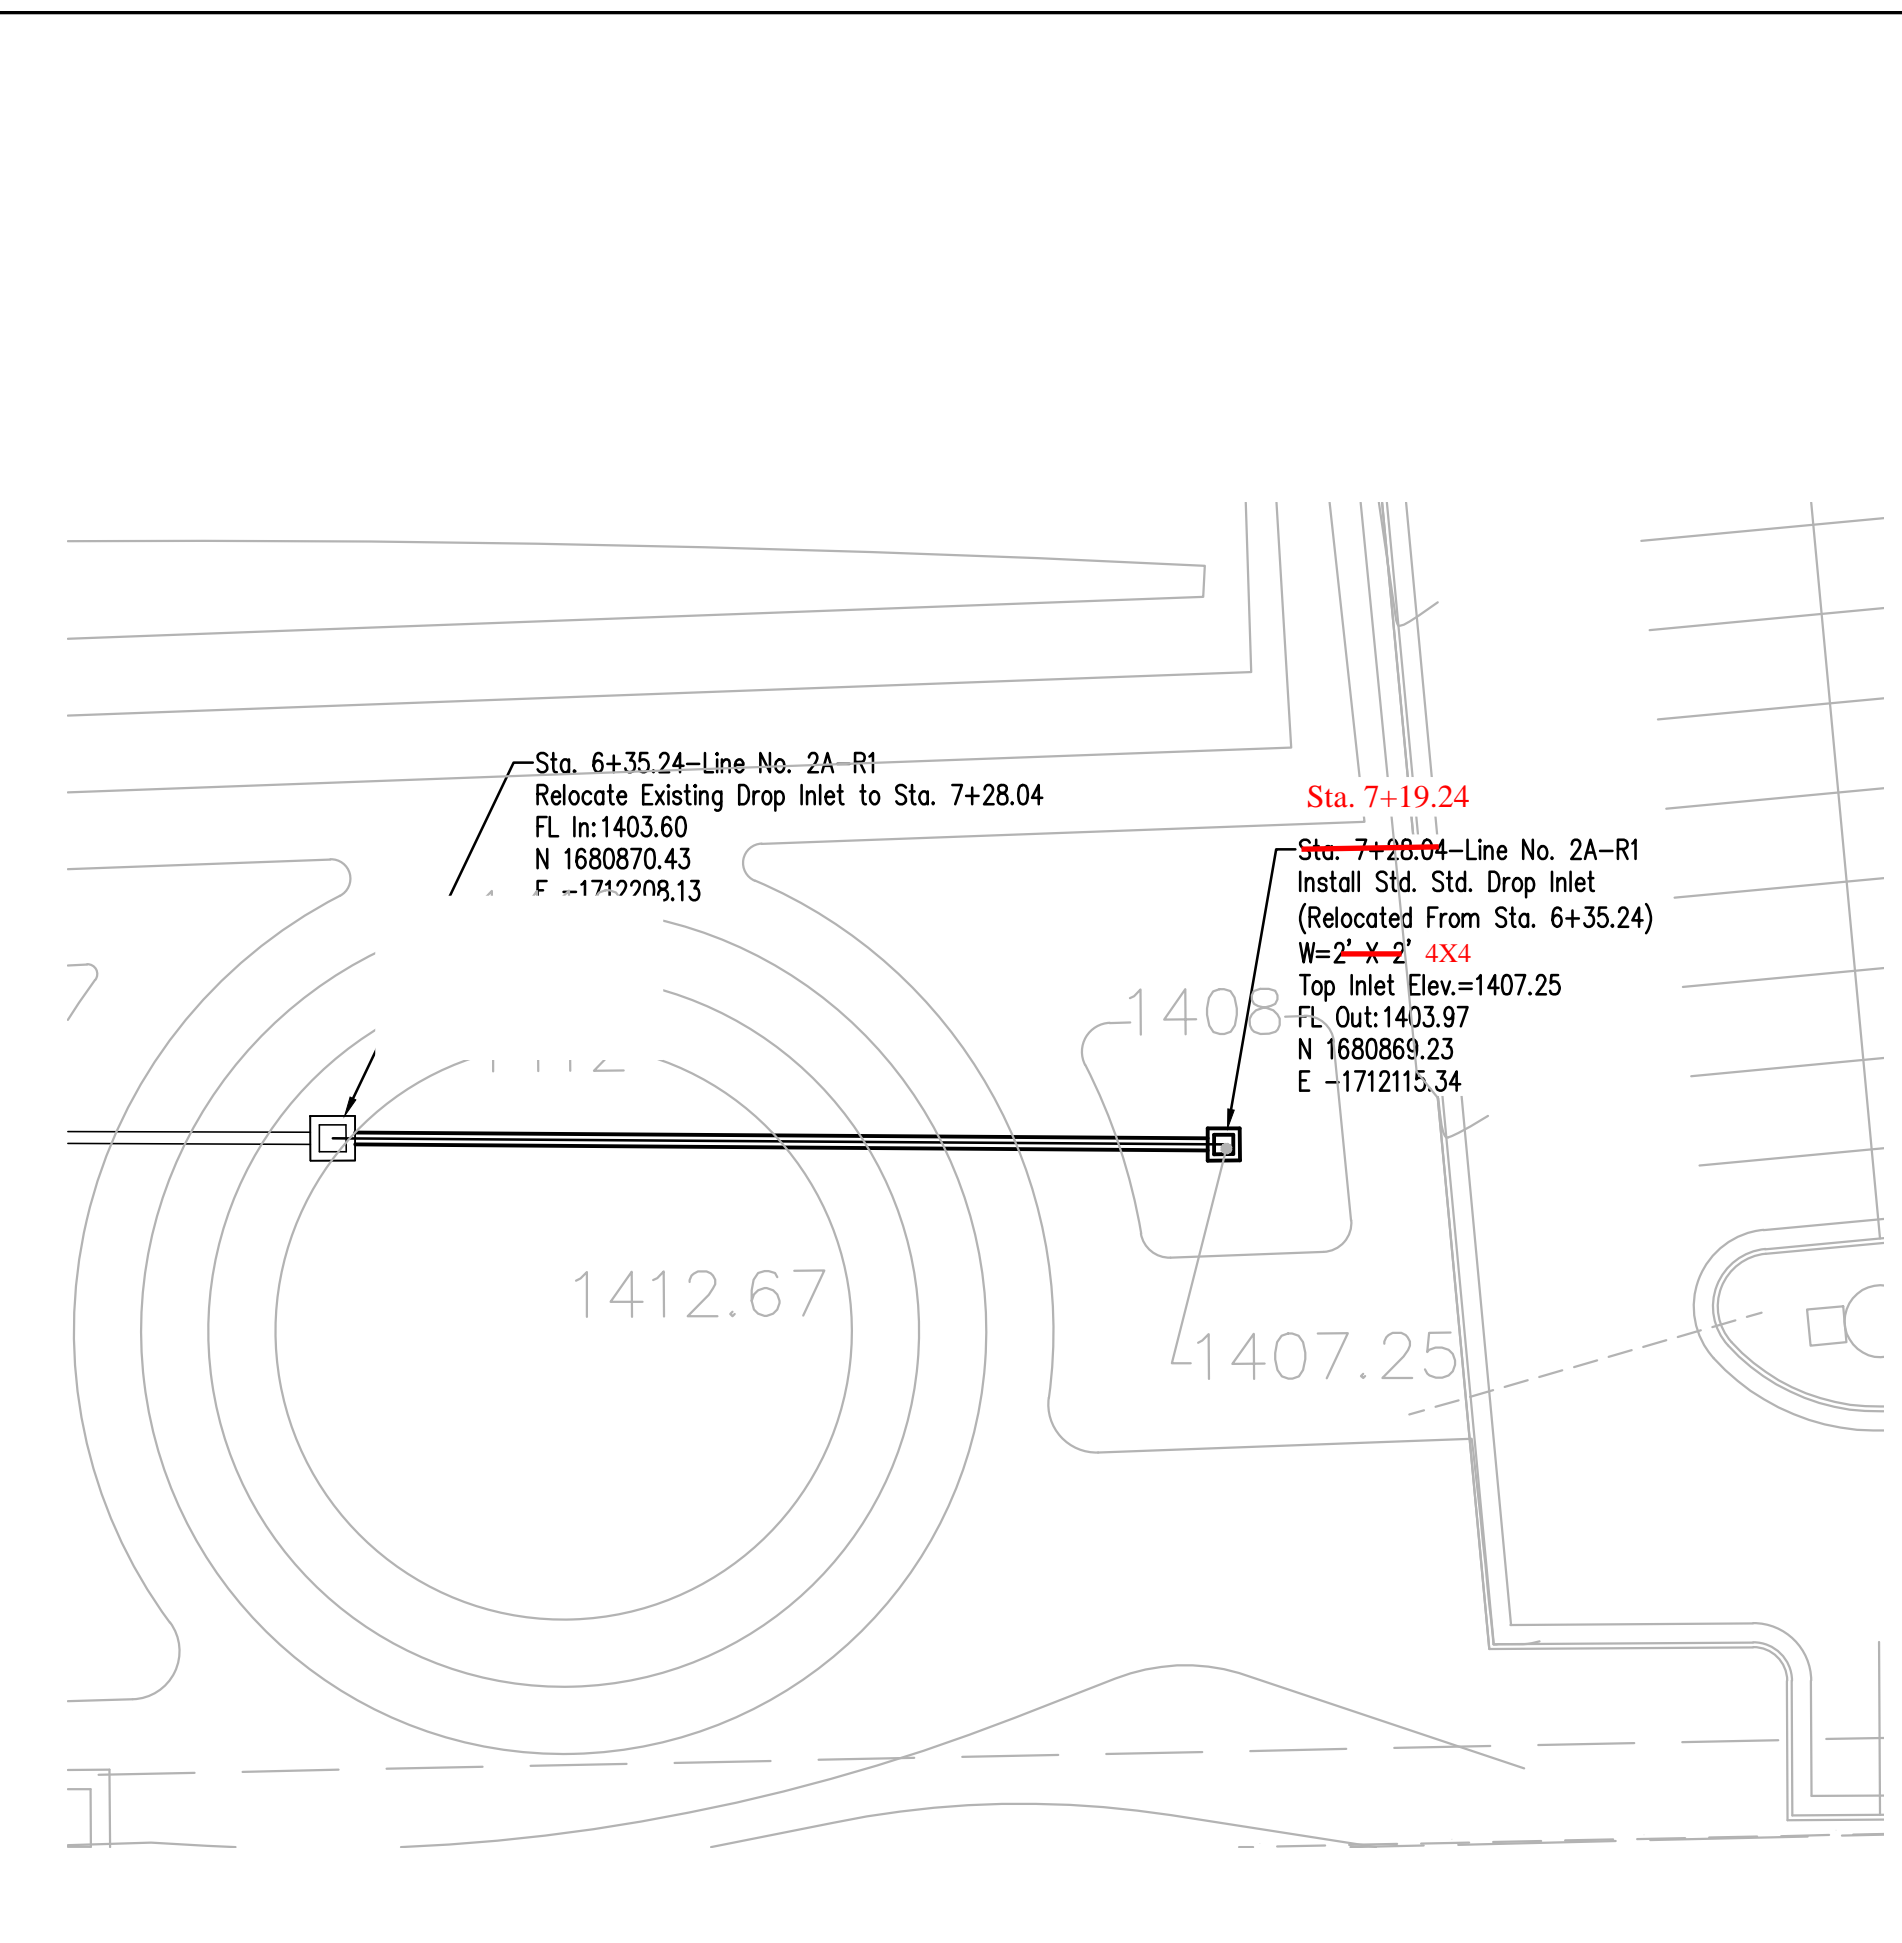


LINE NO. 2-R1

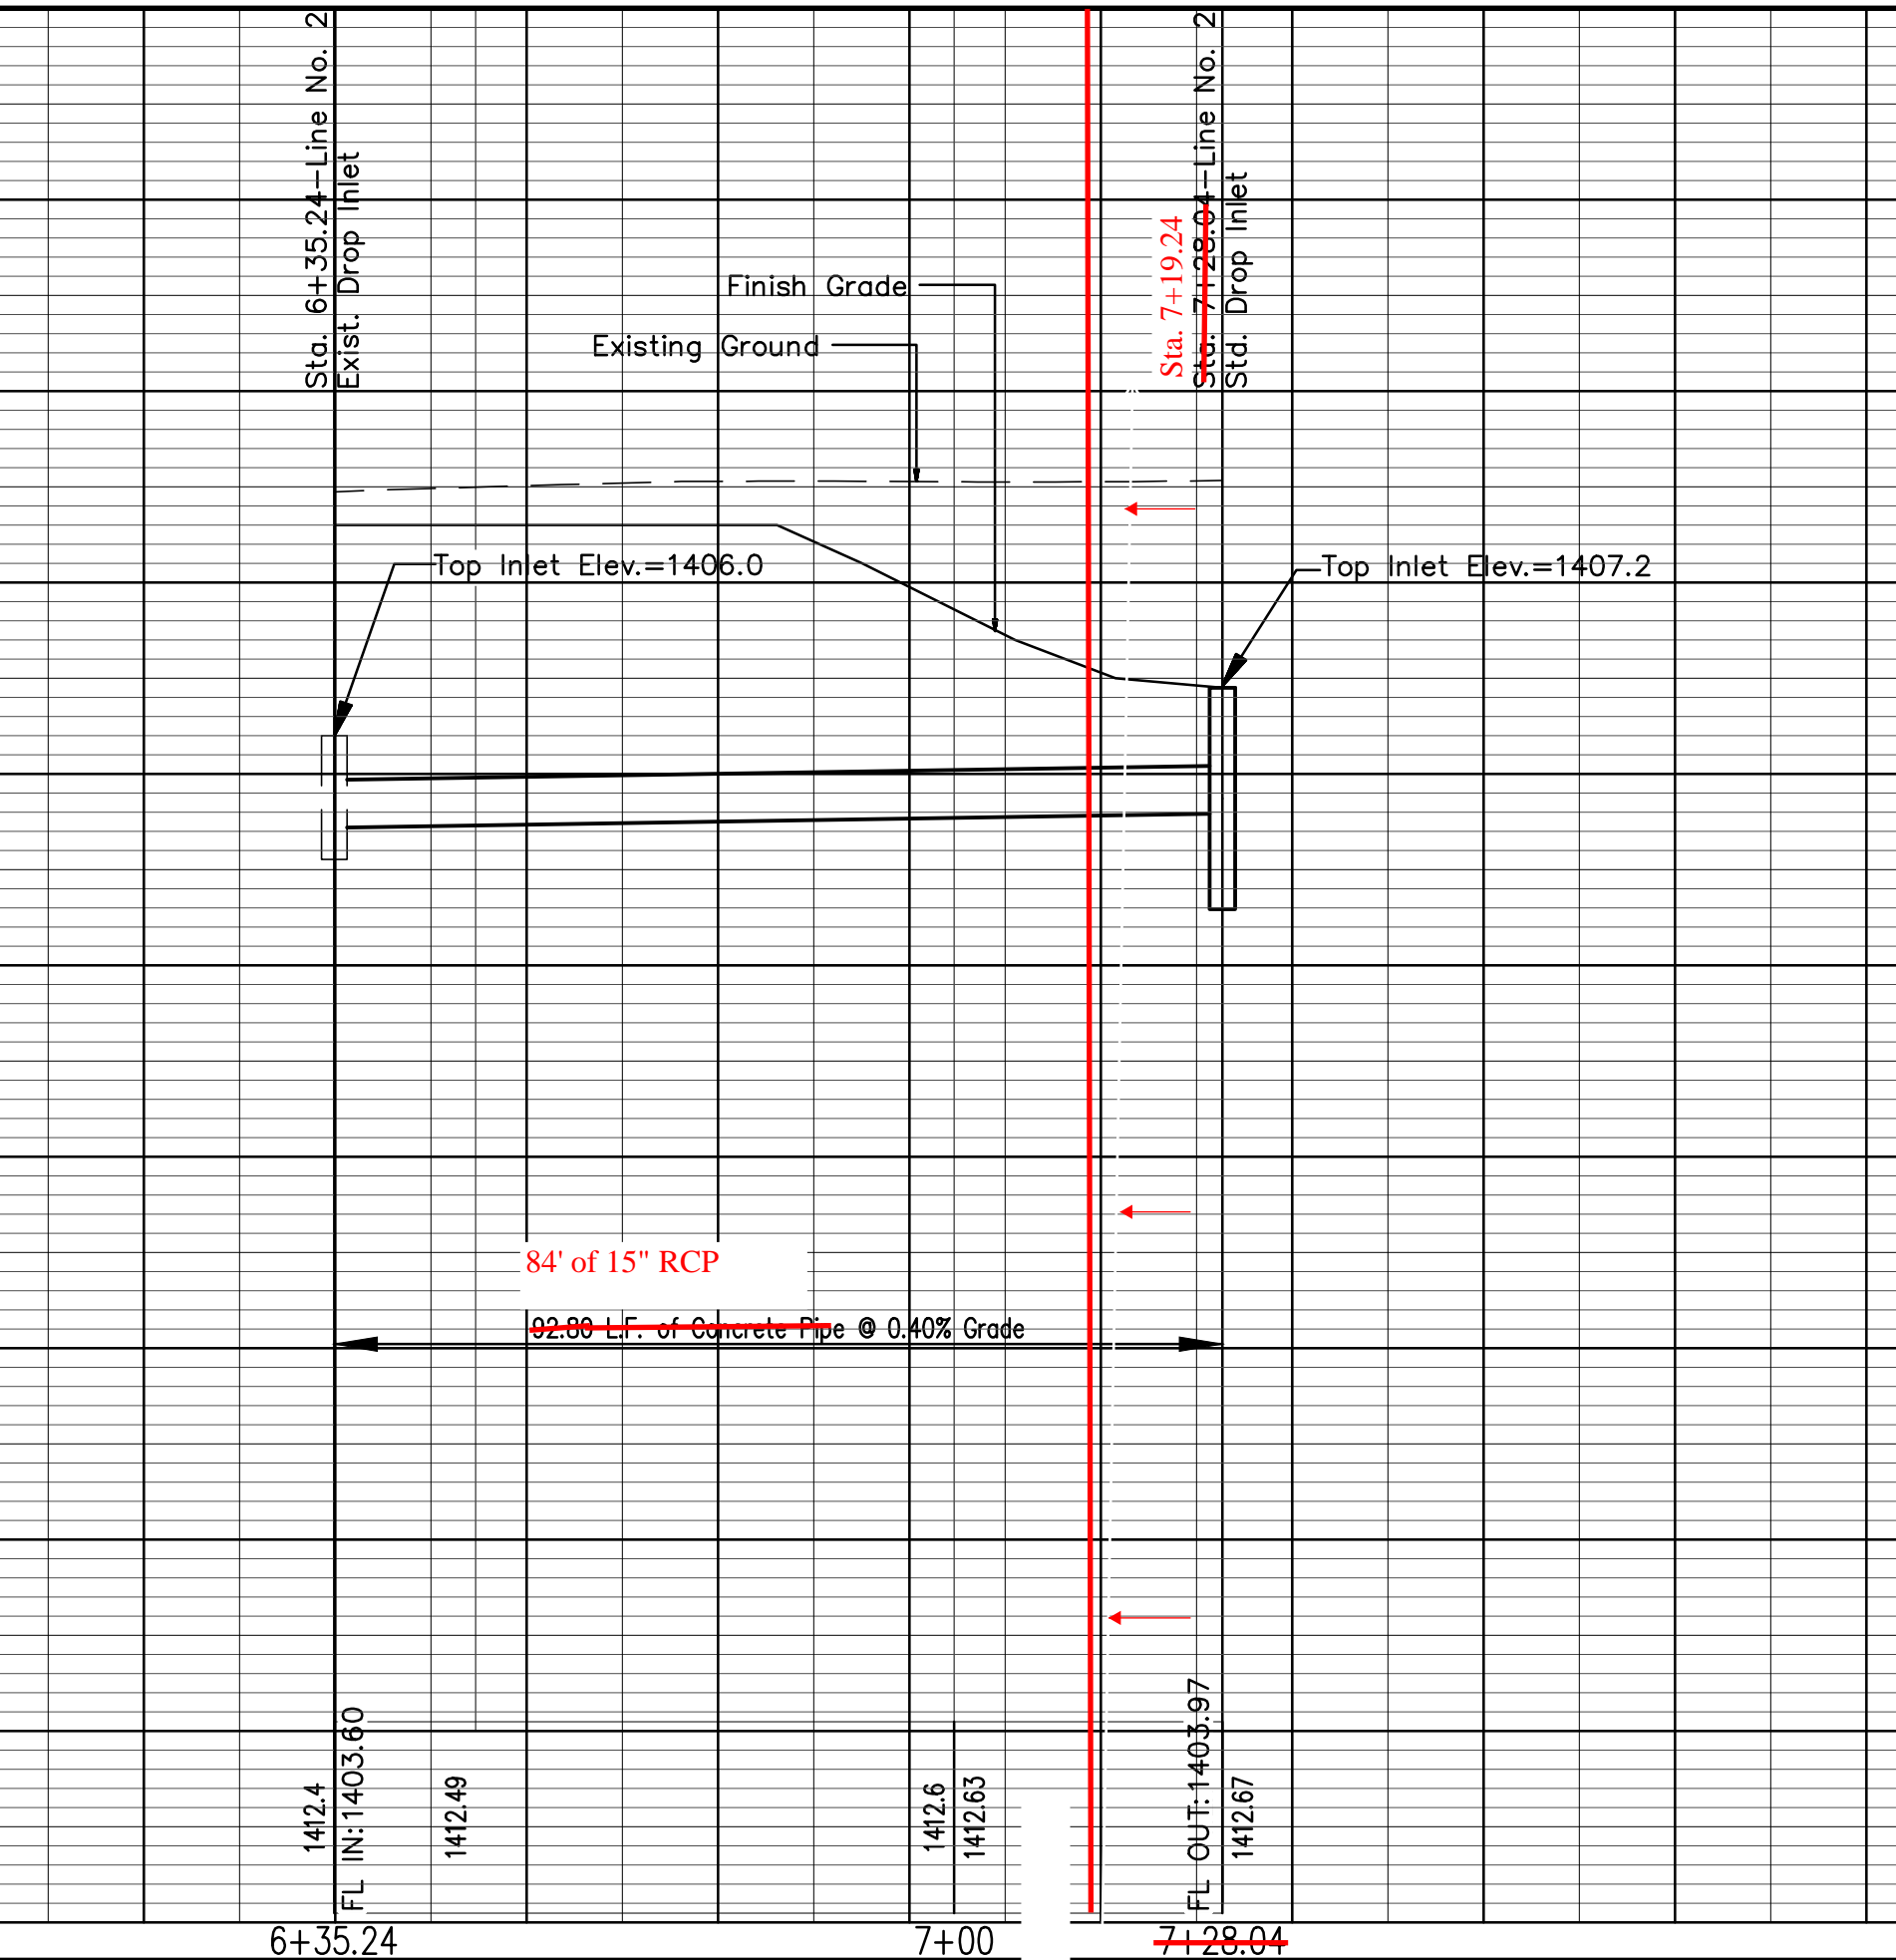

LINE NO. 2A-R1

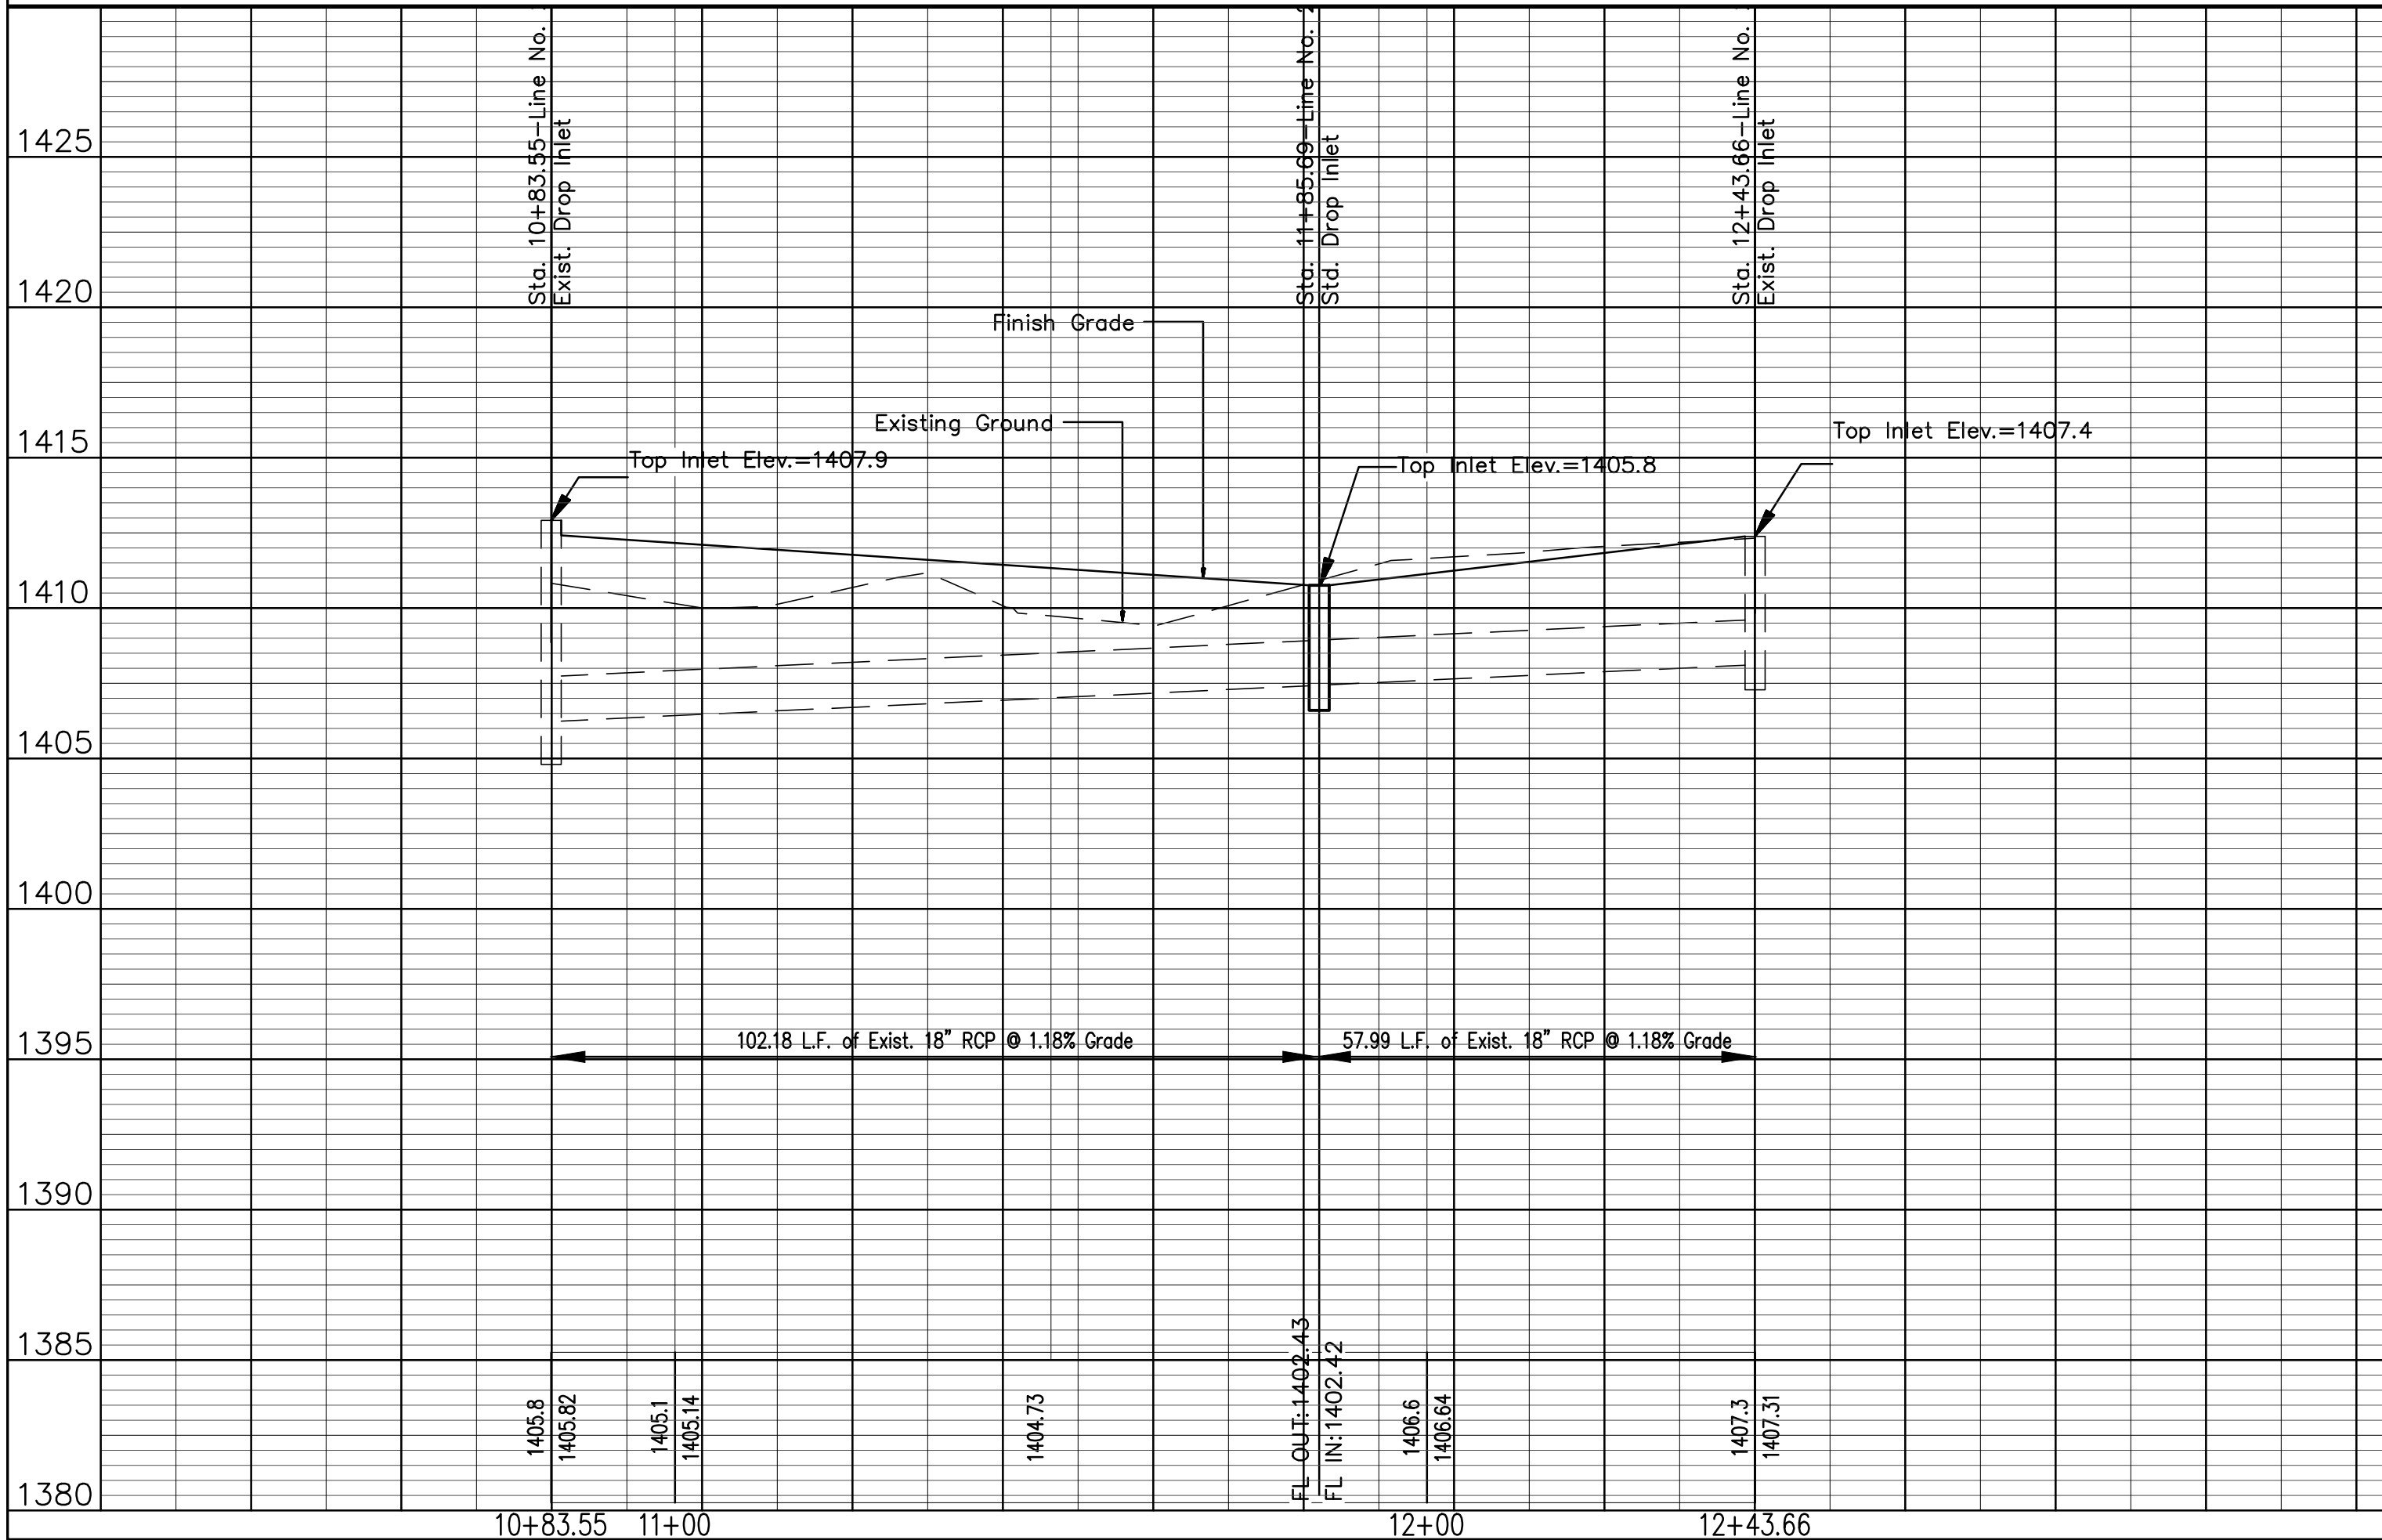

<p>COL. JAGARA AIRPORT-AVIATION CAMPUS STREET &amp; STORM SEWER IMPROVEMENTS STORM SEWER LINE NO. 1 CITY OF WICHITA, KANSAS JAMES L. ARQUIR, P.E. - CITY ENGINEER 1980 PPS (607861)</p>	
No.	Date
By	Approved
SS	TA
05/21/09	
<p>POE &amp; ASSOCIATES, INC. CONSULTING ENGINEERS 5940 E. Central, Suite 200 ■ Wichita, KS 67208-4242 Phone 316/685-4114 ■ FAX 316/685-4444</p>	
<p>REV. 5/21/09</p>	
Designed By:	Tim Austin
Drawn By:	S. Schmidt
Proj. Job No.:	1873
Date:	February 2009
Sheet	3 of 14