
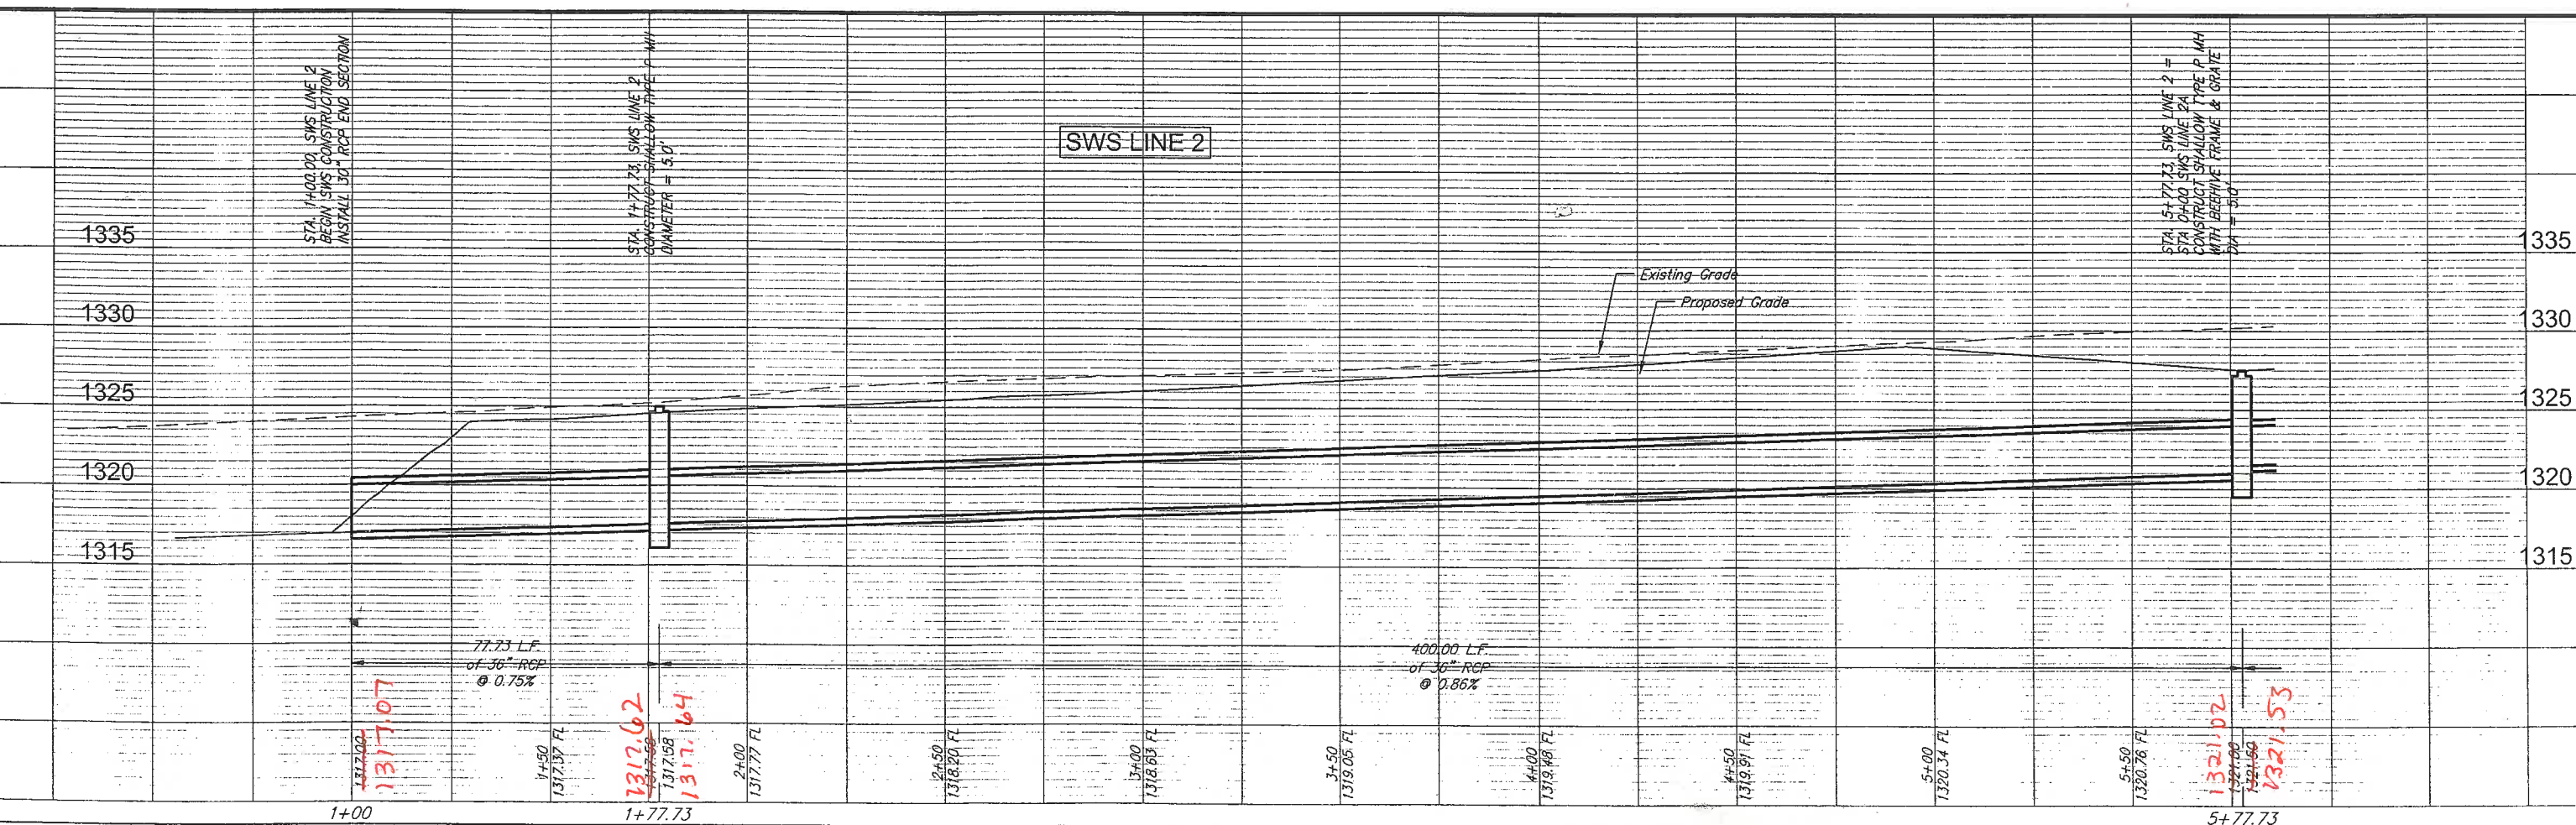
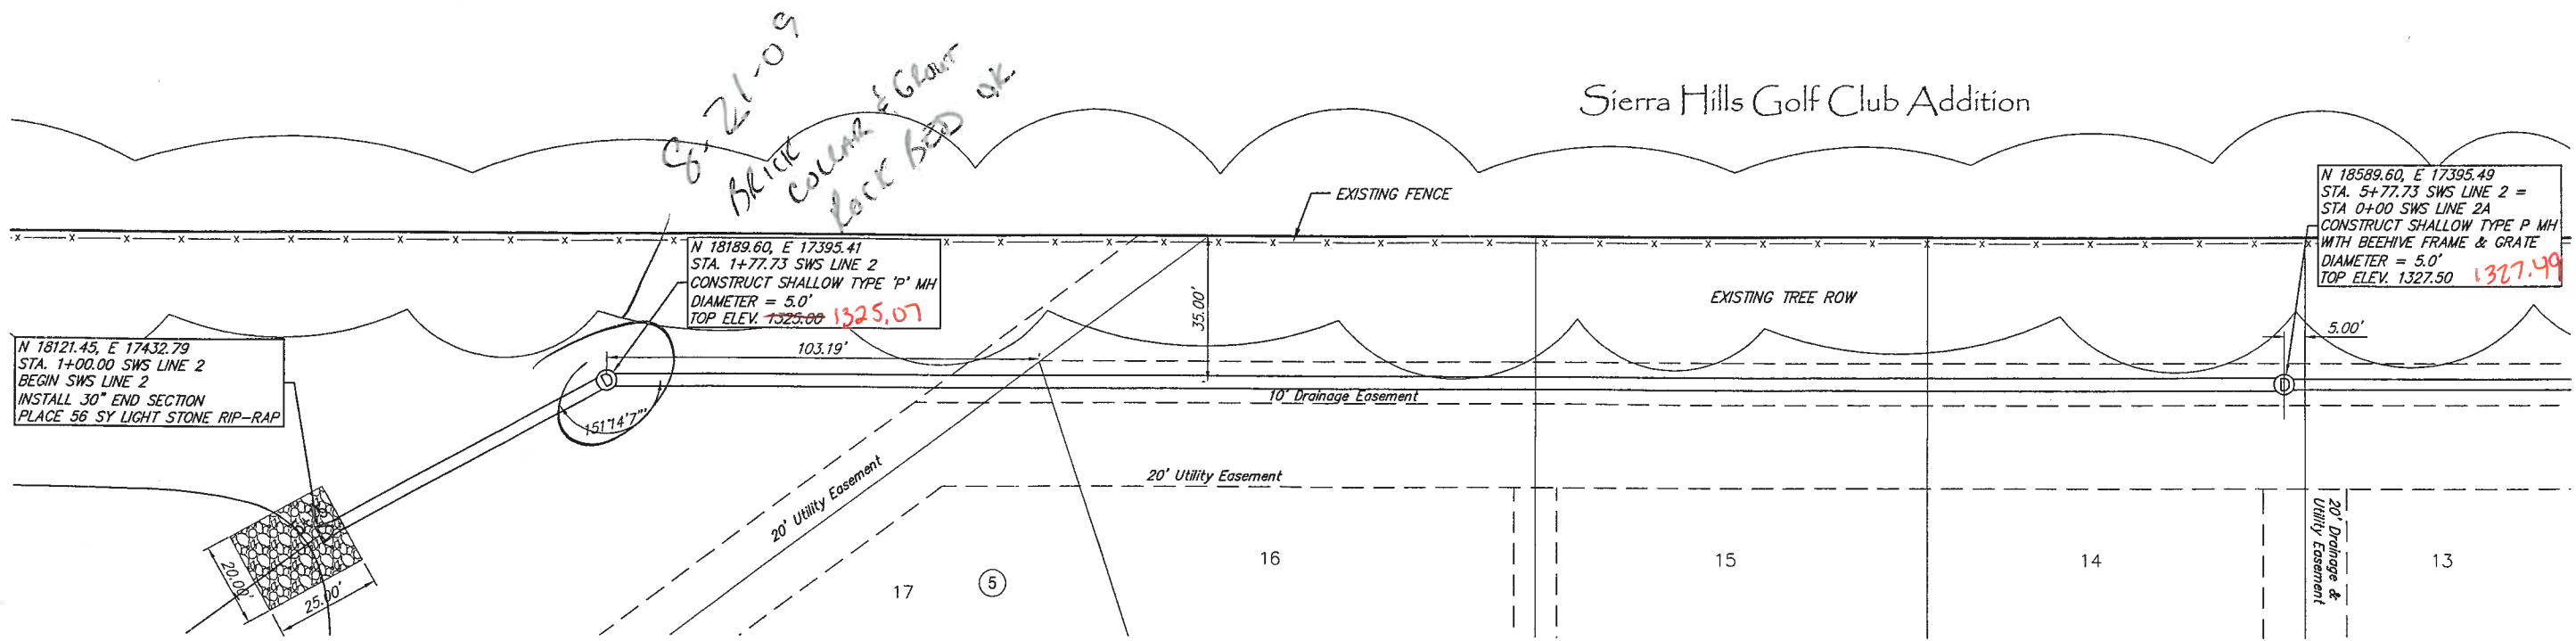


# Sierra Hills Golf Club Addition

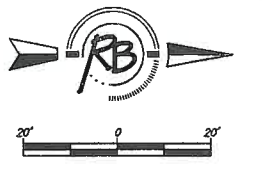

8/21/09  
Black  
column & Glauk  
lock bed ok

N 18121.45, E 17432.79  
STA. 1+00.00 SWS LINE 2  
BEGIN SWS LINE 2  
INSTALL 30" END SECTION  
PLACE 56 SY LIGHT STONE RIP-RAP

N 18189.60, E 17395.41  
STA. 1+77.73 SWS LINE 2  
CONSTRUCT SHALLOW TYPE P MH  
DIAMETER = 5.0'  
TOP ELEV. 1325.07

N 18589.60, E 17395.49  
STA. 5+77.73 SWS LINE 2 =  
STA. 0+00 SWS LINE 2A  
CONSTRUCT SHALLOW TYPE P MH  
WITH BEEHIVE FRAME & GRATE  
DIAMETER = 5.0'  
TOP ELEV. 1327.49

Ruggles & Bohm, P.A.  
Engineering, Surveying, Land Planning  

PROJECT NUMBER	187995
DESIGN	E.G.
DRAWN	E.G.
REVIEWED	
DATE	Apr 30, 2009
REVISION	

SIERRA HILLS 2ND ADDITION  
SWS Line 2  
WICHITA, KANSAS