



MOVED 2' S.
8-26-09 OK BY
SET MH RCM LCE

Sierra Hills Golf Club Addition

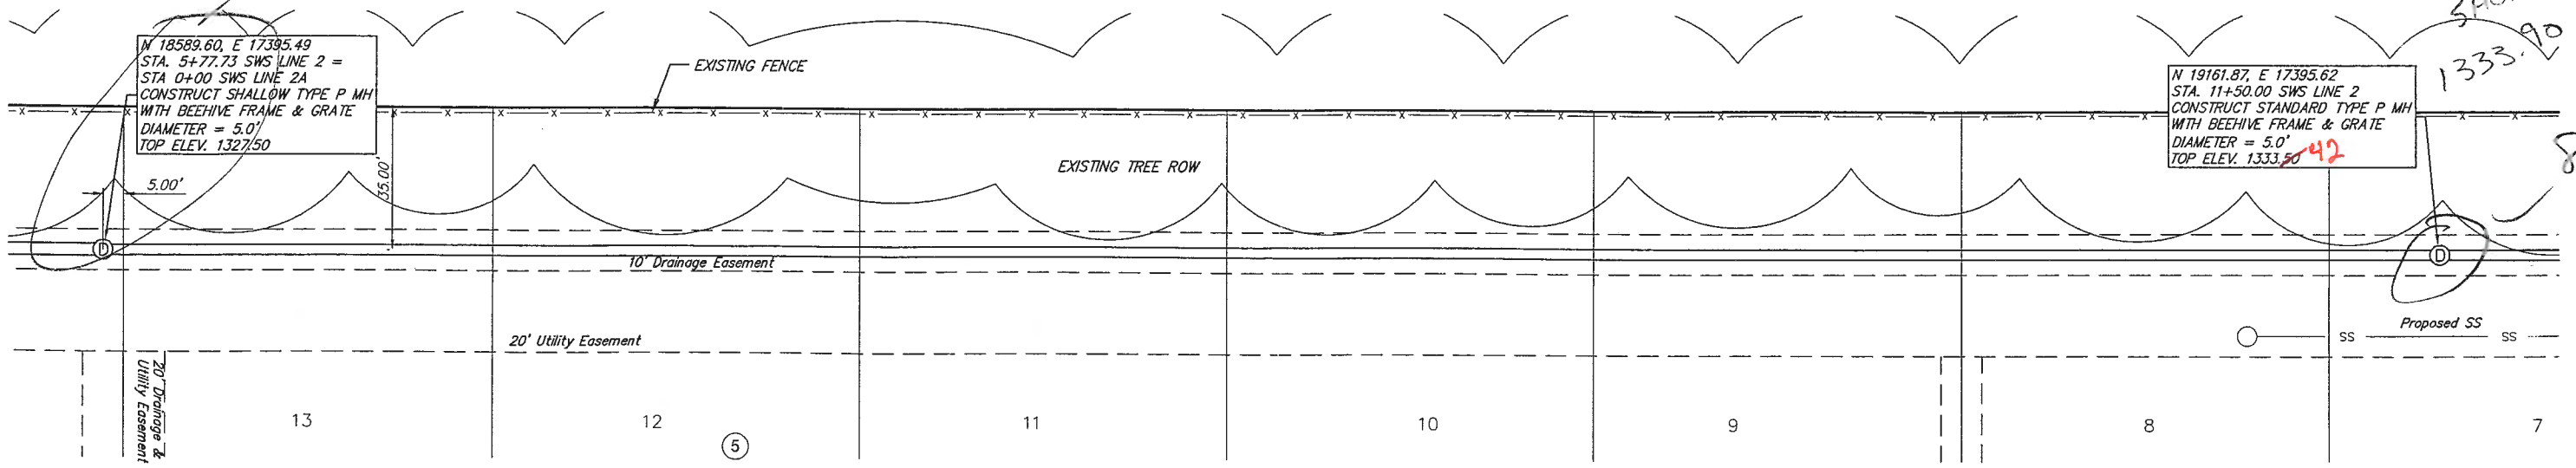

SHOT
1333.90
SET
8-31-09

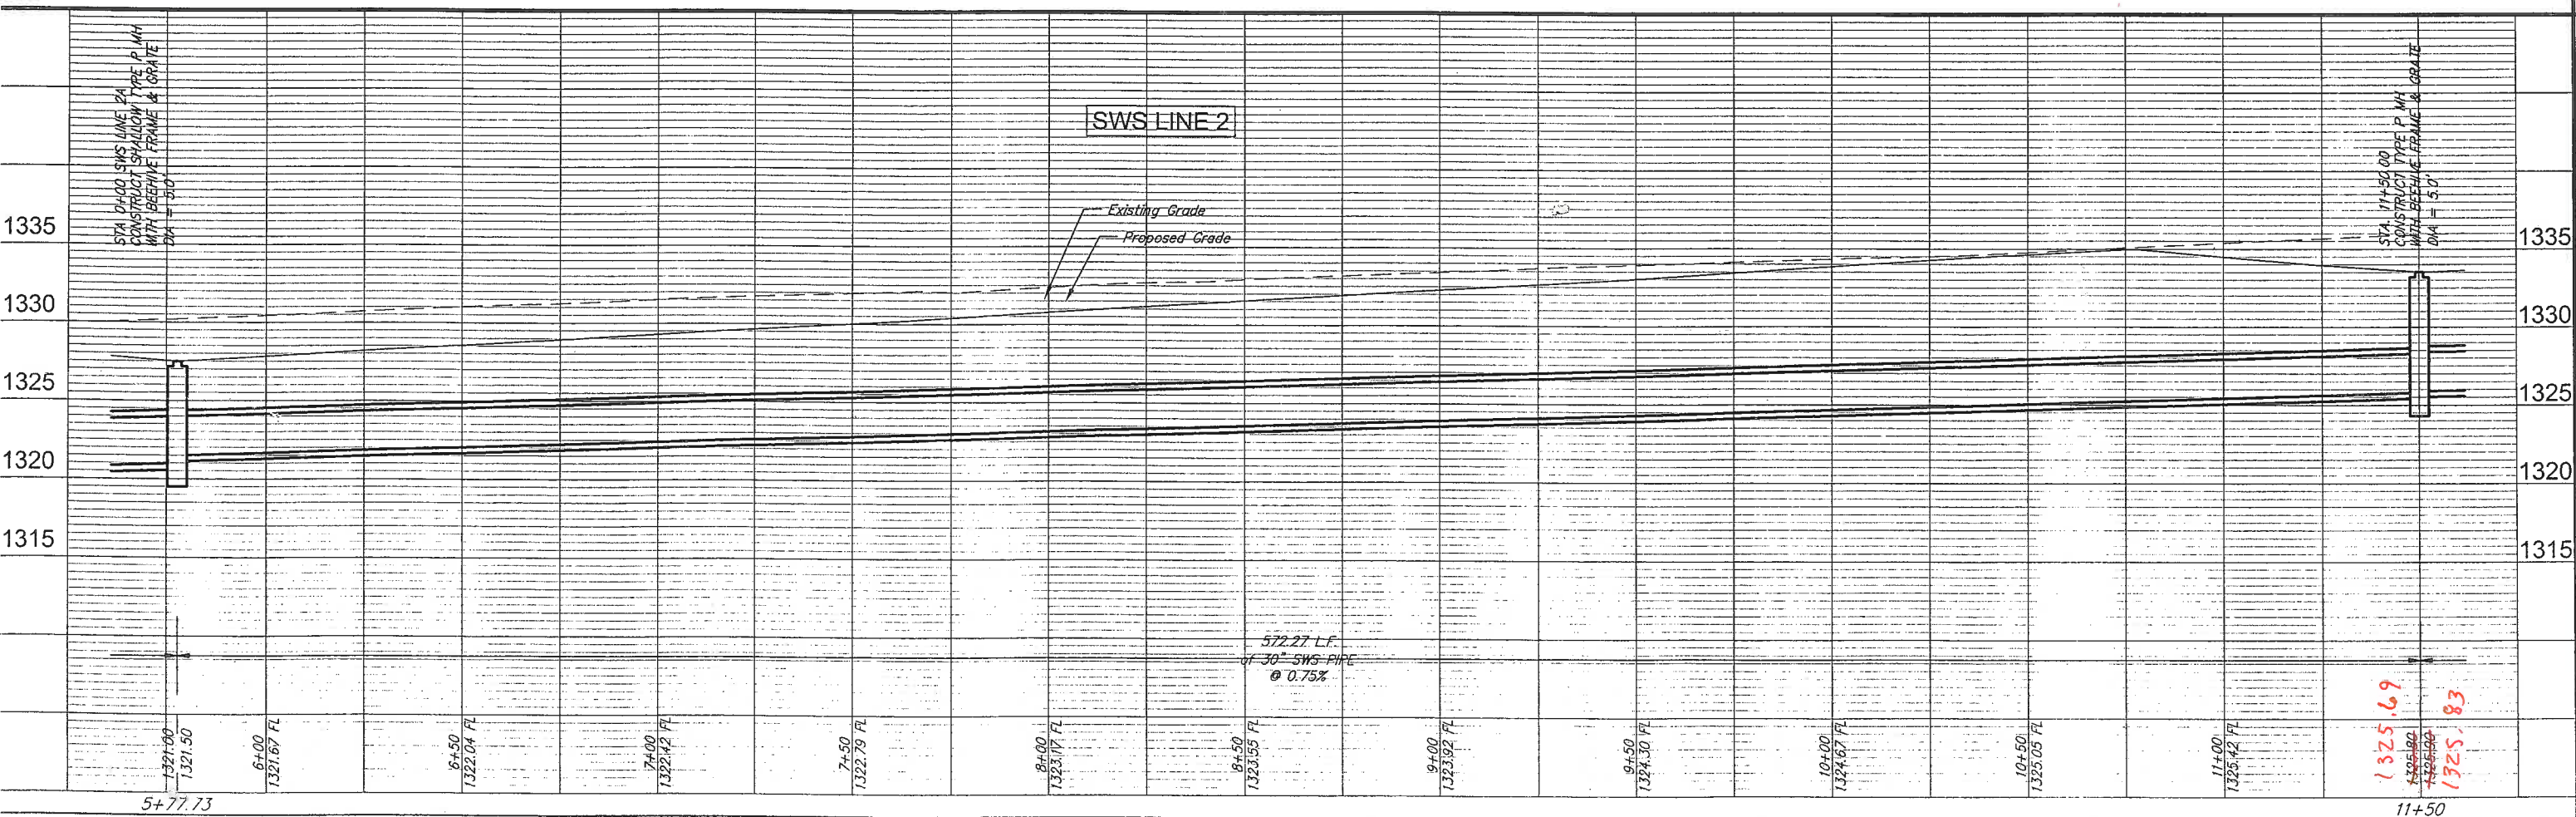

Ruggles & Bohm, P.A.
 Engineering, Surveying, Land Planning
 919 West Main Street
 Wichita, Kansas 67202
 www.rugglesandbohm.com

PROJECT NUMBER: 1923P5
 DRAWING FILE: Engineering Base (SWS Line 2 (2))

DESIGNED: EAG
 DRAWN: EAG
 CHECKED: EAG
 REVISION: REVIEW
 DATE: Apr 30, 2009

SIERRA HILLS 2ND ADDITION
 SWS Line 2 (2)
 WICHITA, KANSAS

SHEET: 9
 OF: 23