
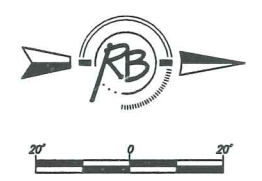


Sierra Hills Addition

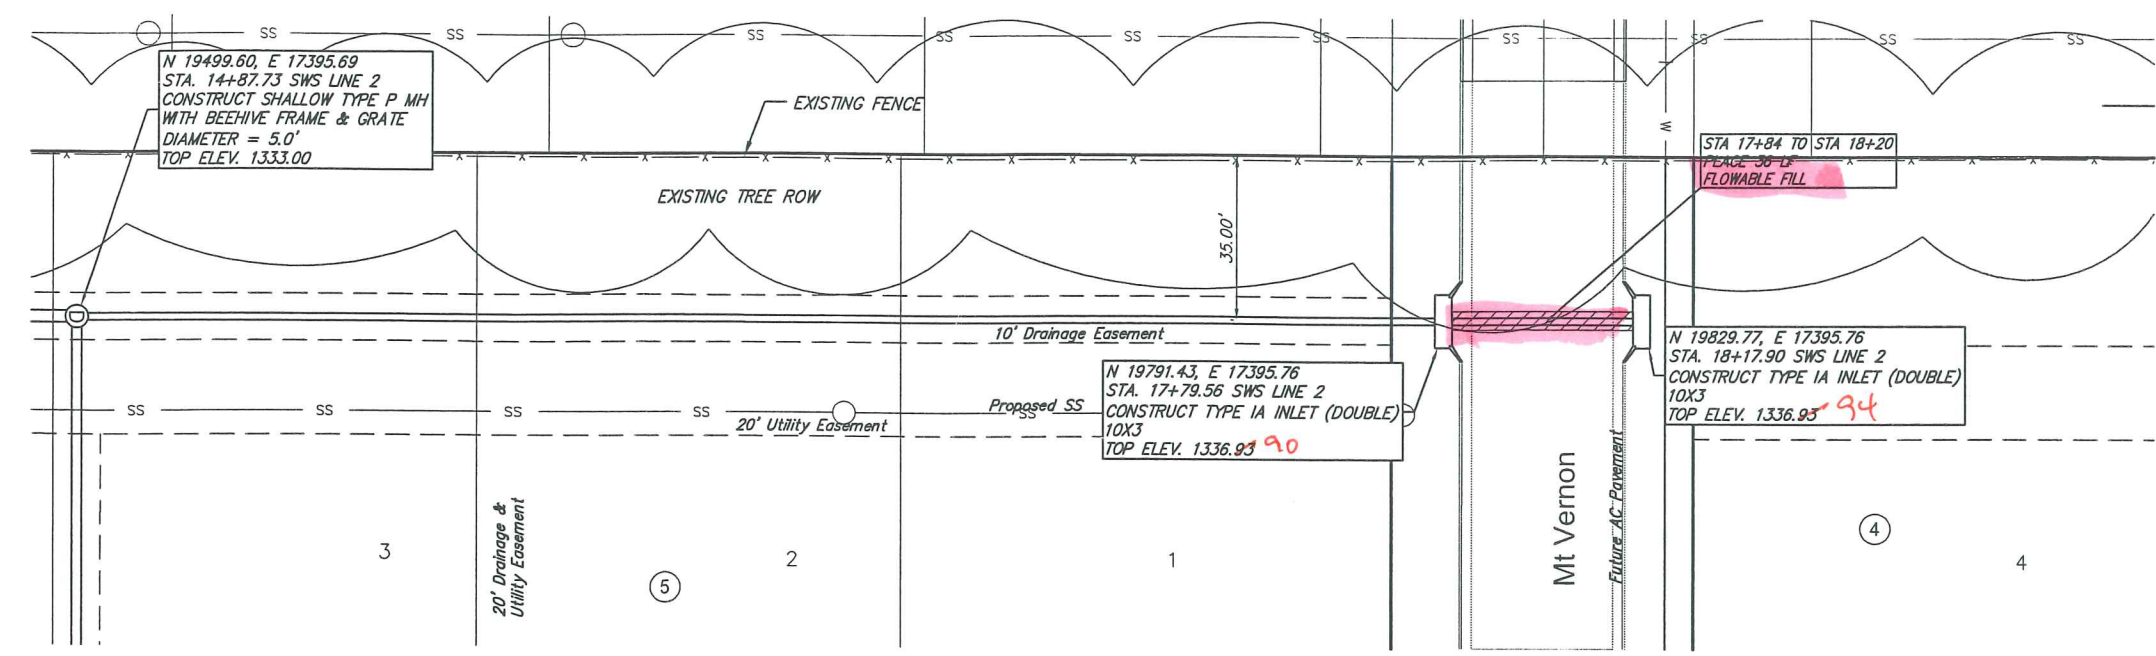

Ruggles & Bohm, P.A.
 Engineering, Surveying, Land Planning
 1010 North Main Street
 Wichita, Kansas 67202
 www.rugglesandbohm.com

| | |
|----------------|-----------------------------------|
| PROJECT NUMBER | 197295 |
| DRAWING FILE | Engineering Base [SWS Line 2 (4)] |
| DESIGN | EAG |
| DRAWN | EAG |
| REVISION | REVIEW |
| DATE | DATE |
| UTILITY | UTILITY |
| APR 30, 2009 | APR 30, 2009 |

SIERRA HILLS 2ND ADDITION
 SWS Line 2 (4)
 WICHITA, KANSAS

RB JOB
 3268E
 SHEET
 11
 OF
 23

