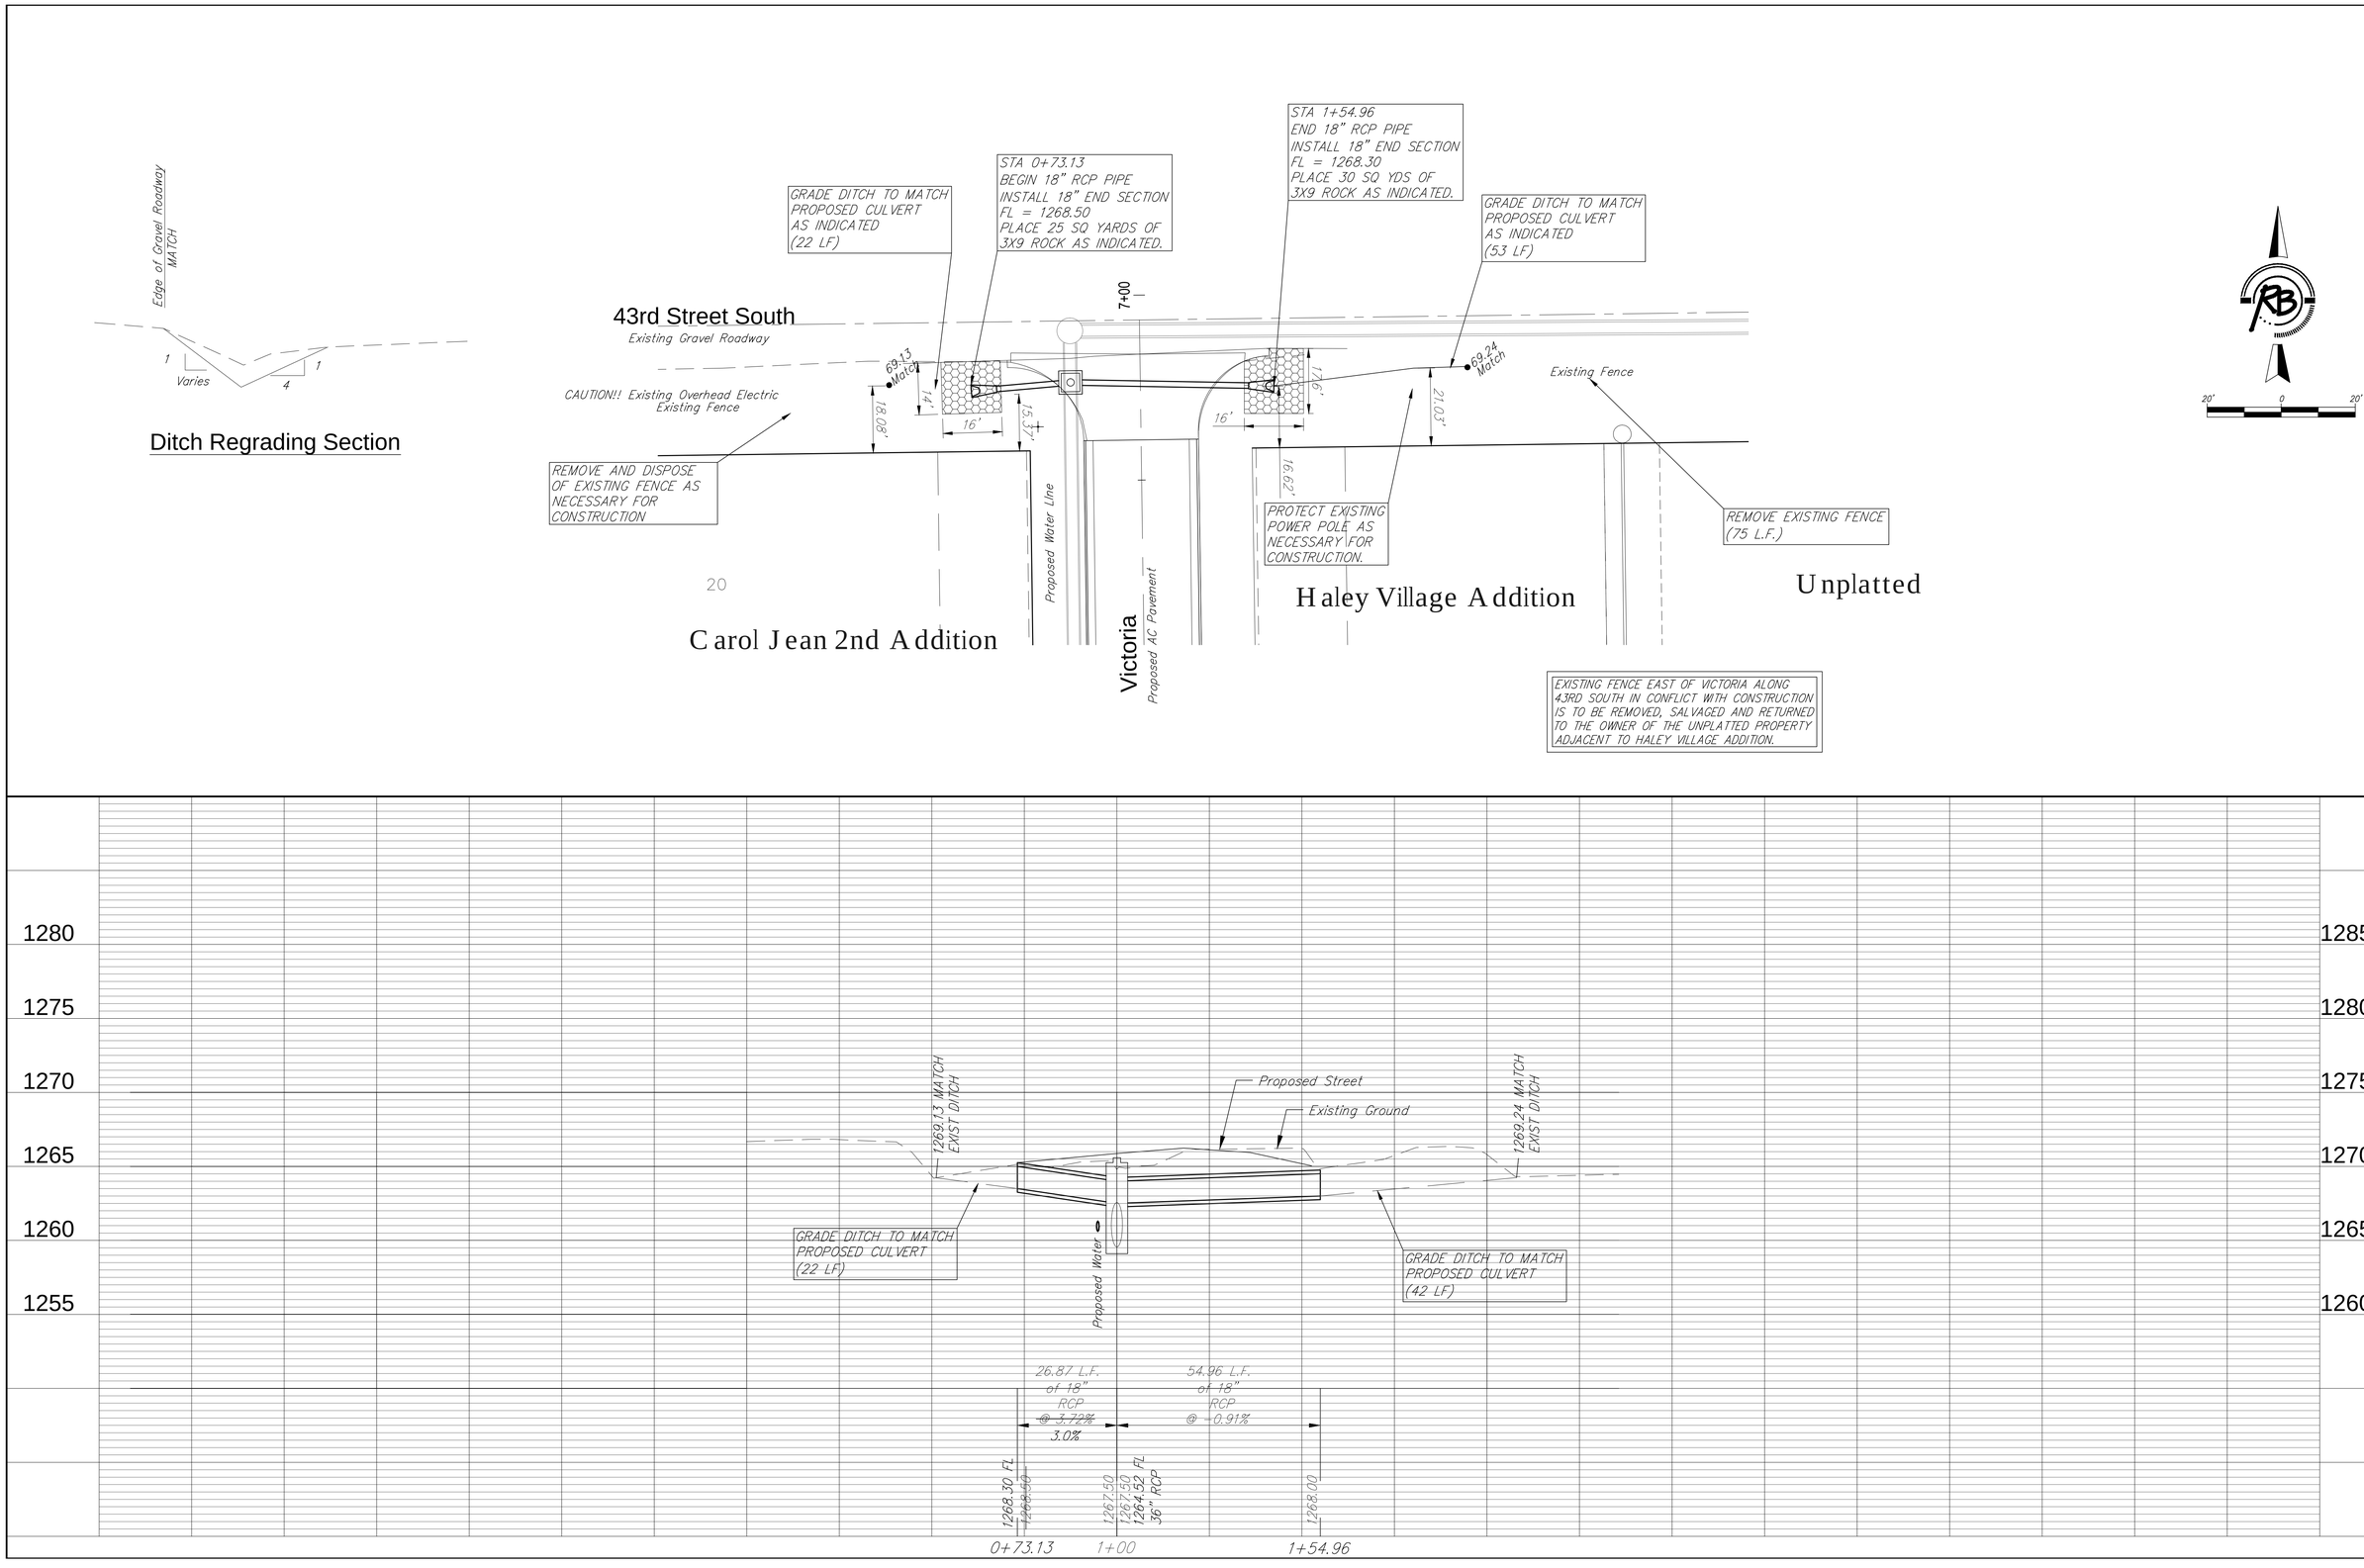

Ruggles & Bohm, P.A.
Engineering, Surveying, Land Planning
924 North Main
Wichita, Kansas 67203
(316) 264-8008
(316) 264-4621 fax
E-mail: info@rbkansas.com
www.rbkansas.com

DESIGN EJG
DRAWN EJG
REVISED Jan 25, 2009
UTILITY
DATE Sept. 2, 2009
REVIEW

PROJECT NUMBER
DRAWING FILE Engineering Base {SWS Line 4}

Carol Jean 2nd/Hobbs Village Addition
Storm Sewer Line 4
WICHITA, KANSAS

RB JOB 3311E

SHEET 12 OF 25