
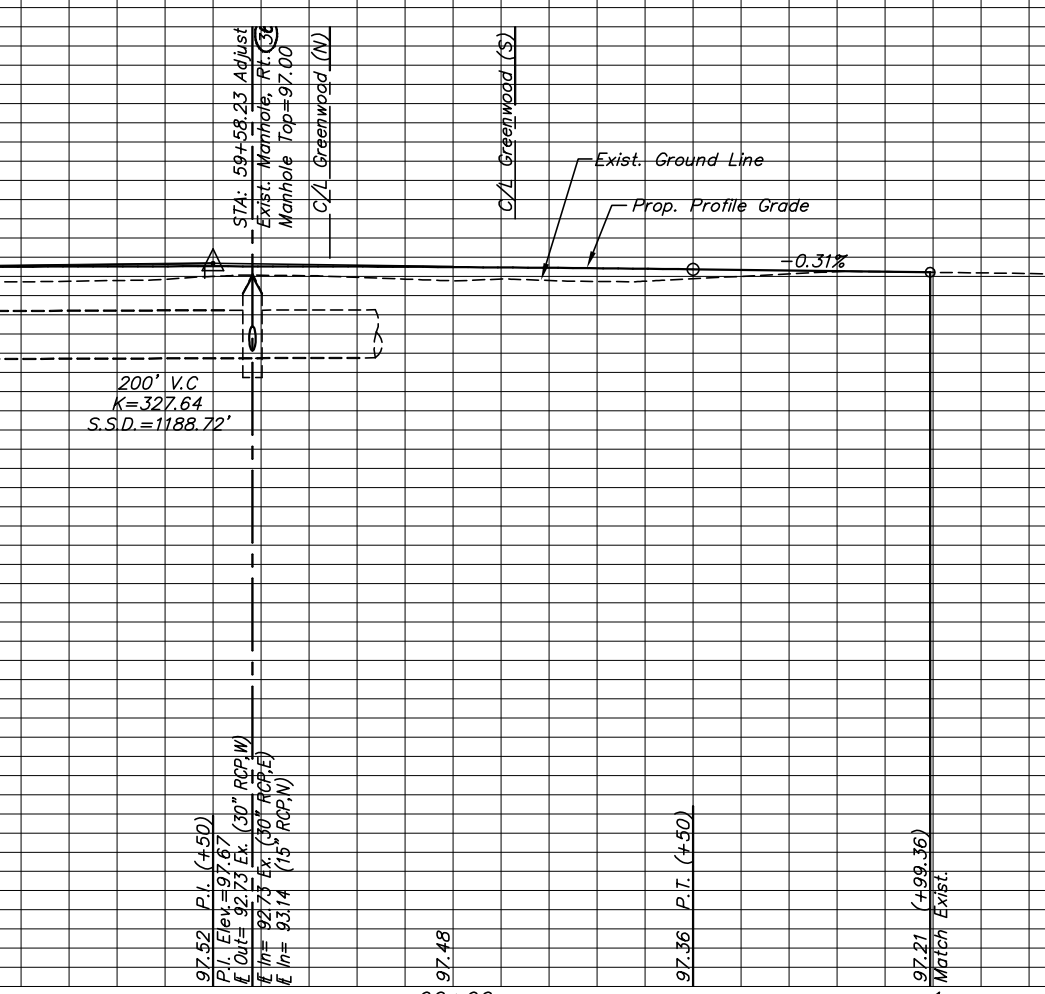


STATE	PROJECT NO.	YEAR	SHEET NO.	SHEETS
KANSAS	87 N-0235-01	2006	16	120

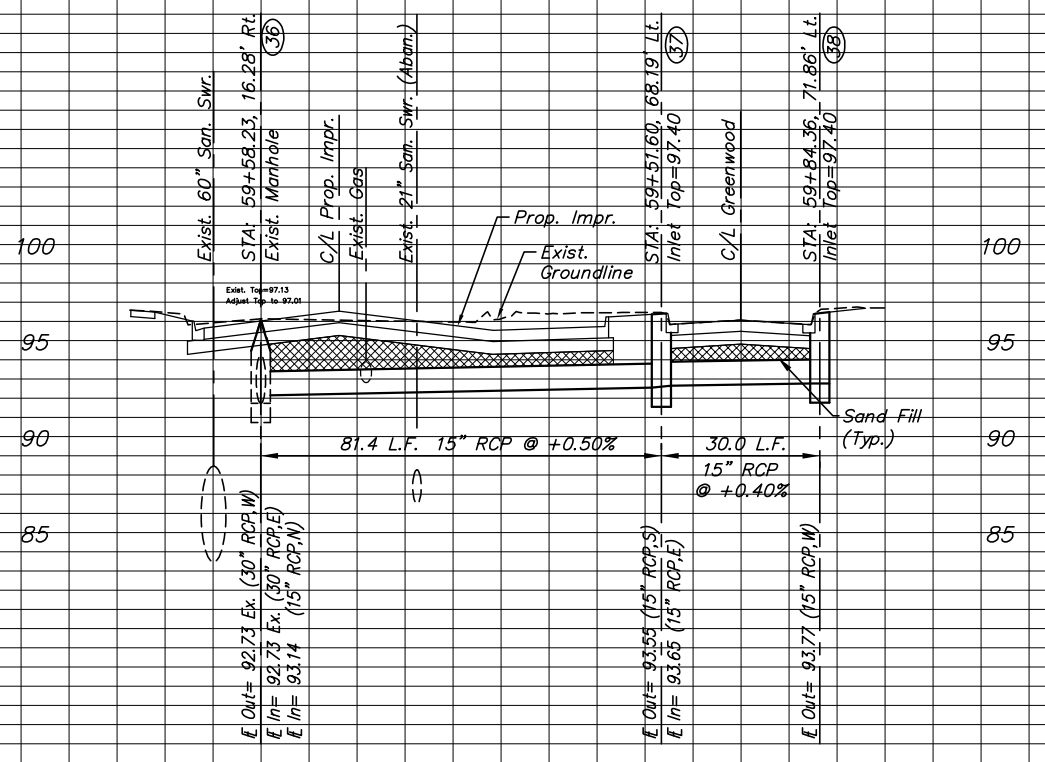

J:\Civil\04222\dwg\prof\04222pr06.dwg 6/14/2006 2:18:51 PM CST

97.48

97.52 P.I. (+50)
 P.I. Elev.=97.67
 E. Out.=92.73 Ex. (30" RCP,W)
 E. In.=92.73 Ex. (30" RCP,E)
 E. In.=93.14 (15" RCP,N)

97.48

97.36 P.T. (+50)

97.21 (+99.36)
 Match Exist.

KANSAS DEPARTMENT OF TRANSPORTATION

PAWNEE IMPROVEMENTS
 STA. 59+00 TO STA. 62+50

PROJECT NO. 87 N-0235-01 SEDGWICK CO.

M K E C ENGINEERING CONSULTANTS, INC.
 WICHITA, KANSAS

DESIGNED BY: JRA	CHECKED BY: JRA
DRAWN BY: WNJ	DATE: JULY 2004 SHEET 16 OF 120