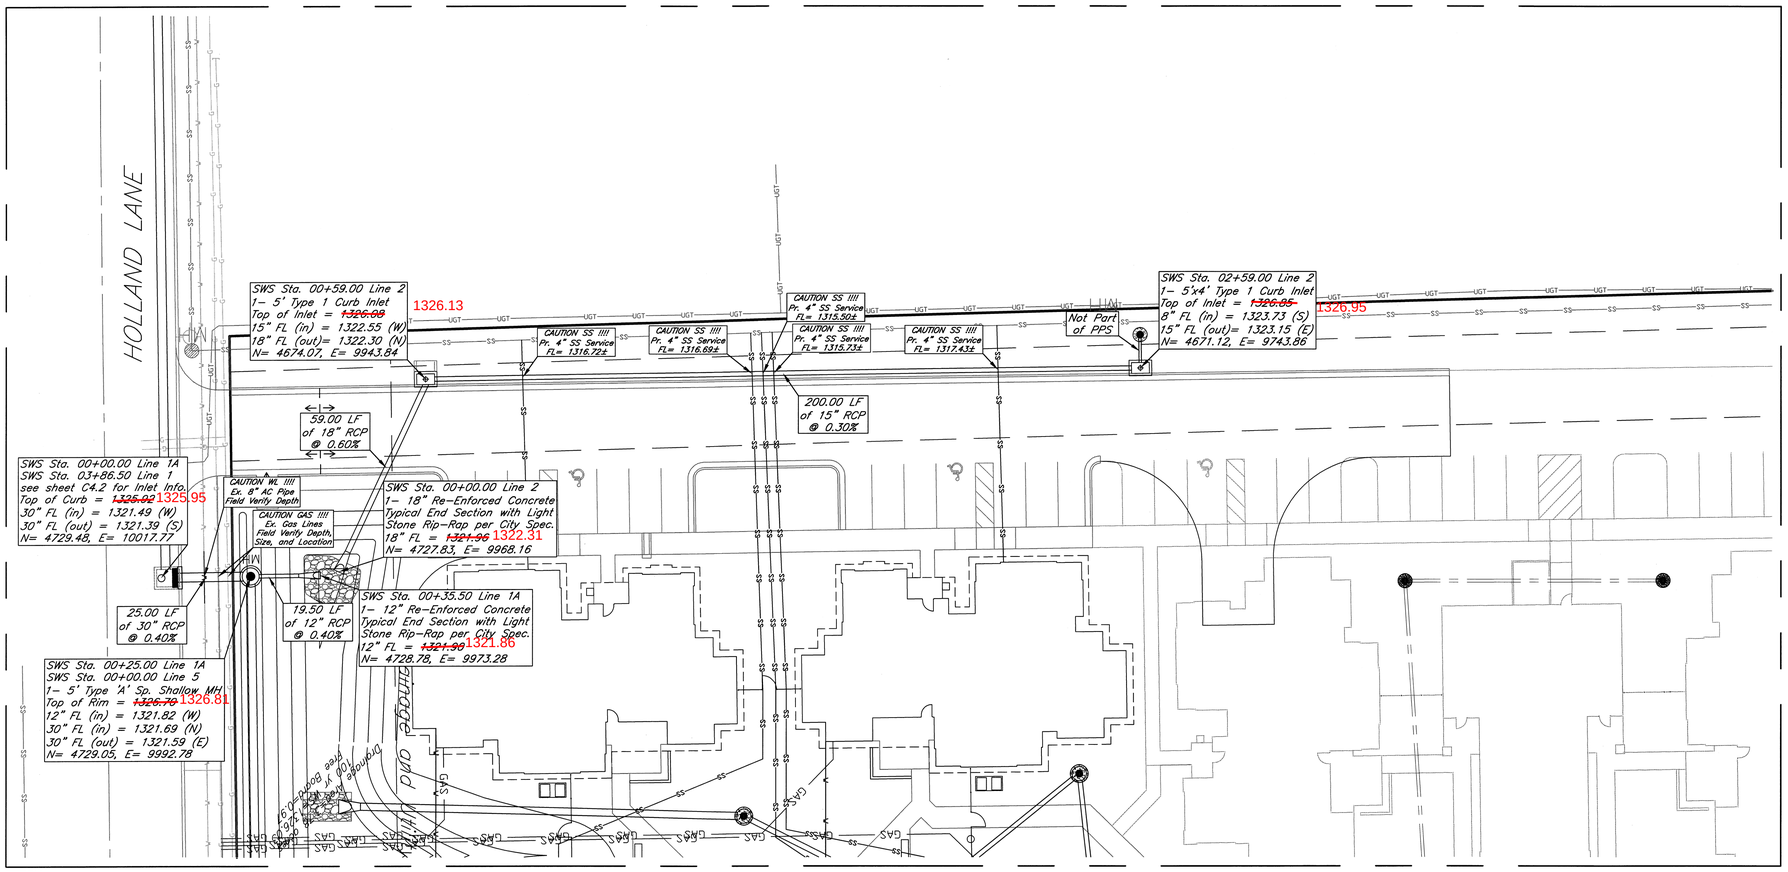

DATE DRAWN
01-11-2010
REVISIONS

PRINTS ISSUED
CITY PERMIT 12-08-09

KREHBIEL ARCHITECTURE

1300 E. Lewis
Wichita KS 67211
316.267.8233
316.267.8566 fax
krehbielarchitecture.com

DATE

BETHEL HOUSE RESIDENT ACTIVITY CENTER

553 S. HOLLAND LANE
WICHITA, KANSAS

PROJECT NO.
9047

SHEET TITLE
Plan & Profile (Lines 1A,2)

SHEET NO.
C4.3

kemiller engineering
516 S. Market,
Wichita, KS 67202
(316)264-0242

© Copyright 2009 Krehbiel Architecture