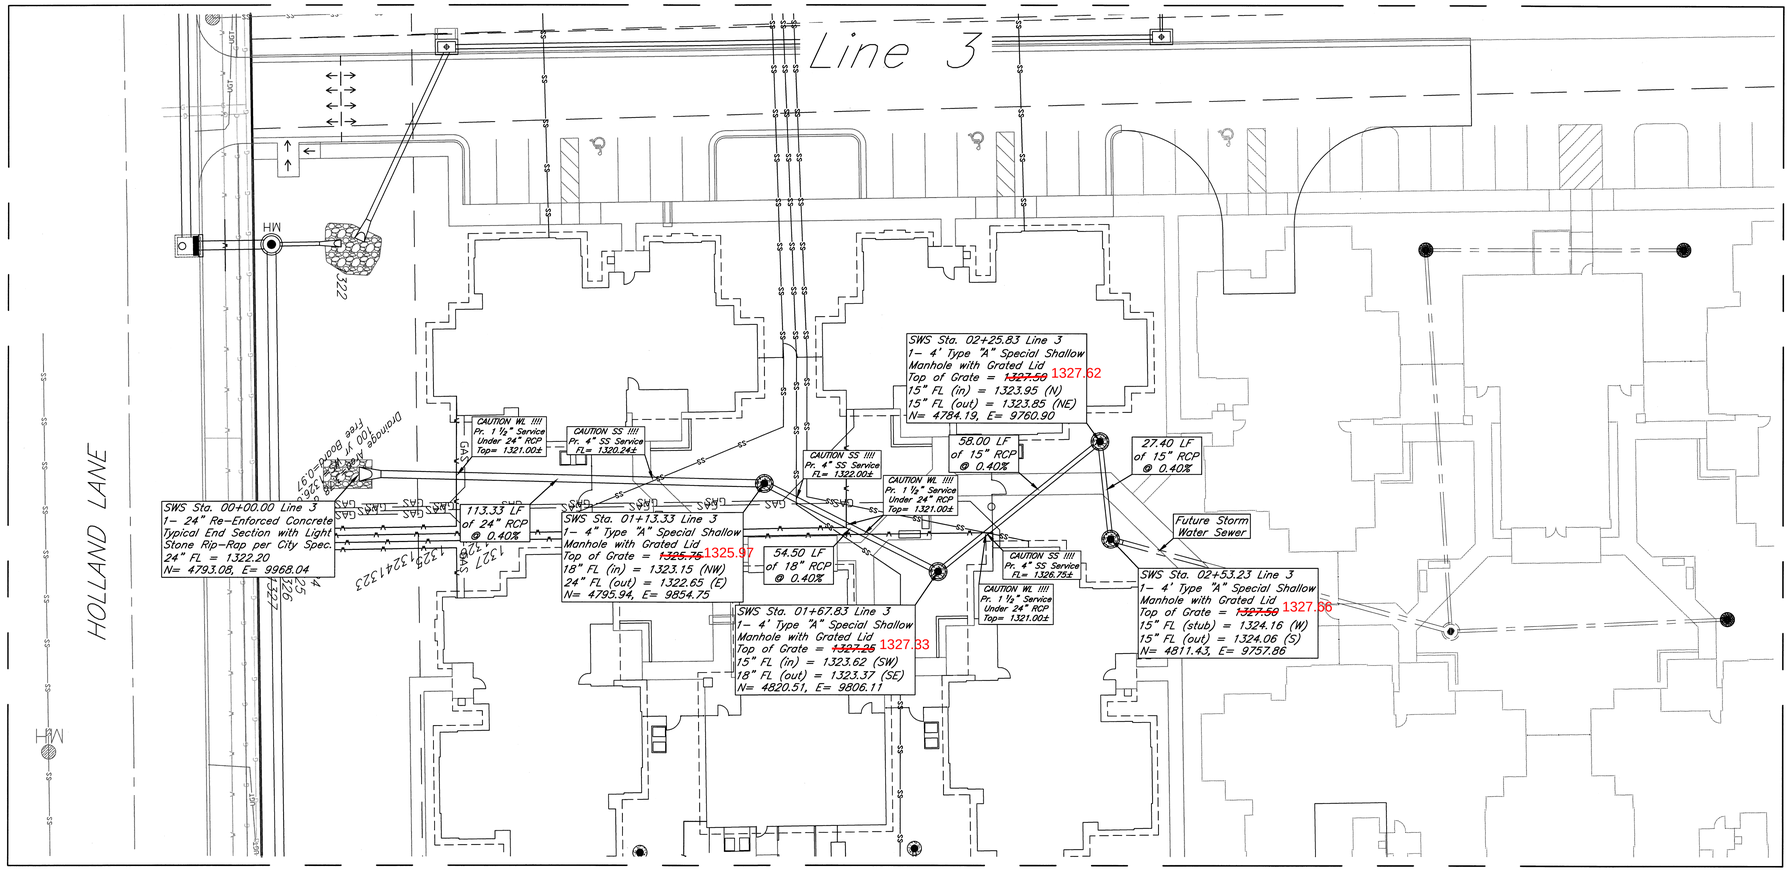

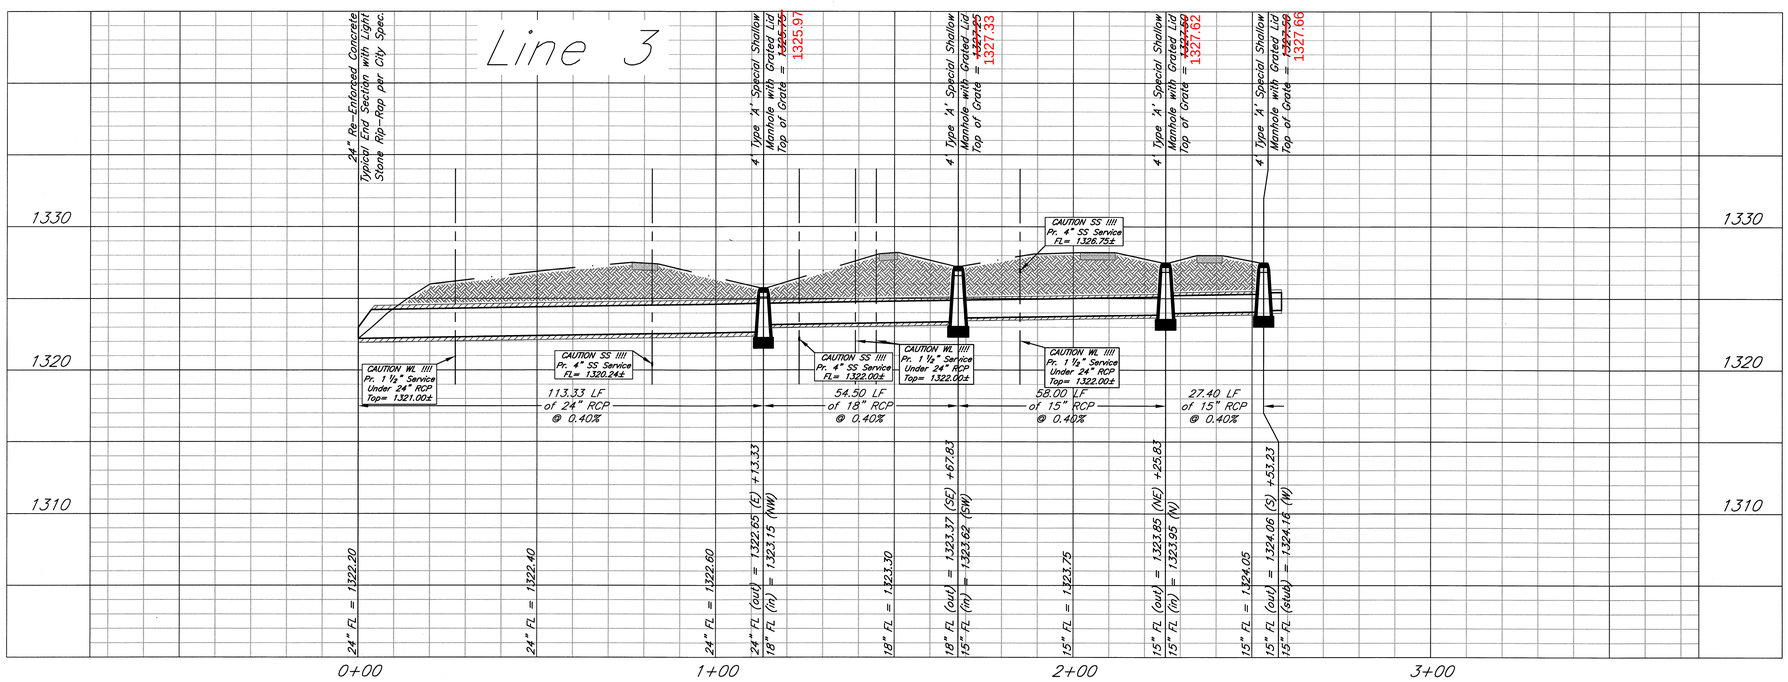

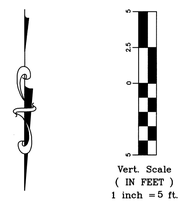

kemiller engineering
516 S. Market,
Wichita, KS 67202
(316)264–0242

DATE DRAWN
01–11–2010
REVISIONS

PRINTS ISSUED
CITY PERMIT 12–08–09

KREHBIEL ARCHITECTURE
1300 E. Lewis
Wichita KS 67211
316.267.8233
316.267.8566 fax
krehbielarchitecture.com

DATE

BETHEL HOUSE RESIDENT ACTIVITY CENTER

553 S. HOLLAND LANE
WICHITA, KANSAS

PROJECT NO.
9047

SHEET TITLE
Plan & Profile (Line 3)

SHEET NO.
C4.4

© Copyright 2009 Krehbiel Architecture