






1300 E. Lewis
Wichita KS 67211
316.267.8233
316.267.8566 fax
krehbielarchitect
ure.com

DATE

BETHEL HOUSE
RESIDENT ACTIVITY CENTER
553 S. HOLLAND LANE
WICHITA, KANSAS

PROJECT NO.
9047
SHEET TITLE
Plan & Profile (Line 4)

SHEET NO.
C4.5

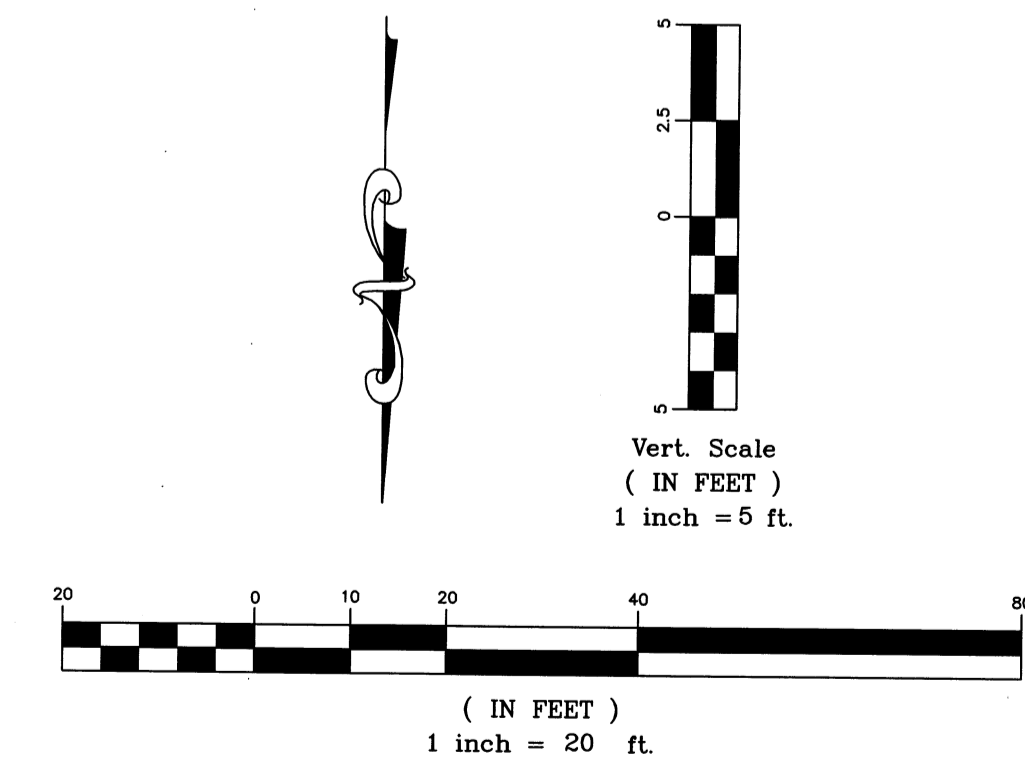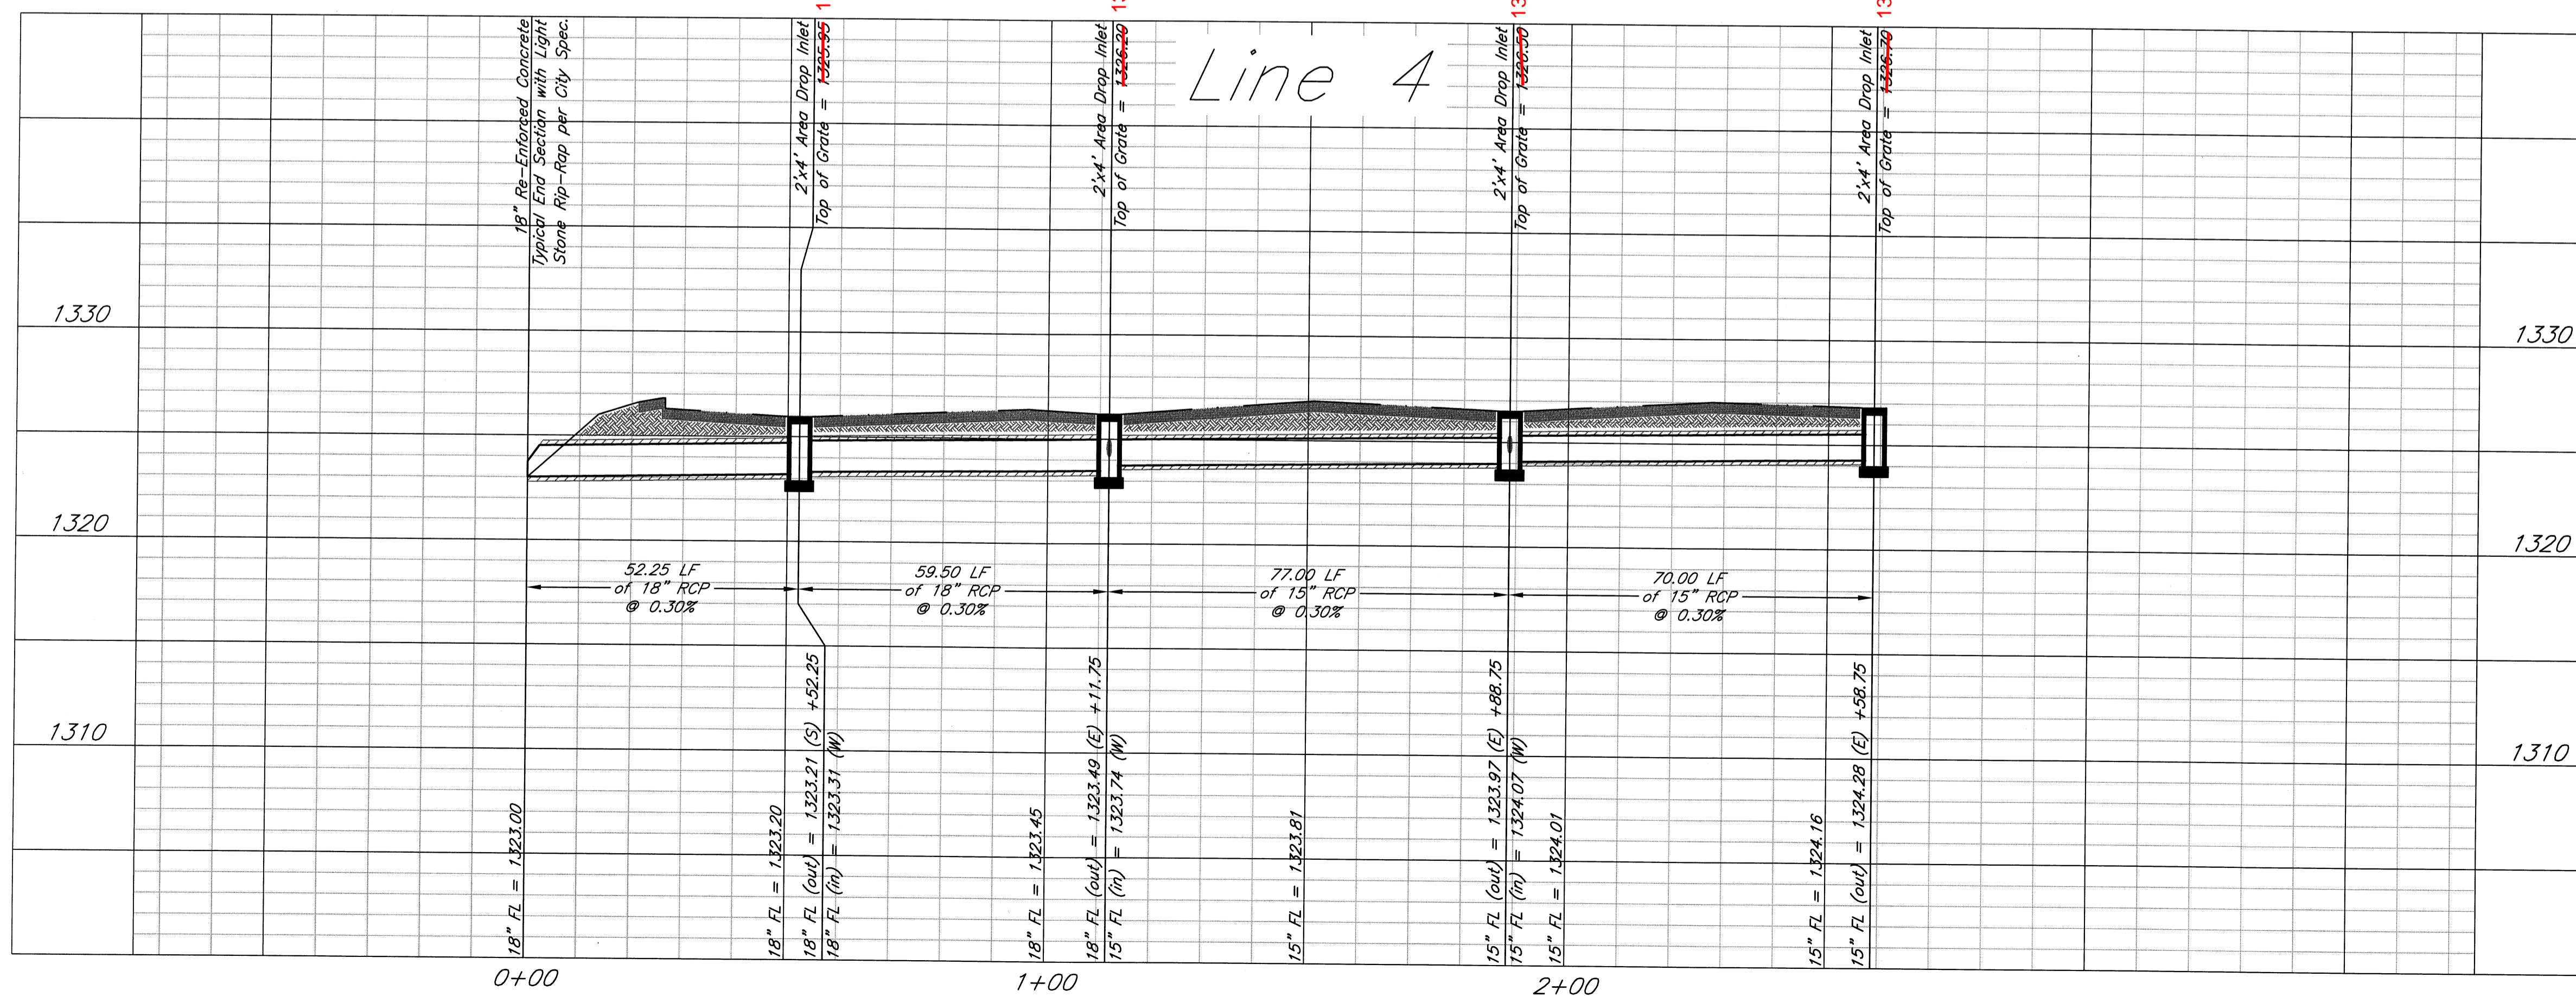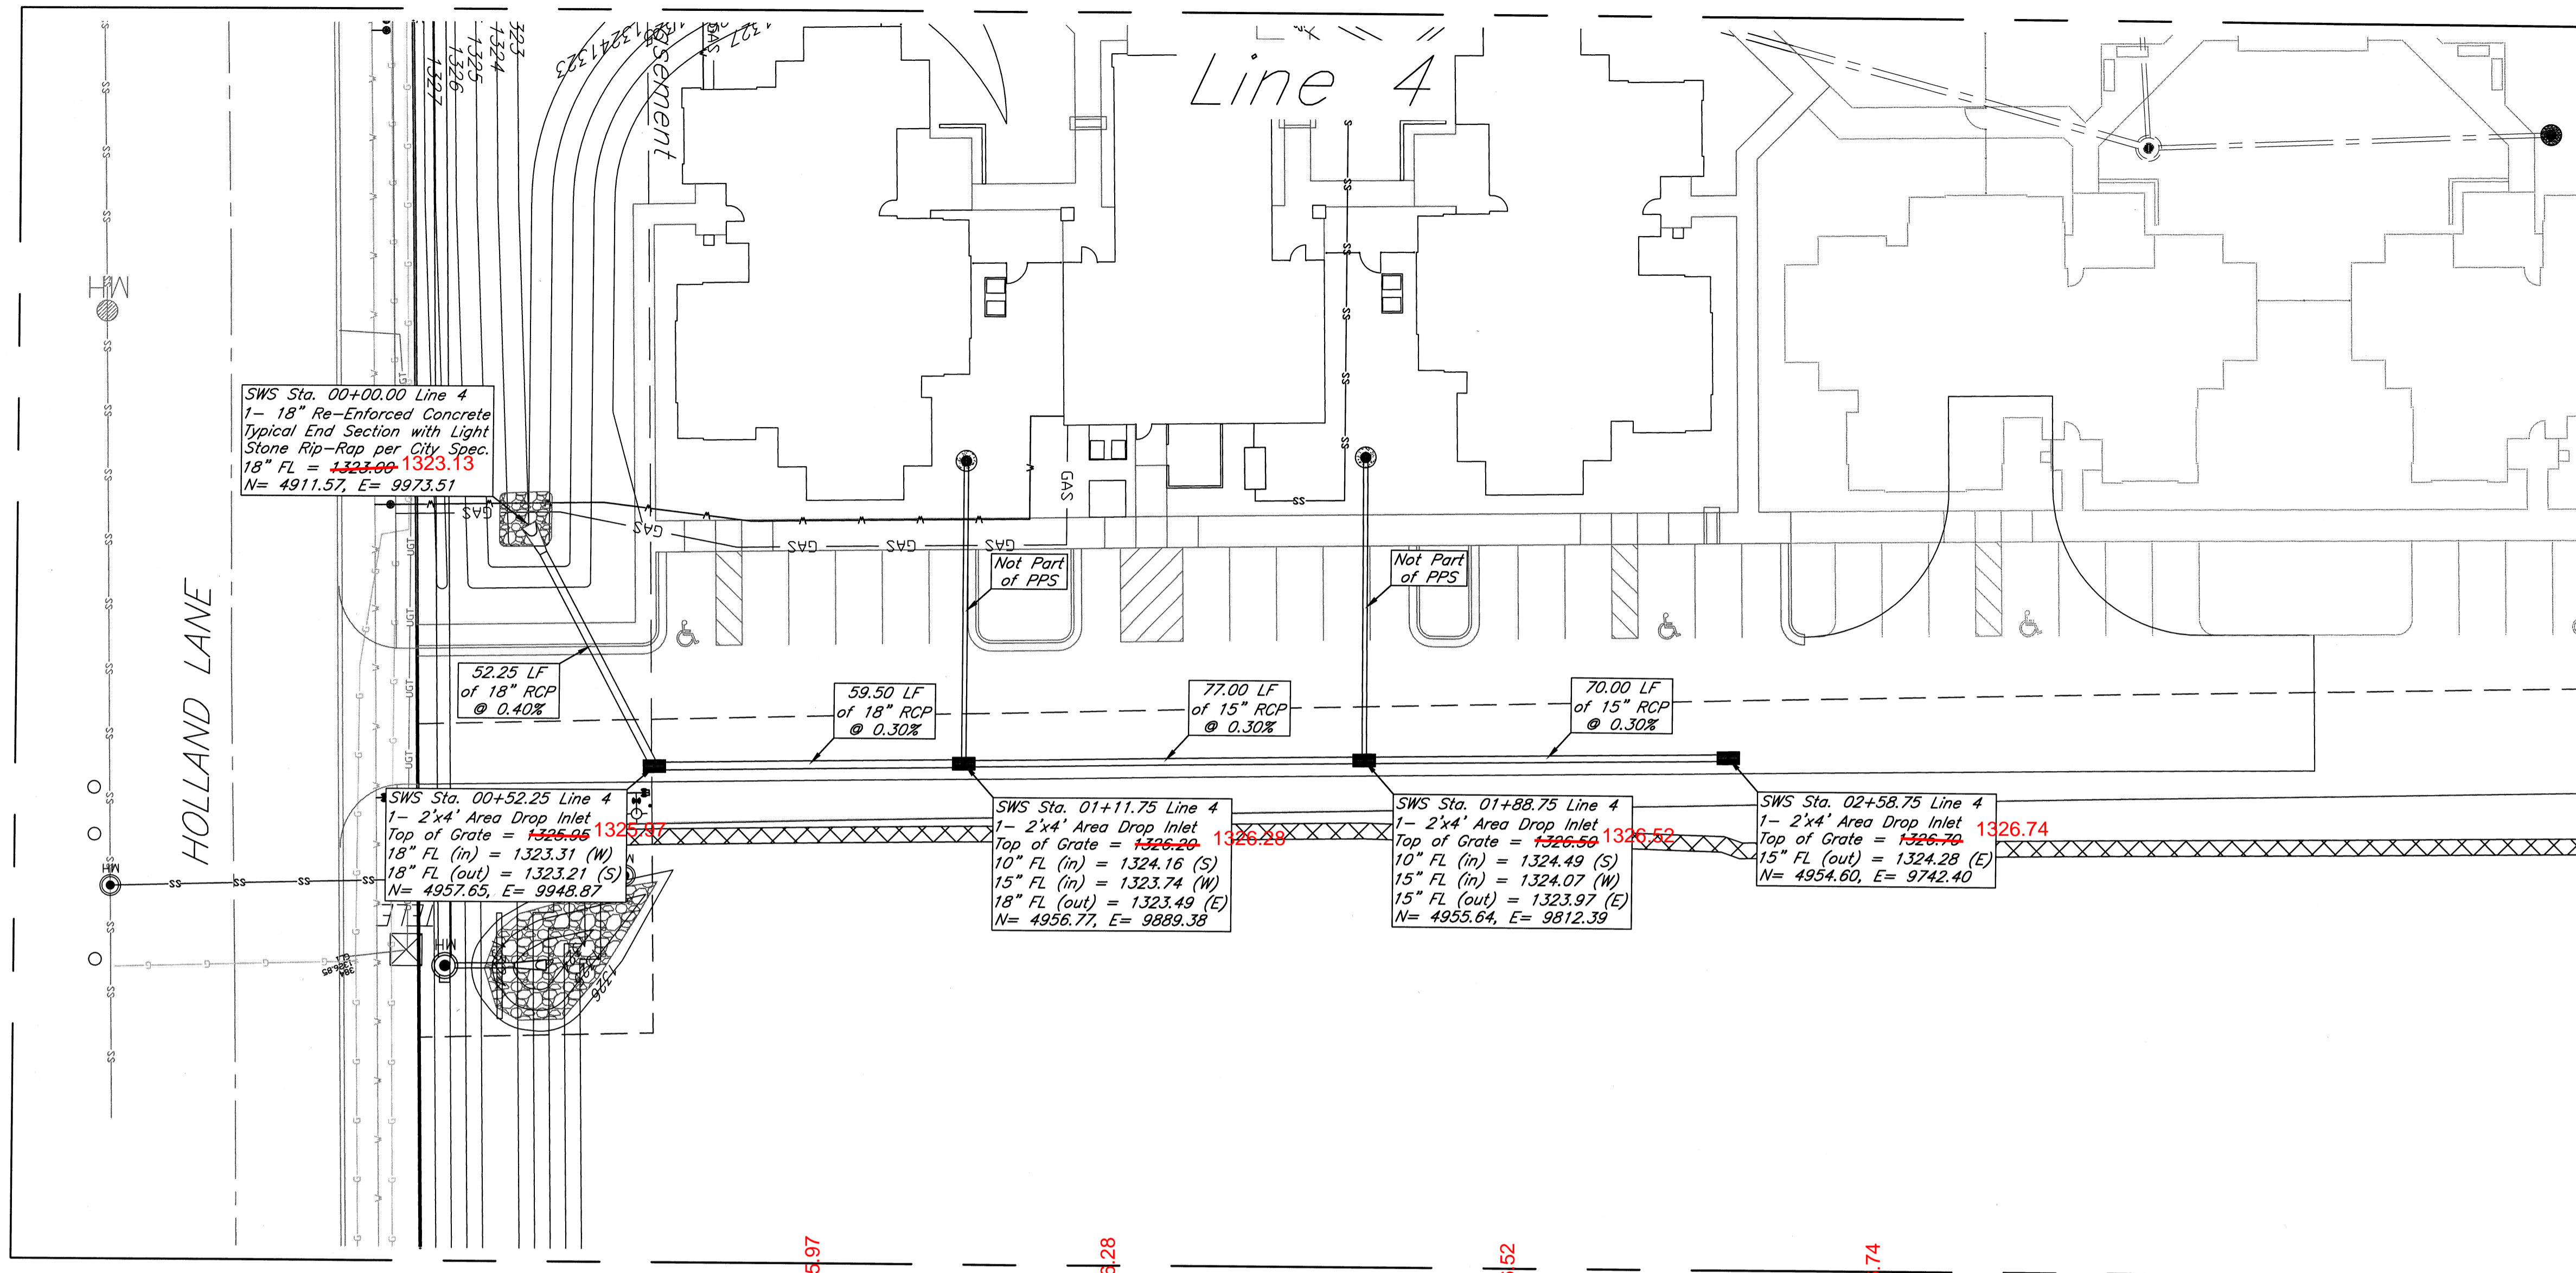

516 S. Market,
Wichita, KS 67202

(316)264-0242