

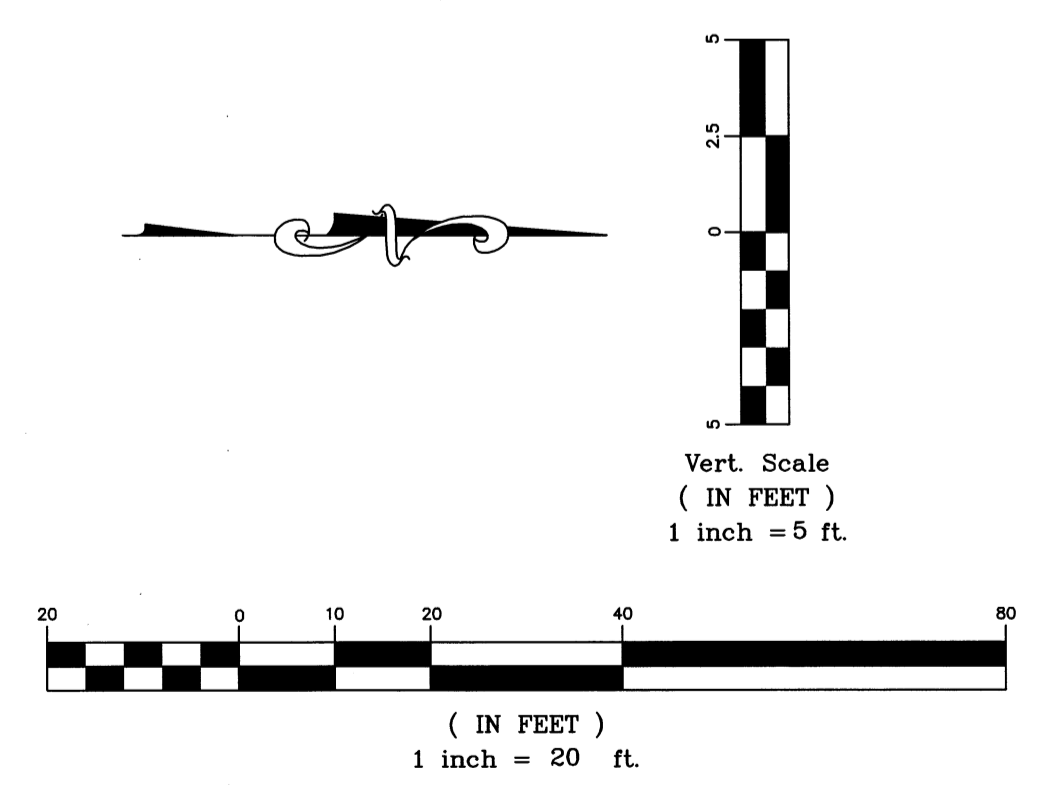


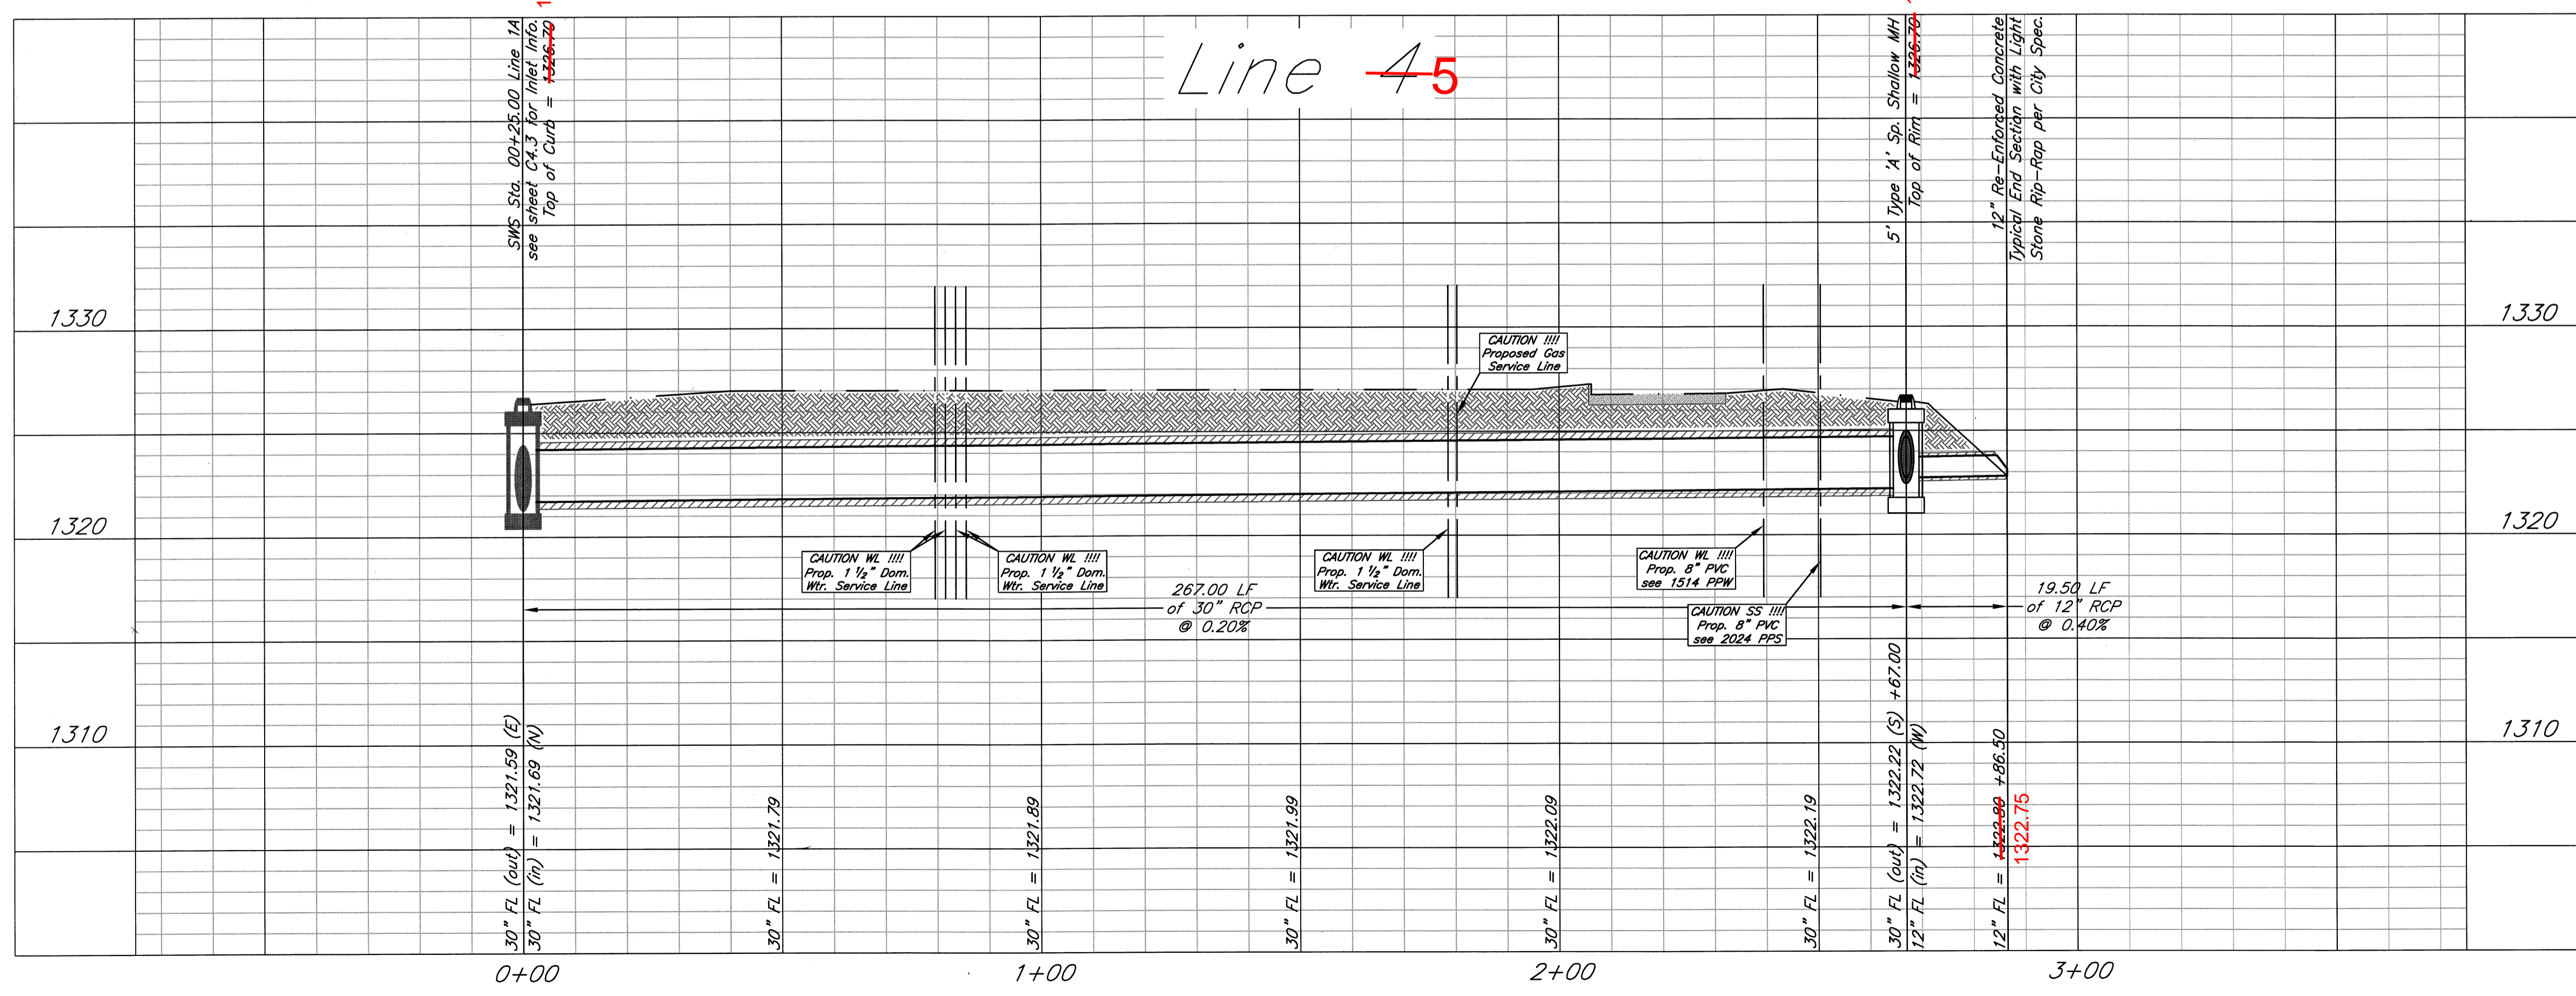

KREHBIEL
ARCHITECTURE

1300 E. Lewis
Wichita KS 67211
316.267.8233
316.267.8566 fax
krehbielarchitect
ure.com

**BETHEL HOUSE
RESIDENT ACTIVITY CENTER**
553 S. HOLLAND LANE
WICHITA, KANSAS

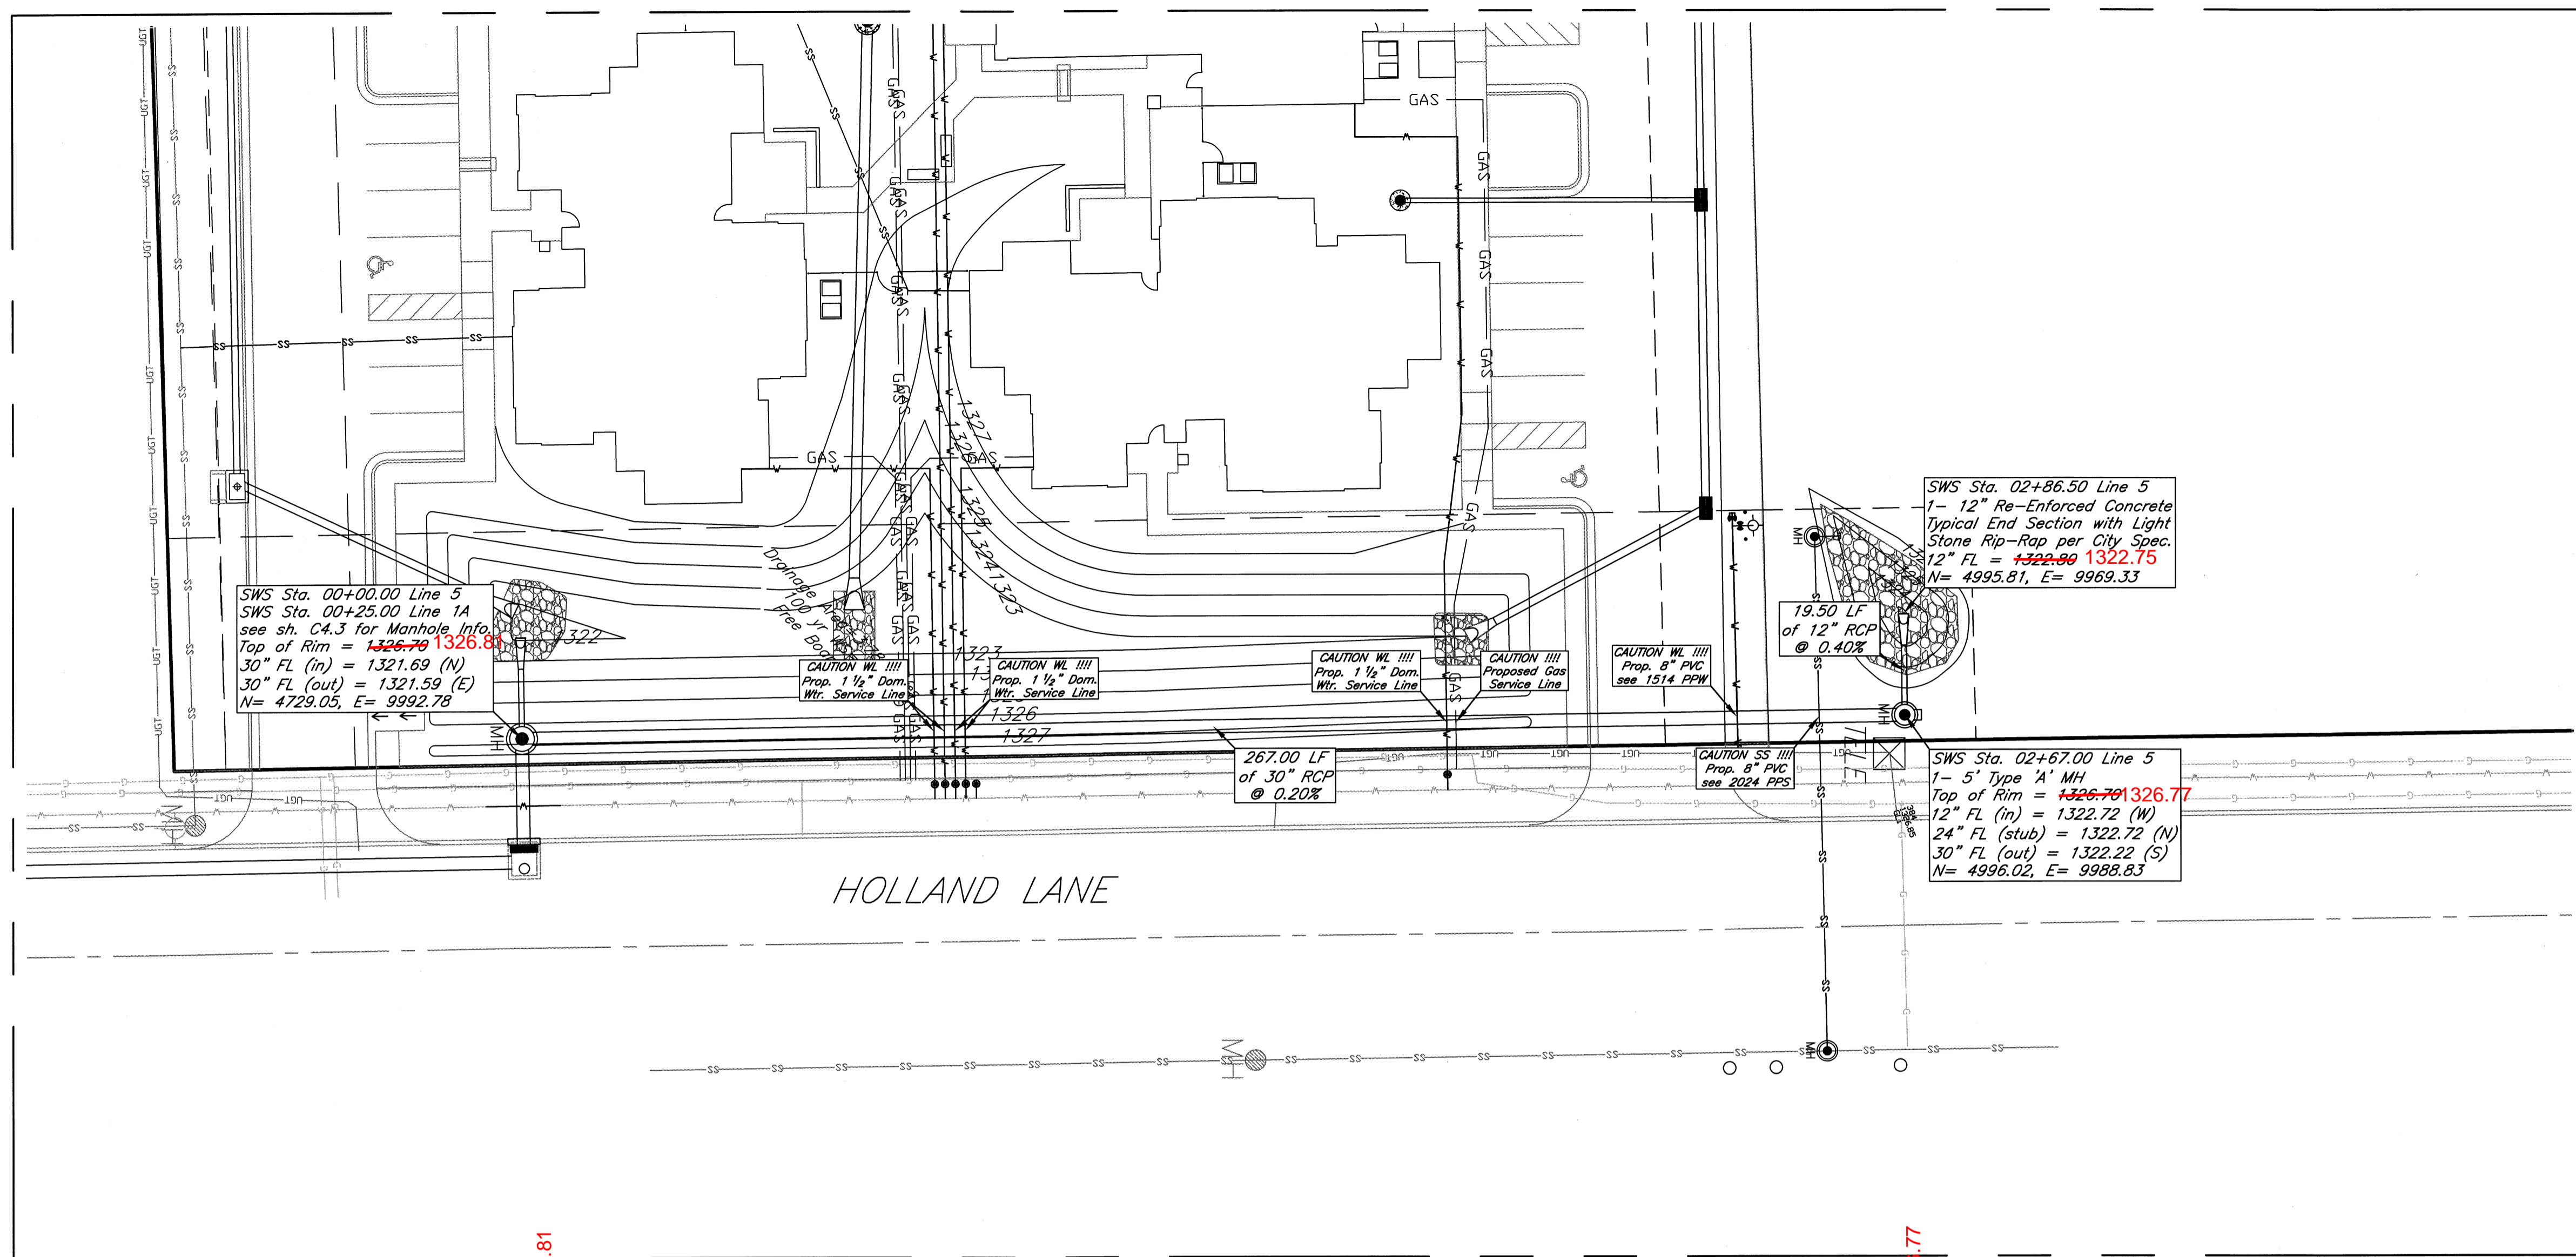

516 S. Market,
Wichita, KS 67202 (316)264-0242