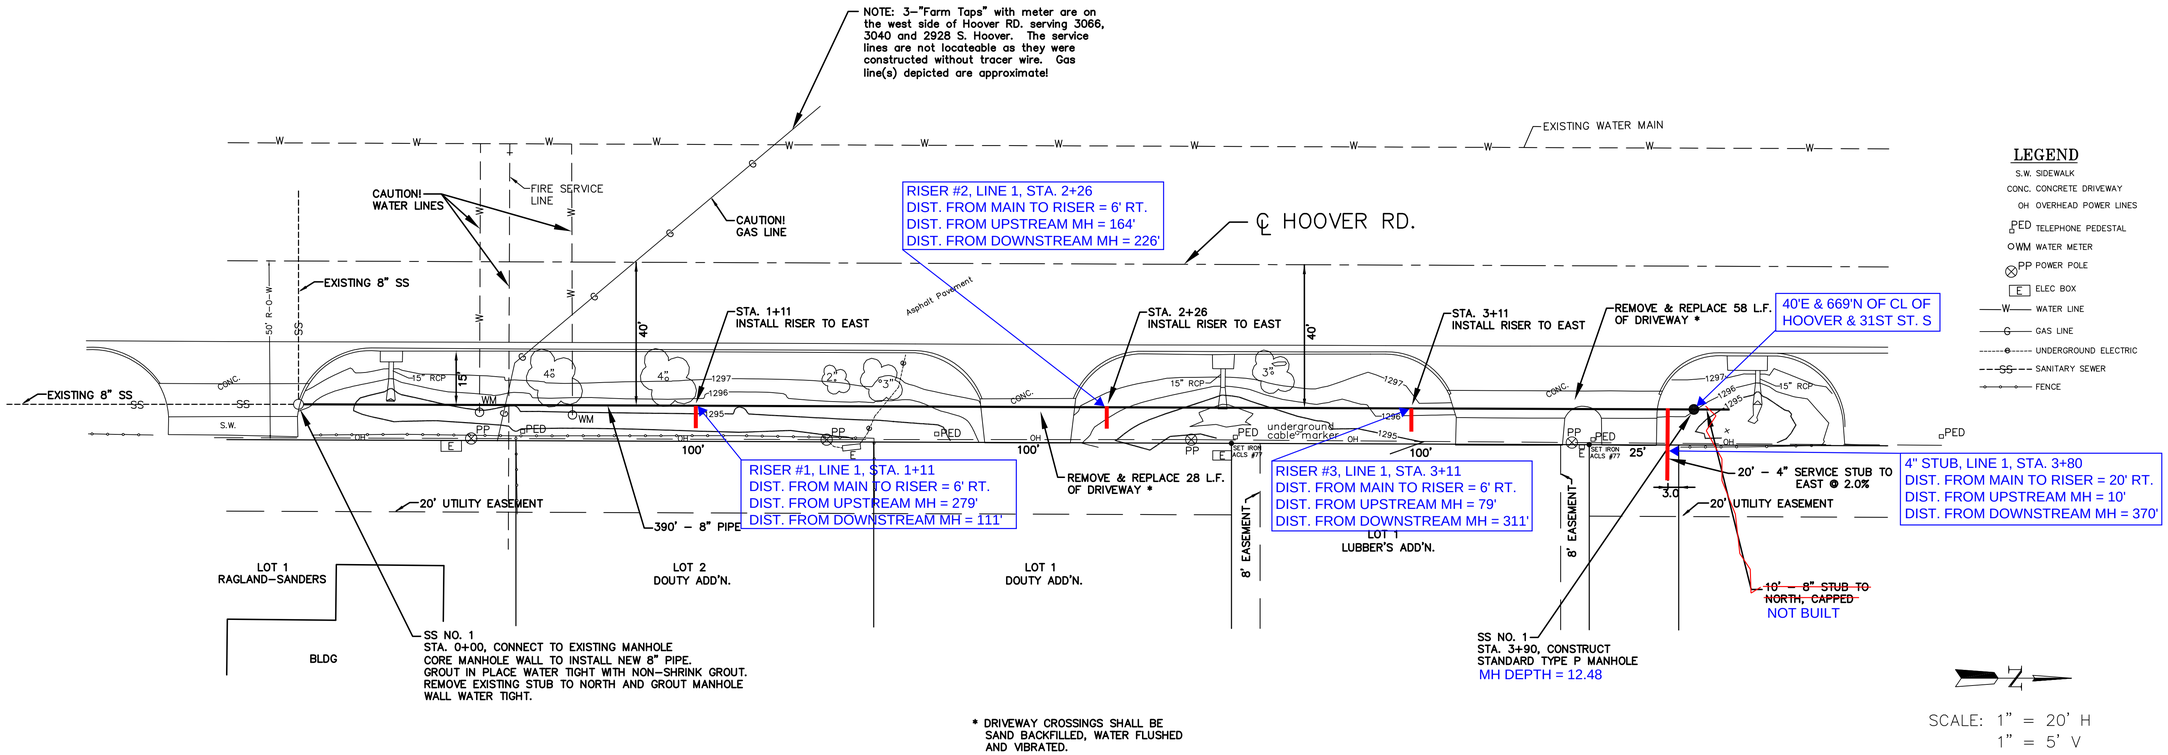

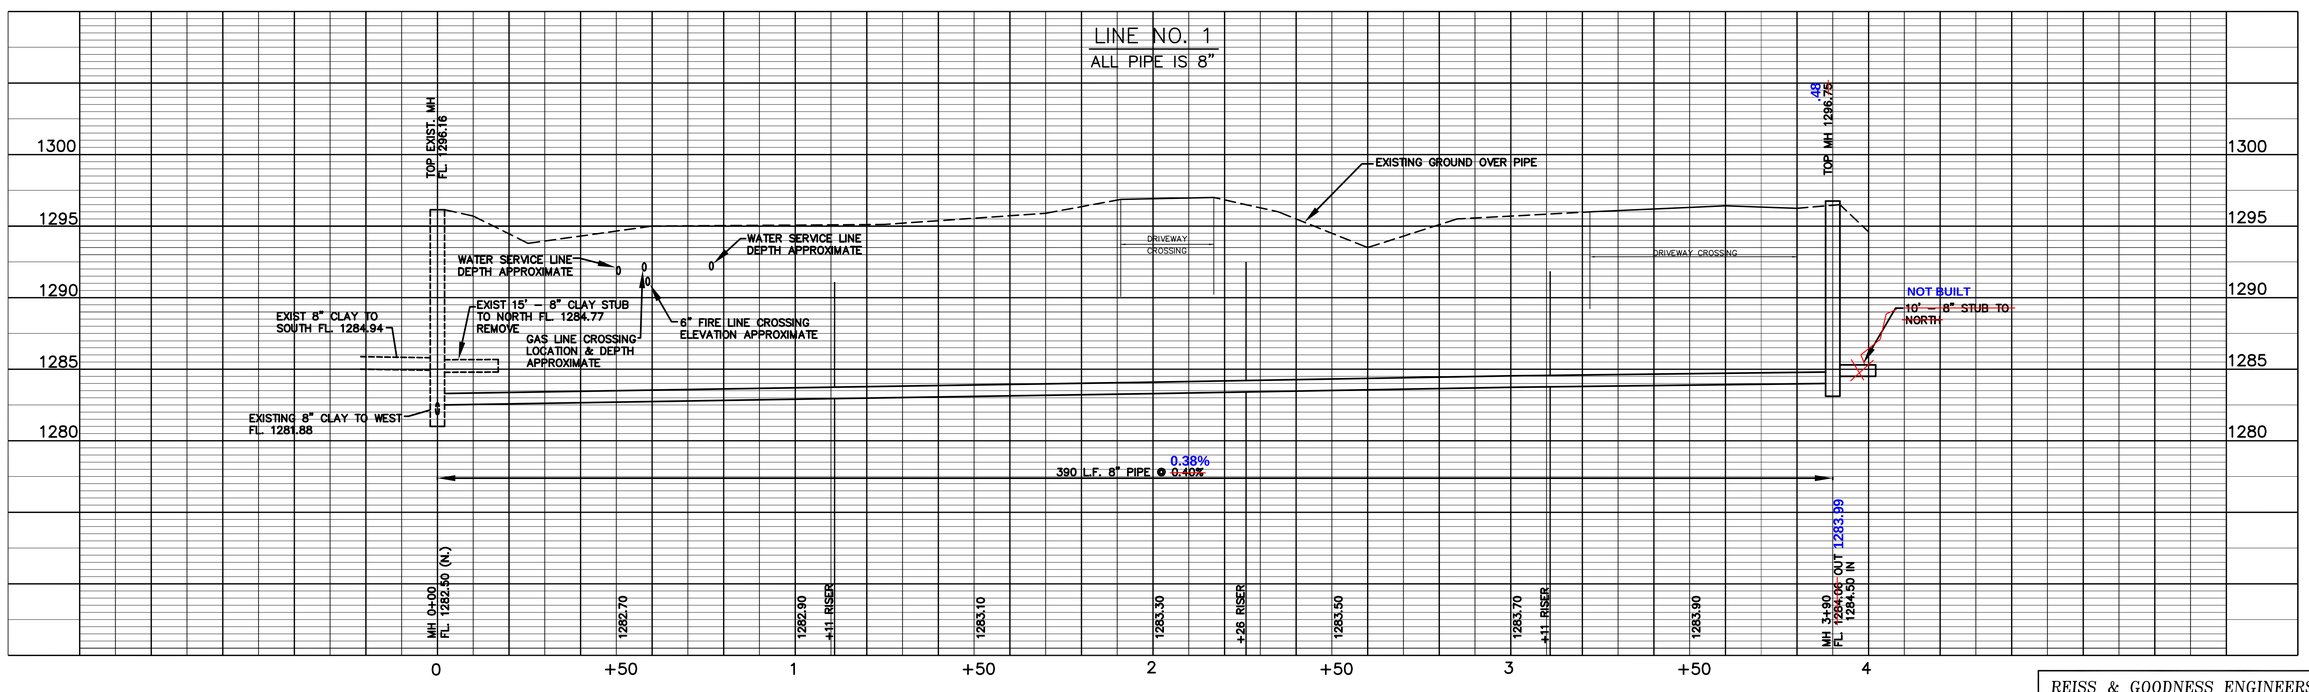

REISS & GOODNESS ENGINEERS
2160 WEST 21st STREET
WICHITA, KANSAS 67203
(316) 832-0213

STATION	DIRECTORY	DRAWN BY	FILE NAME	CHECKED BY	DESIGNED BY	PROJECT	CUSTOMER	REVISION	SCALE: NOTED	PROJECT NO. SE0207
STA #3	C:\SEWER\	DN	Wichita Lat 254	AR	RP	LATERAL 524, SOUTHWEST INTERCEPTOR SEWER	CITY OF WICHITA, KANSAS		DATE: 12-12-07	SHEET: 2 OF 10
	Wichita Lateral 254\									