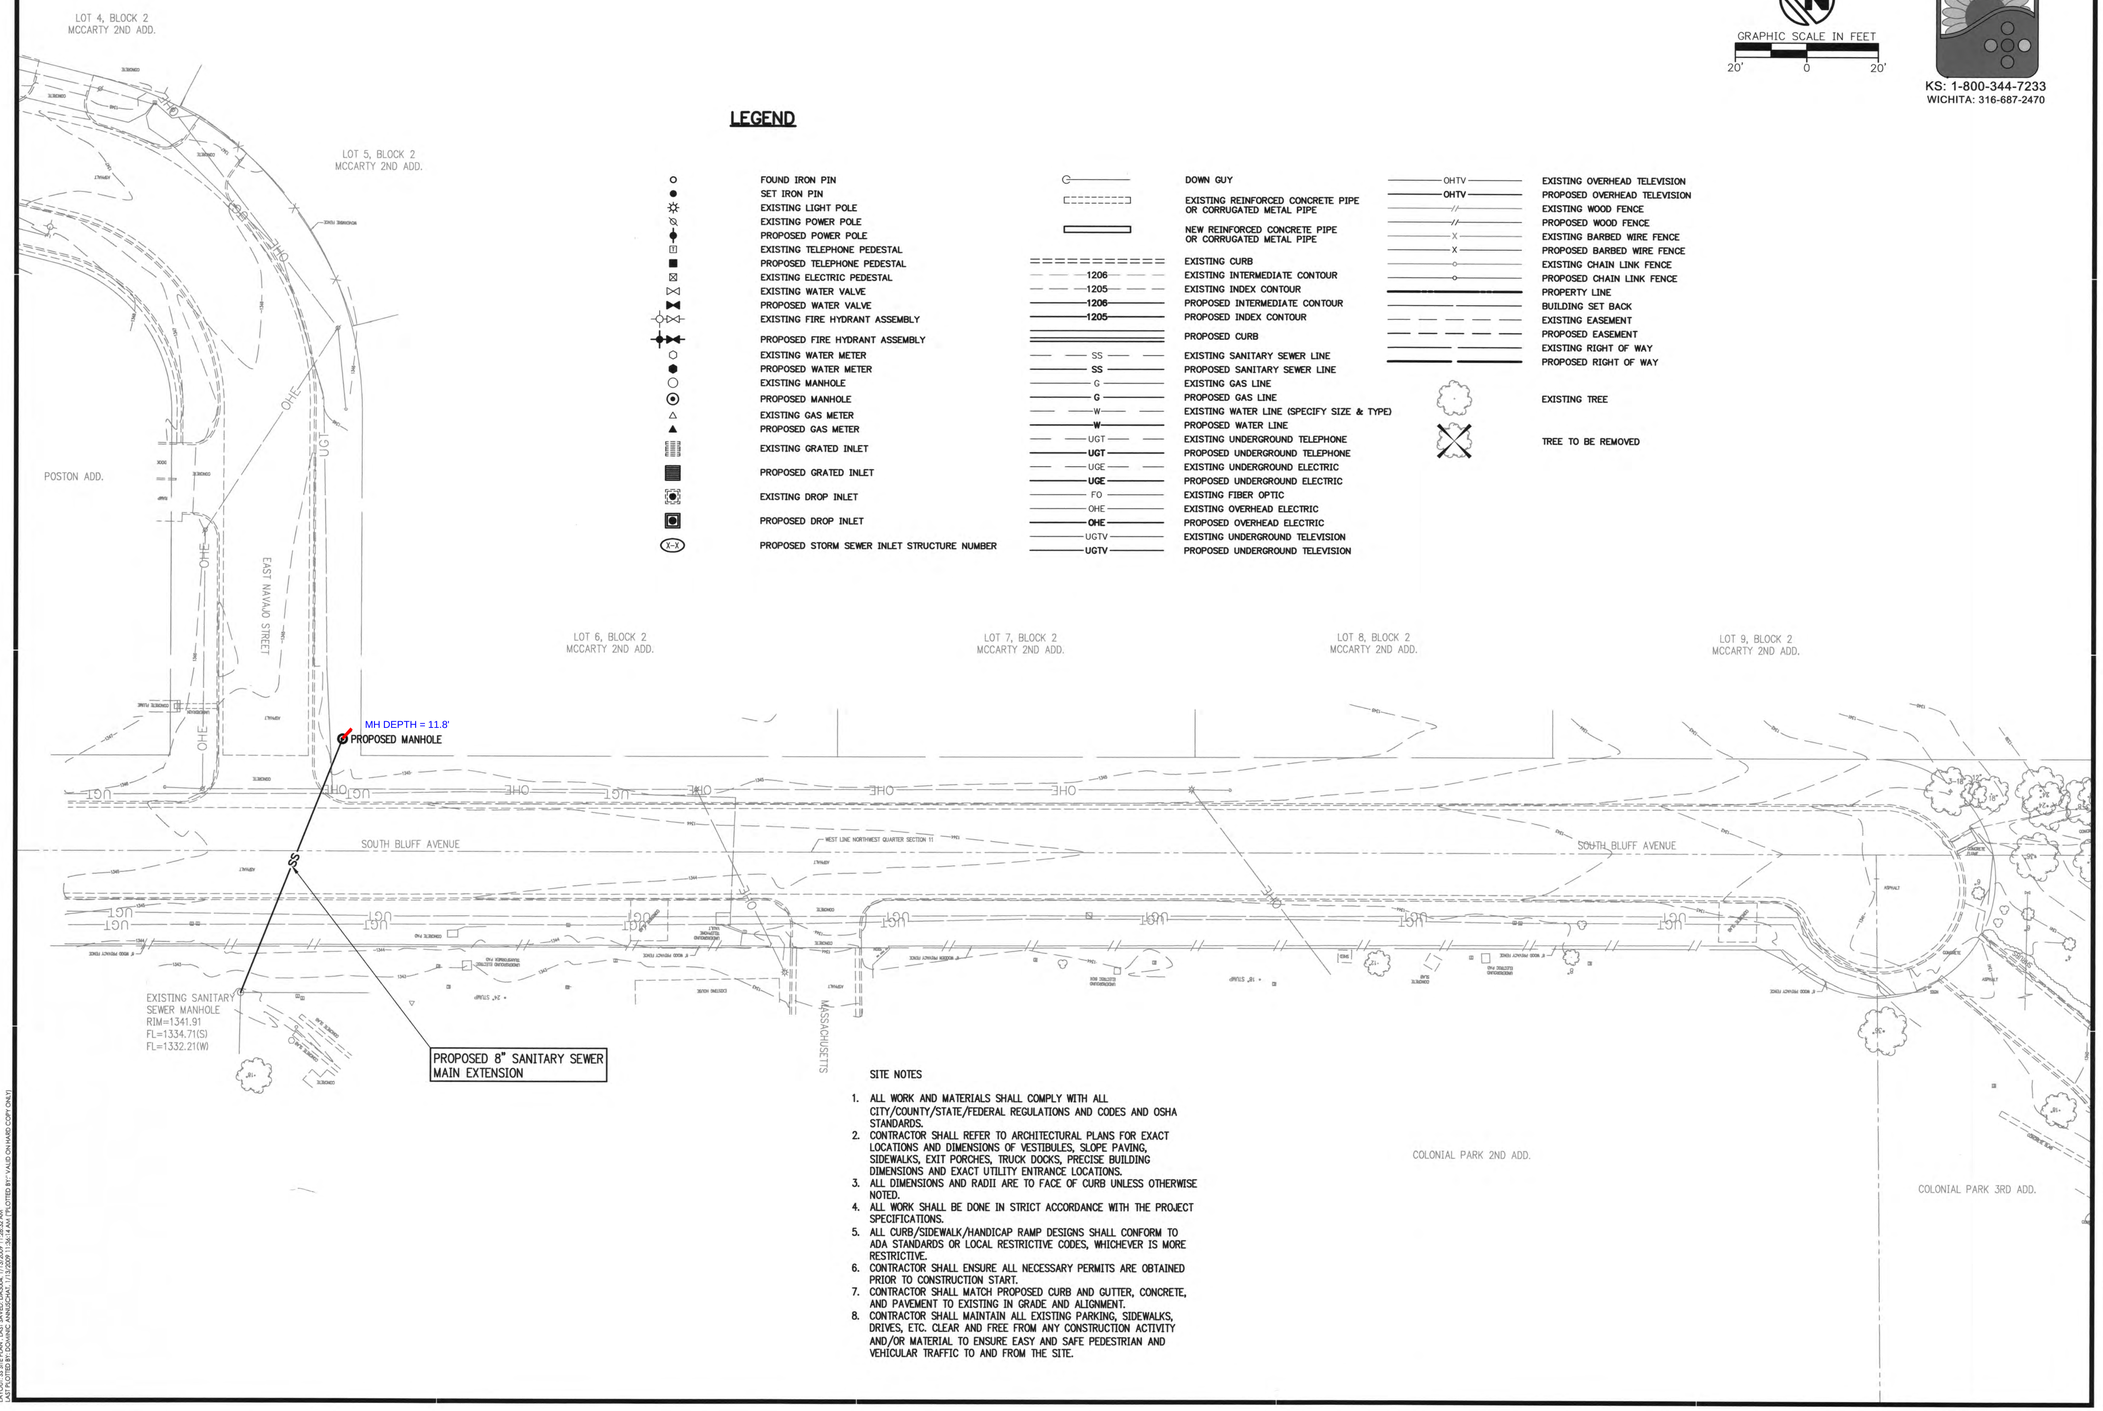

LEGEND

- FOUND IRON PIN
- SET IRON PIN
- EXISTING LIGHT POLE
- EXISTING POWER POLE
- PROPOSED POWER POLE
- EXISTING TELEPHONE PEDESTAL
- PROPOSED TELEPHONE PEDESTAL
- EXISTING ELECTRIC PEDESTAL
- EXISTING WATER VALVE
- PROPOSED WATER VALVE
- EXISTING FIRE HYDRANT ASSEMBLY
- PROPOSED FIRE HYDRANT ASSEMBLY
- EXISTING WATER METER
- PROPOSED WATER METER
- EXISTING MANHOLE
- PROPOSED MANHOLE
- EXISTING GAS METER
- PROPOSED GAS METER
- EXISTING GRATED INLET
- PROPOSED GRATED INLET
- EXISTING DROP INLET
- PROPOSED DROP INLET
- X-Y PROPOSED STORM SEWER INLET STRUCTURE NUMBER
- DOWN GUY
- EXISTING REINFORCED CONCRETE PIPE OR CORRUGATED METAL PIPE
- NEW REINFORCED CONCRETE PIPE OR CORRUGATED METAL PIPE
- EXISTING CURB
- 1206 EXISTING INTERMEDIATE CONTOUR
- 1205 EXISTING INDEX CONTOUR
- 1206 PROPOSED INTERMEDIATE CONTOUR
- 1205 PROPOSED INDEX CONTOUR
- PROPOSED CURB
- SS EXISTING SANITARY SEWER LINE
- SS PROPOSED SANITARY SEWER LINE
- G EXISTING GAS LINE
- G PROPOSED GAS LINE
- W EXISTING WATER LINE (SPECIFY SIZE & TYPE)
- W PROPOSED WATER LINE
- UGT EXISTING UNDERGROUND TELEPHONE
- UGT PROPOSED UNDERGROUND TELEPHONE
- UGE EXISTING UNDERGROUND ELECTRIC
- UGE PROPOSED UNDERGROUND ELECTRIC
- FO EXISTING FIBER OPTIC
- OHE EXISTING OVERHEAD ELECTRIC
- OHE PROPOSED OVERHEAD ELECTRIC
- UGTV EXISTING UNDERGROUND TELEVISION
- UGTV PROPOSED UNDERGROUND TELEVISION
- OHTV EXISTING OVERHEAD TELEVISION
- OHTV PROPOSED OVERHEAD TELEVISION
- EXISTING WOOD FENCE
- PROPOSED WOOD FENCE
- EXISTING BARBED WIRE FENCE
- PROPOSED BARBED WIRE FENCE
- EXISTING CHAIN LINK FENCE
- PROPOSED CHAIN LINK FENCE
- PROPERTY LINE
- BUILDING SET BACK
- EXISTING EASEMENT
- PROPOSED EASEMENT
- EXISTING RIGHT OF WAY
- PROPOSED RIGHT OF WAY
- EXISTING TREE
- TREE TO BE REMOVED

GRAPHIC SCALE IN FEET
20' 0 20'

ONE CALL KANSAS
KS: 1-800-344-7233
WICHITA: 316-687-2470

SITE NOTES

1. ALL WORK AND MATERIALS SHALL COMPLY WITH ALL CITY/COUNTY/STATE/FEDERAL REGULATIONS AND CODES AND OSHA STANDARDS.
2. CONTRACTOR SHALL REFER TO ARCHITECTURAL PLANS FOR EXACT LOCATIONS AND DIMENSIONS OF VESTIBULES, SLOPE PAVING, SIDEWALKS, EXIT PORCHES, TRUCK DOCKS, PRECISE BUILDING DIMENSIONS AND EXACT UTILITY ENTRANCE LOCATIONS.
3. ALL DIMENSIONS AND RADII ARE TO FACE OF CURB UNLESS OTHERWISE NOTED.
4. ALL WORK SHALL BE DONE IN STRICT ACCORDANCE WITH THE PROJECT SPECIFICATIONS.
5. ALL CURB/SIDEWALK/HANDICAP RAMP DESIGNS SHALL CONFORM TO ADA STANDARDS OR LOCAL RESTRICTIVE CODES, WHICHEVER IS MORE RESTRICTIVE.
6. CONTRACTOR SHALL ENSURE ALL NECESSARY PERMITS ARE OBTAINED PRIOR TO CONSTRUCTION START.
7. CONTRACTOR SHALL MATCH PROPOSED CURB AND GUTTER, CONCRETE, AND PAVEMENT TO EXISTING IN GRADE AND ALIGNMENT.
8. CONTRACTOR SHALL MAINTAIN ALL EXISTING PARKING, SIDEWALKS, DRIVES, ETC. CLEAR AND FREE FROM ANY CONSTRUCTION ACTIVITY AND/OR MATERIAL TO ENSURE EASY AND SAFE PEDESTRIAN AND VEHICULAR TRAFFIC TO AND FROM THE SITE.

DRAWING C:\083012-00\ENG\ENG\SITE.DWG
LAYOUT: SITE PLAN LAST SAVED: CASONA, 1/13/2009 11:28:32 AM
PLOTTED BY: CASONA, MARCUS 1/13/2009 11:28:44 AM PLOTTED BY: VALID NAMED COPY ONLY

8200 E. 34th St. N., Bldg. #1600, Suite #1603
Wichita, Kansas 67226
Crafton Tull Sparks
architecture | engineering
316.634.6776 t 316.634.6777 f
www.craftontullsparks.com

CERTIFICATE OF AUTHORIZATION:
CA E-341 EXPIRES 12/31/2009

CITY OF WICHITA
SANITARY SEWER

NAVAJO & BLUFF, 31ST S
Wichita, KS

Key Plan

No.	Description	Date

This document, and the ideas and designs incorporated herein, as an instrument of professional service, is the property of Crafton, Tull, Sparks & Associates, Inc., and is not to be used, in whole or in part, for any other project, without the written authorization of Crafton, Tull, Sparks & Associates, Inc.

PROJECT NO: 083012-00
ISSUE DATE: 01/13/09
CONTACT: J. MOHLER
CHECKED BY: JCM

ISSUED FOR CONSTRUCTION

© 2009 Crafton, Tull, Sparks & Associates, Inc.

JASON C. MOHLER
LICENSED
18722
KANSAS
PROFESSIONAL ENGINEER
1/13/09

SITE PLAN

03